

ADDENDUM NUMBER ONE

Project #25-S-0008

HVAC Maintenance Services
Eugene, Oregon

March 13, 2025

QUESTIONS ON CHEMICALS,
CONTROL SYSTEM, AND
MECHANICAL DRAWINGS AND
SCHEDULE

GENERAL:

1. **Note:** Use enclosed Addenda Receipt, or similar Addenda Receipt, to acknowledge receipt of this Addendum when submitting your Quote.

REFER TO: Request for Quotes:

2. **Addition: Scope of Work.** Boiler, boiler pot, and all chemicals for HVAC maintenance to be included in scope of work.
3. **Addition:** Remove Controls System from Scope of Work
4. **Addition:** Add hourly fee in case of out of scope work.
5. **Addition:** Site Mechanical Drawings and Schedule - *Refer to Exhibit A*

GENERAL

GENERAL NOTE: All implied, inferred, or direct verbal responses from Contract Administrator or agents of owner (stated at Pre-Quote walk through, by phone, email, etc...) are not valid or binding unless noted in writing in this addendum.

Addendum Number One issued March 13, 2025, and authorized by: Dawn Green, Contract Administrator

Dawn Green

Dawn Green
Contract Administrator

Addendum Receipt

For Project Number: **25-S-0008**

Titled: **HVAC Maintenance Services**

Addendum Numbered: **ONE**

Dated: **March 13, 2025**

with Pages numbered: **1-2**

By my signature below I acknowledge:

- Receipt of the noted Addendum,
- That it has been fully reviewed, and
- That all terms included therein are incorporated into the Quote.

Signature: _____

Title: _____


Date: _____

COMPLETE THIS FORM AND SUBMIT WITH QUOTE DOCUMENTS

All bidders must complete and sign this form, or similar Addendum Receipt form, for each Addendum issued. The form is to be submitted with the quote documents. A bid may be considered non-responsive if a completed Addendum Receipt is not submitted with the quote, for each Addendum issued.

ELECTRICAL LEGEND


LOW-VOLTAGE ELECTRICAL CONDUCTORS & CABLES

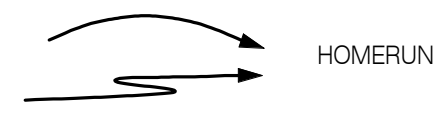

GROUNDING & BONDING FOR ELECTRICAL SYSTEMS




RACEWAYS & BOXES FOR ELECTRICAL SYSTEMS

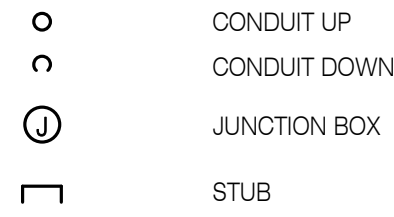


CABLE TRAY FOR ELECTRICAL SYSTEMS




LIGHTING CONTROL EQUIPMENT

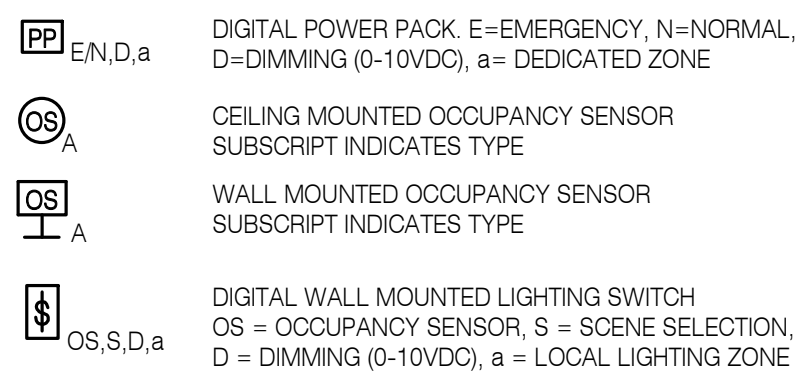


LOW-VOLTAGE DISTRIBUTION

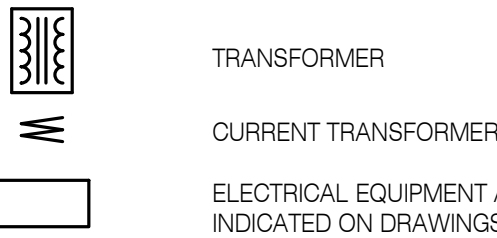


PANELBOARDS

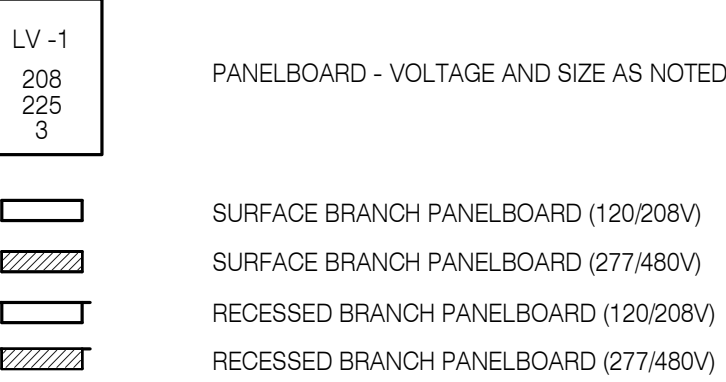


ELECTRICAL CABINETS & ENCLOSURES

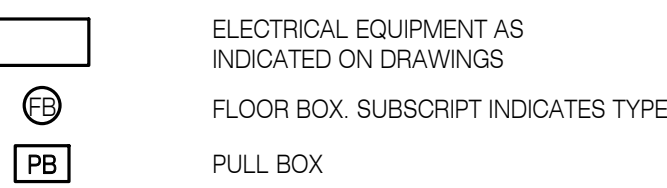


WIRING DEVICES

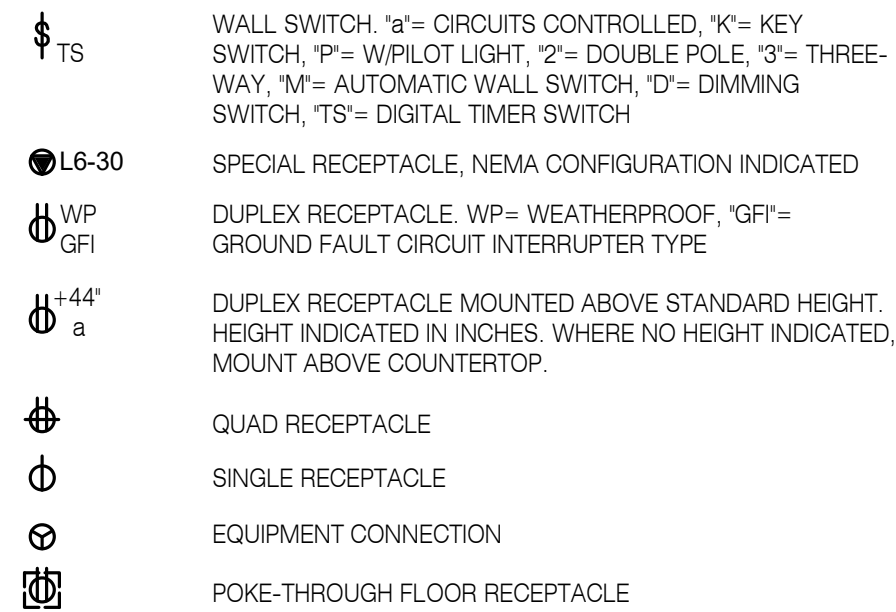

OVER-CURRENT PROTECTIVE DEVICES

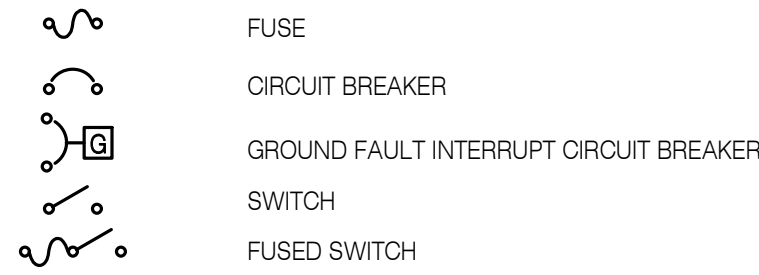

MOTOR & CIRCUIT DISCONNECTS

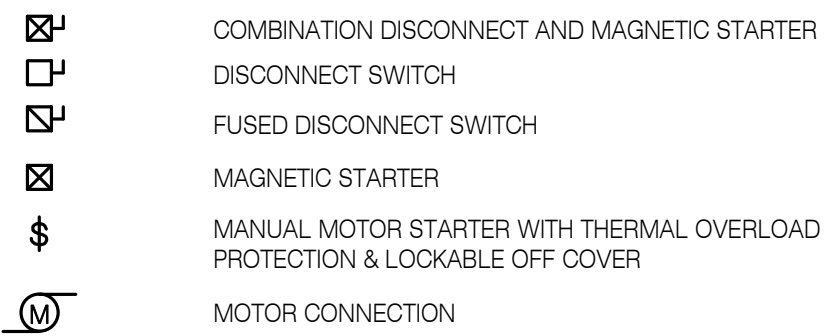


VARIABLE FREQUENCY MOTOR CONTROLLER




ELECTRICITY METERING



STANDBY GENERATION SYSTEM

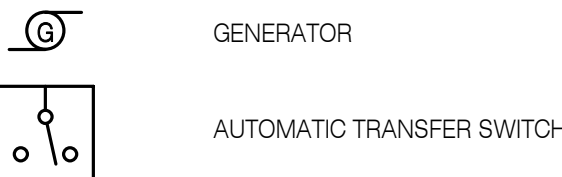


LIGHTING FIXTURES

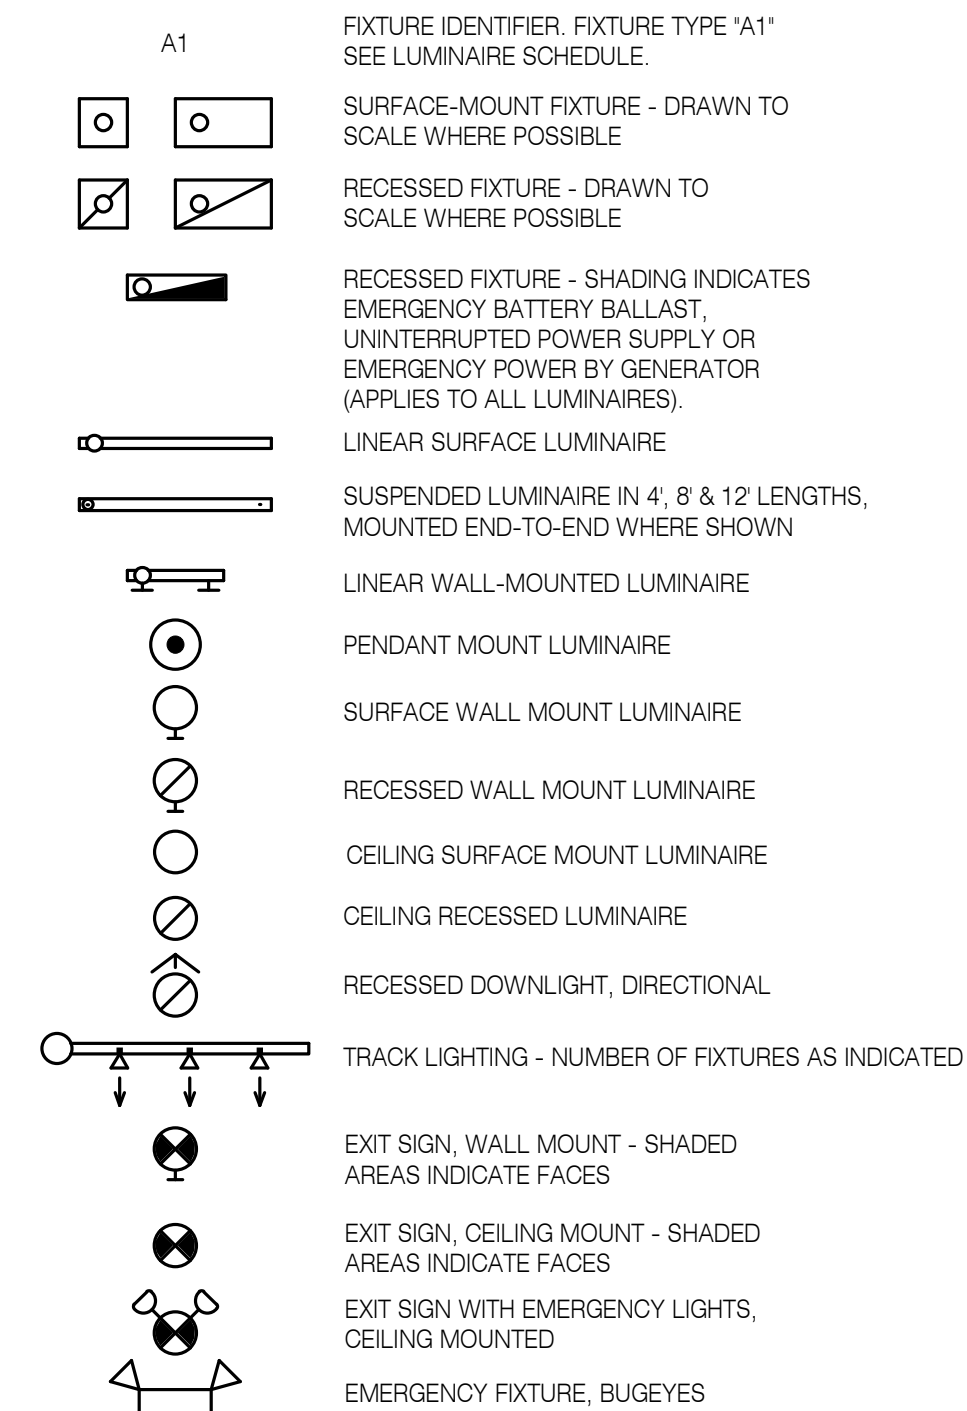


AUDIO/VISUAL DEVICES




DATA COMMUNICATIONS

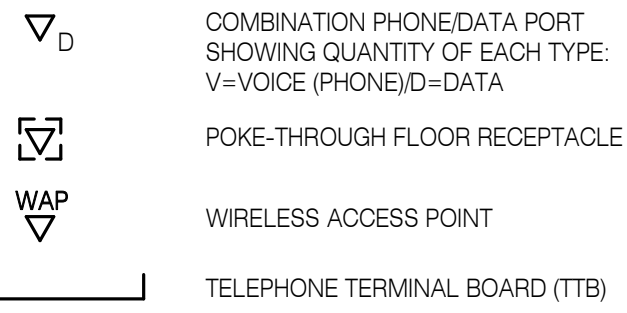


ACCESS CONTROL

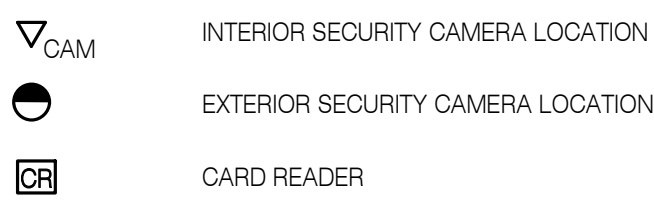

FIRE DETECTION & ALARM

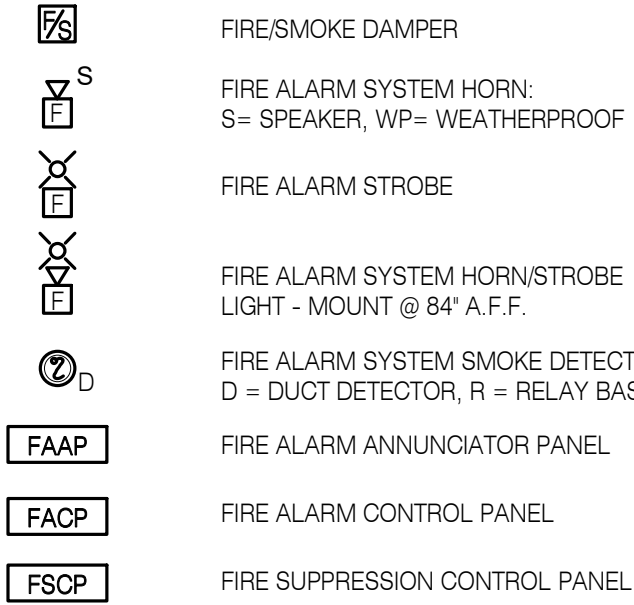

GENERAL

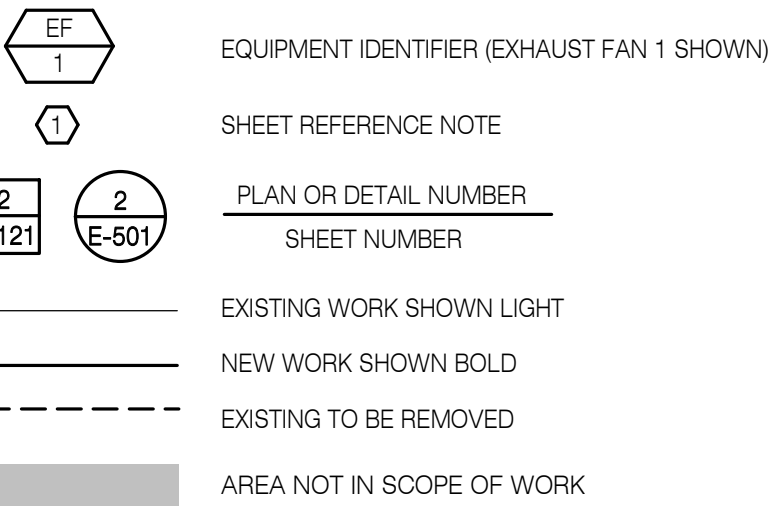

SHEET INDEX - ELECTRICAL

E001	LEGEND, GENERAL NOTES, & ELECTRICAL SHEET INDEX
E100	SITE PLAN
E101	ELECTRICAL DEMOLITION - LOWER LEVEL
E102	ELECTRICAL DEMOLITION - FIRST FLOOR
E103	ELECTRICAL DEMOLITION - SECOND FLOOR
E104	ELECTRICAL DEMOLITION - SECOND FLOOR ROOF
E111	LIGHTING PLAN - LOWER LEVEL
E112	LIGHTING PLAN - FIRST FLOOR
E113	LIGHTING PLAN - SECOND FLOOR
E121	POWER PLAN - LOWER LEVEL
E122	POWER PLAN - FIRST FLOOR
E123	POWER PLAN - SECOND FLOOR
E124	POWER PLAN - SECOND FLOOR ROOF
E131	LOW VOLTAGE PLAN - LOWER LEVEL
E132	LOW VOLTAGE PLAN - FIRST FLOOR
E133	LOW VOLTAGE PLAN - SECOND FLOOR
E501	LIGHTING DETAILS
E511	POWER DISTRIBUTION DETAILS
E521	LOW VOLTAGE DETAILS
E601	LUMINAIRE SCHEDULE
E602	SCHEDULES
E603	SCHEDULES
E604	SCHEDULES
E605	SCHEDULES
E611	ONE-LINE DIAGRAMS



ELECTRICAL LOAD SUMMARY		
HOMES FOR GOOD		
EXISTING PEAK 12 MONTH DEMAND:		
HIGH DEMAND @ CODE 125%	102	KVA
REMOVED LOAD, THIS PHASE:	127.5	KVA
	80.0	KVA
CALCULATED LOAD (208/120)		
LIGHTING	10.1	KVA
OUTLETS	72.4	KVA
MOTOR LOADS	34.5	KVA
RESISTIVE LOADS	0.0	KVA
MISC. LOADS	16.7	KVA
ADDITIONAL MECHANICAL (AHU-1&2)	115.2	KVA
	Total	249.0 KVA
TOTAL CONNECTED LOAD	296.5	KVA
SYSTEM ANTICIPATED AMPERES @ SERVICE VOLTAGE 208/120 3 PH	823	AMPS

ABBREVIATIONS

AFF	ABOVE FINISHED FLOOR	IDF	INTERMEDIATE DISTRIBUTION FRAME
BLDG	BUILDING	LV	LOW VOLTAGE
C	CONDUIT	MDF	MAIN DISTRIBUTION FRAME
cd	CANDELA	MECH	MECHANICAL
CKT	CIRCUIT	MW	MICROWAVE
DIM	0-10V DIMMING	(N)	NEW
DSP	DIGITAL SIGNAL PROCESSOR	(NL)	NEW LOCATION
(E)	EXISTING	PNL	PANEL
ELEC	ELECTRICAL	(RL)	RELOCATE
EMERG	EMERGENCY	(RP)	REPLACE EXISTING
FAM	FIRE ALARM MASTER	SWBD	SWITCHBOARD
GD	GARBAGE DISPOSAL	TTB	TELEPHONE TERMINAL BOARD
GFI	GROUND FAULT INTERRUPTER	TYP	TYPICAL
GND	GROUND	UN	UNLESS OTHERWISE NOTED
HVAC	HEATING, VENTILATING & AIR CONDITIONING	WP	WEATHERPROOF
		WG	WIREGUARD



GENERAL NOTES

- THE FACILITY WILL REMAIN IN OPERATION DURING CONSTRUCTION.
- COORDINATE ALL SHUTDOWNS AND CONSTRUCTION ACTIVITY WITH FACILITIES STAFF.
- SIZE AND LOCATION OF ALL EXISTING ELECTRICAL EQUIPMENT IS APPROXIMATE. CONTRACTOR SHALL SITE VERIFY THE EXACT LOCATION OF EXISTING AND CONSTRUCT ALL WORK FROM FIELD DIMENSIONS.
- CONTRACTOR SHALL MAKE ADJUSTMENTS NECESSARY TO ACCOMMODATE MINOR DEVIATIONS AT NO COST TO OWNER.
- LIGHT LINE WORK INDICATES EXISTING ELECTRICAL CIRCUITRY AND OTHER ELECTRICAL EQUIPMENT. DASHED LINE WORK INDICATES ELECTRICAL DEVICES AND EQUIPMENT TO BE REMOVED.
- WHERE EXISTING EQUIPMENT IS REMOVED AND NOT REPLACED IN THE SAME LOCATION, PATCH AND PAINT SURFACES TO MATCH ORIGINAL CONDITION.
- REMOVE ALL ABANDONED RACEWAY AND WIRING.
- RECONNECT ALL CIRCUITRY TO REMAINING DEVICES AND EQUIPMENT.
- MAINTAIN ACCESSIBILITY OF EQUIPMENT AND JUNCTION BOXES AS NECESSARY AND TO OWNERS SATISFACTION.
- RUN ALL BUILDING RACEWAY CONCEALED, UNLESS OTHERWISE NOTED.
- CARRY GROUND WIRE IN ALL LIGHTING, POWER, AND FEEDER CIRCUITS.
- COORDINATE ALL DEVICE LOCATIONS WITH OTHER TRADES TO AVOID POSSIBLE CONFLICTS WITH DUCTS, SPRINKLER PIPING AND OTHER OBSTACLES AFFECTING INSTALLATION.
- PROVIDE BLANK FACE PLATES FOR ALL SWITCHES BEING REMOVED.
- THE WORD 'PROVIDE' WHEN USED ON THESE ELECTRICAL PLANS IS INTENDED TO MEAN THAT THE ELECTRICAL CONTRACTOR IS TO FURNISH AND INSTALL THE RELATED WORK DESCRIBED UNLESS OTHERWISE NOTED.
- THE TERM 'WIRING' AS USED ON THE DRAWINGS INCLUDES BOTH THE RACEWAY AND CONDUCTORS WITHIN.
- ALL DEMOLISHED EQUIPMENT SHALL BE SALVAGED TO OWNER.

RECORD DRAWING


NOTE: Documents have been corrected as per data supplied by Contractor and Revision / Change Order Drawings. They do not necessarily show all existing conditions and may not be completely accurate. Field verify existing / hidden conditions prior to commencement of new work.
DATE: AUGUST 20, 2020

REVISIONS:		
#	DESCRP.	DATE
1	ADD 01	05.17.19
5	PR 03	08.13.19

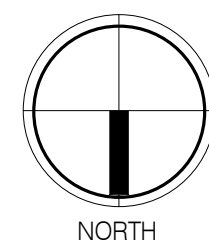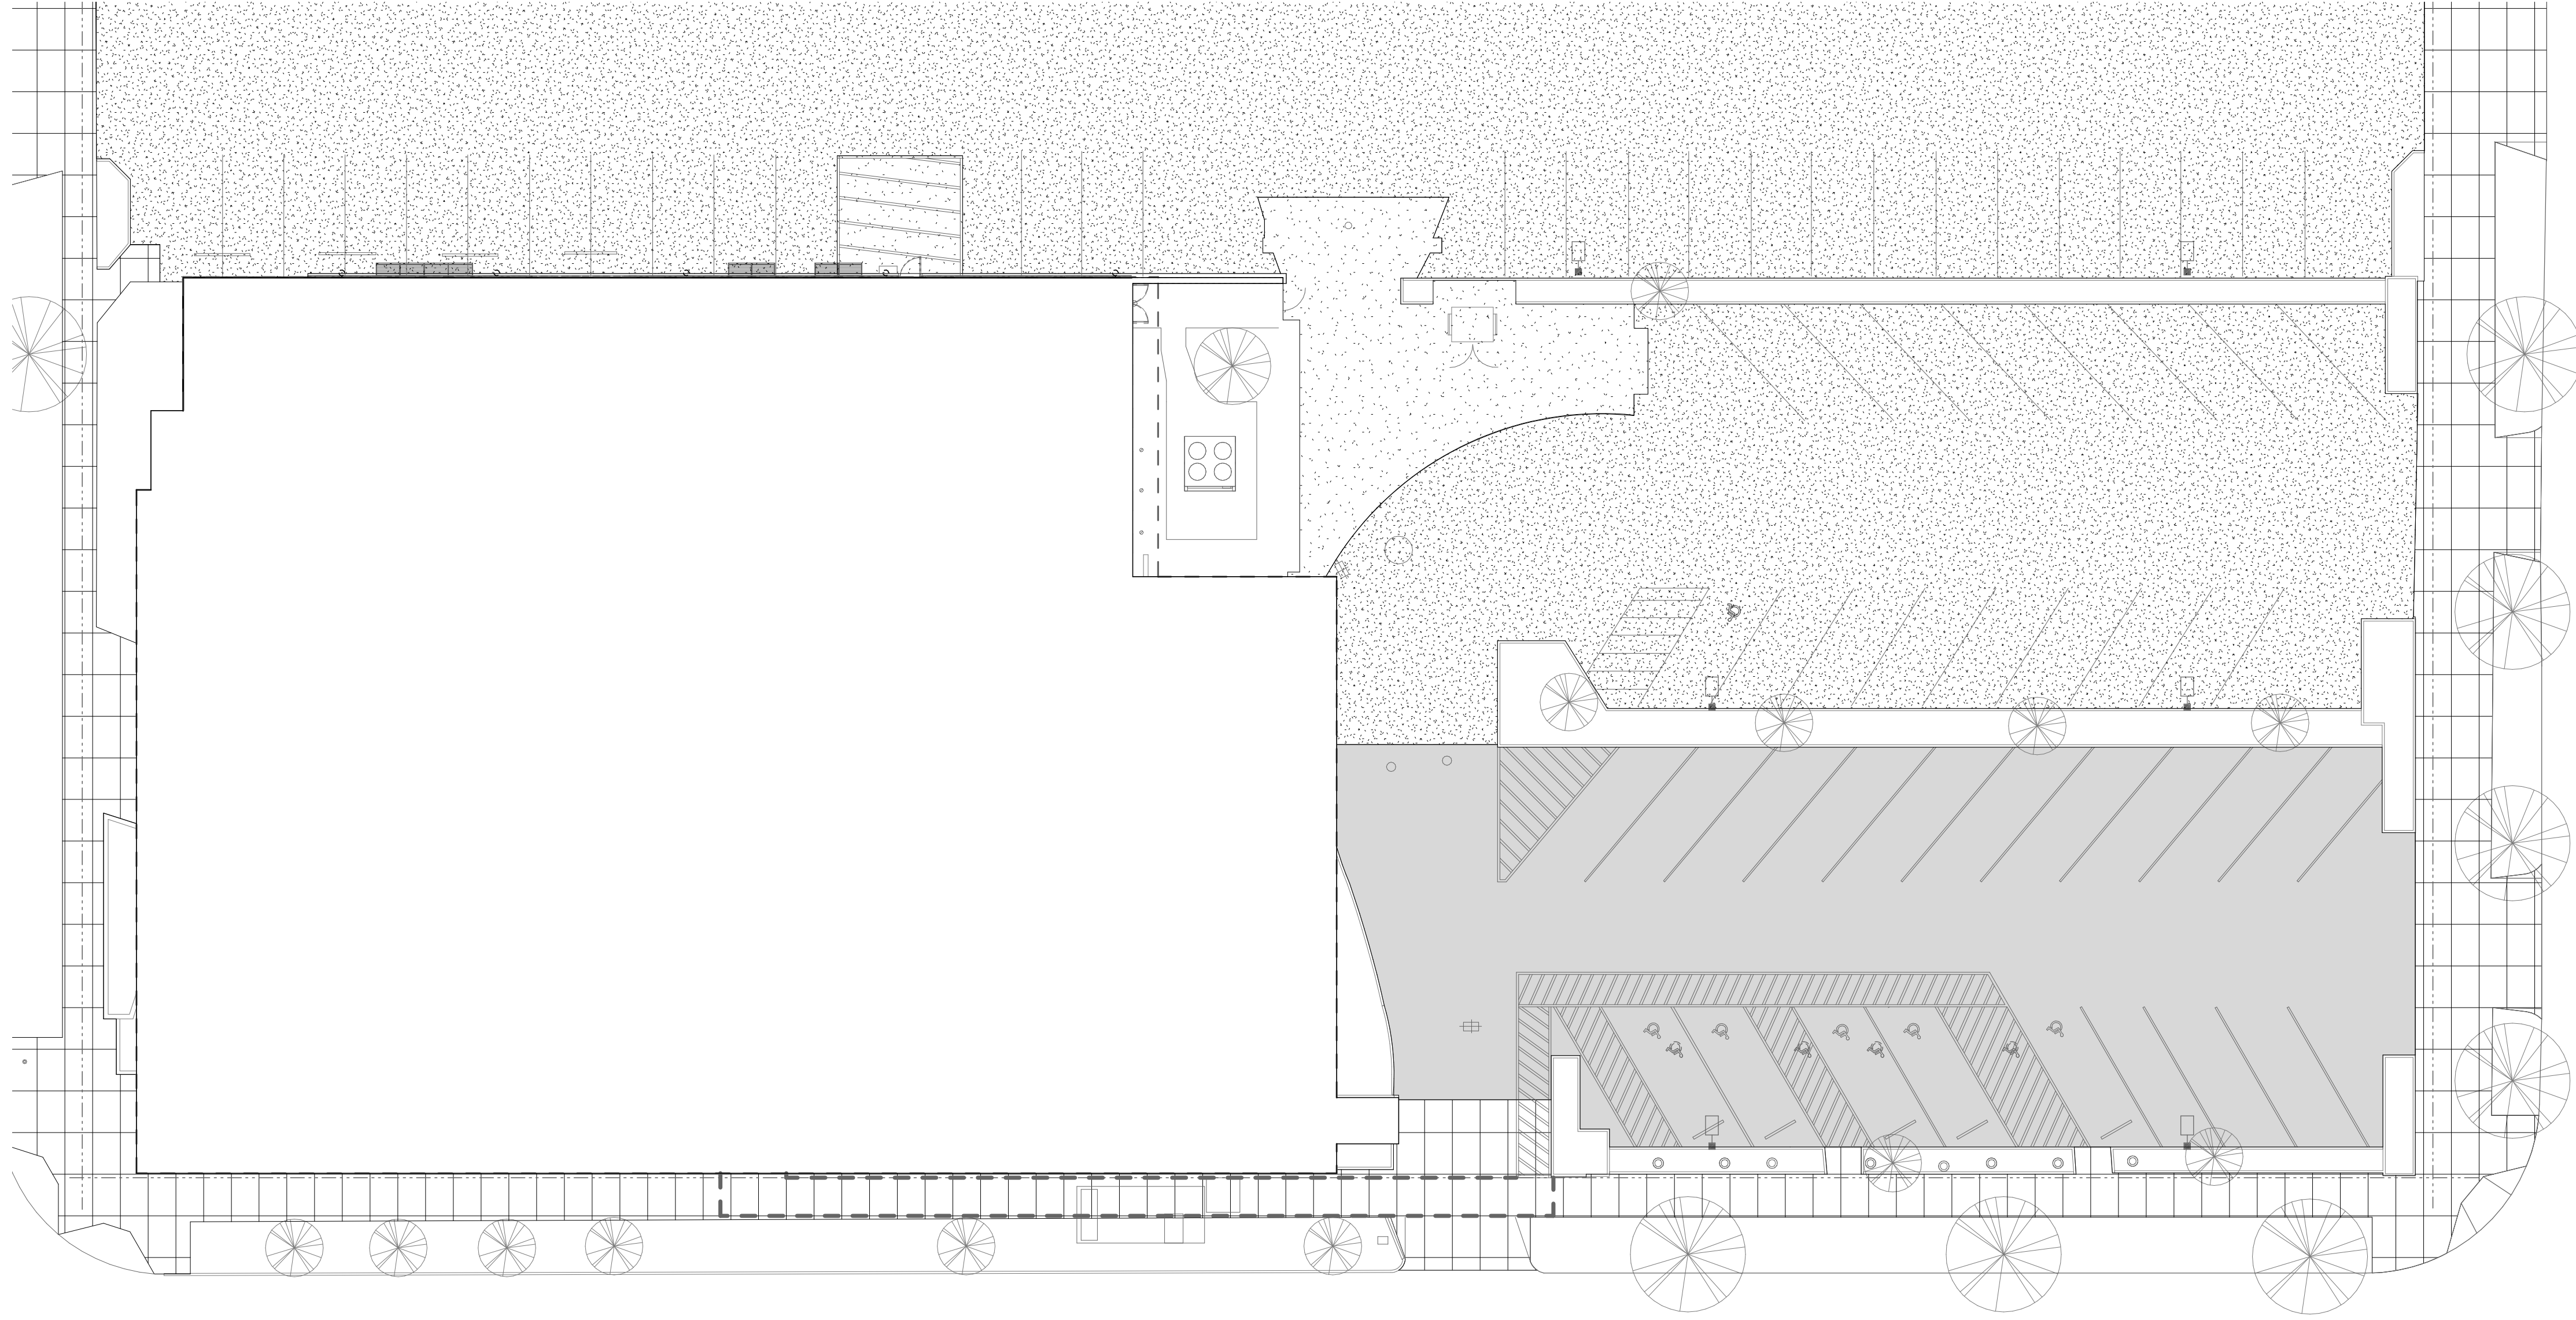

1 ELECTRICAL SITE PLAN
1/16" = 1'-0"

RECORD DRAWING
NOTE: Documents have been corrected as per data supplied by Contractor and Revision / Change Order Drawings. They do not necessarily show all existing conditions and may not be completely accurate. Field verify existing / hidden conditions prior to commencement of new work.
DATE: AUGUST 20, 2020

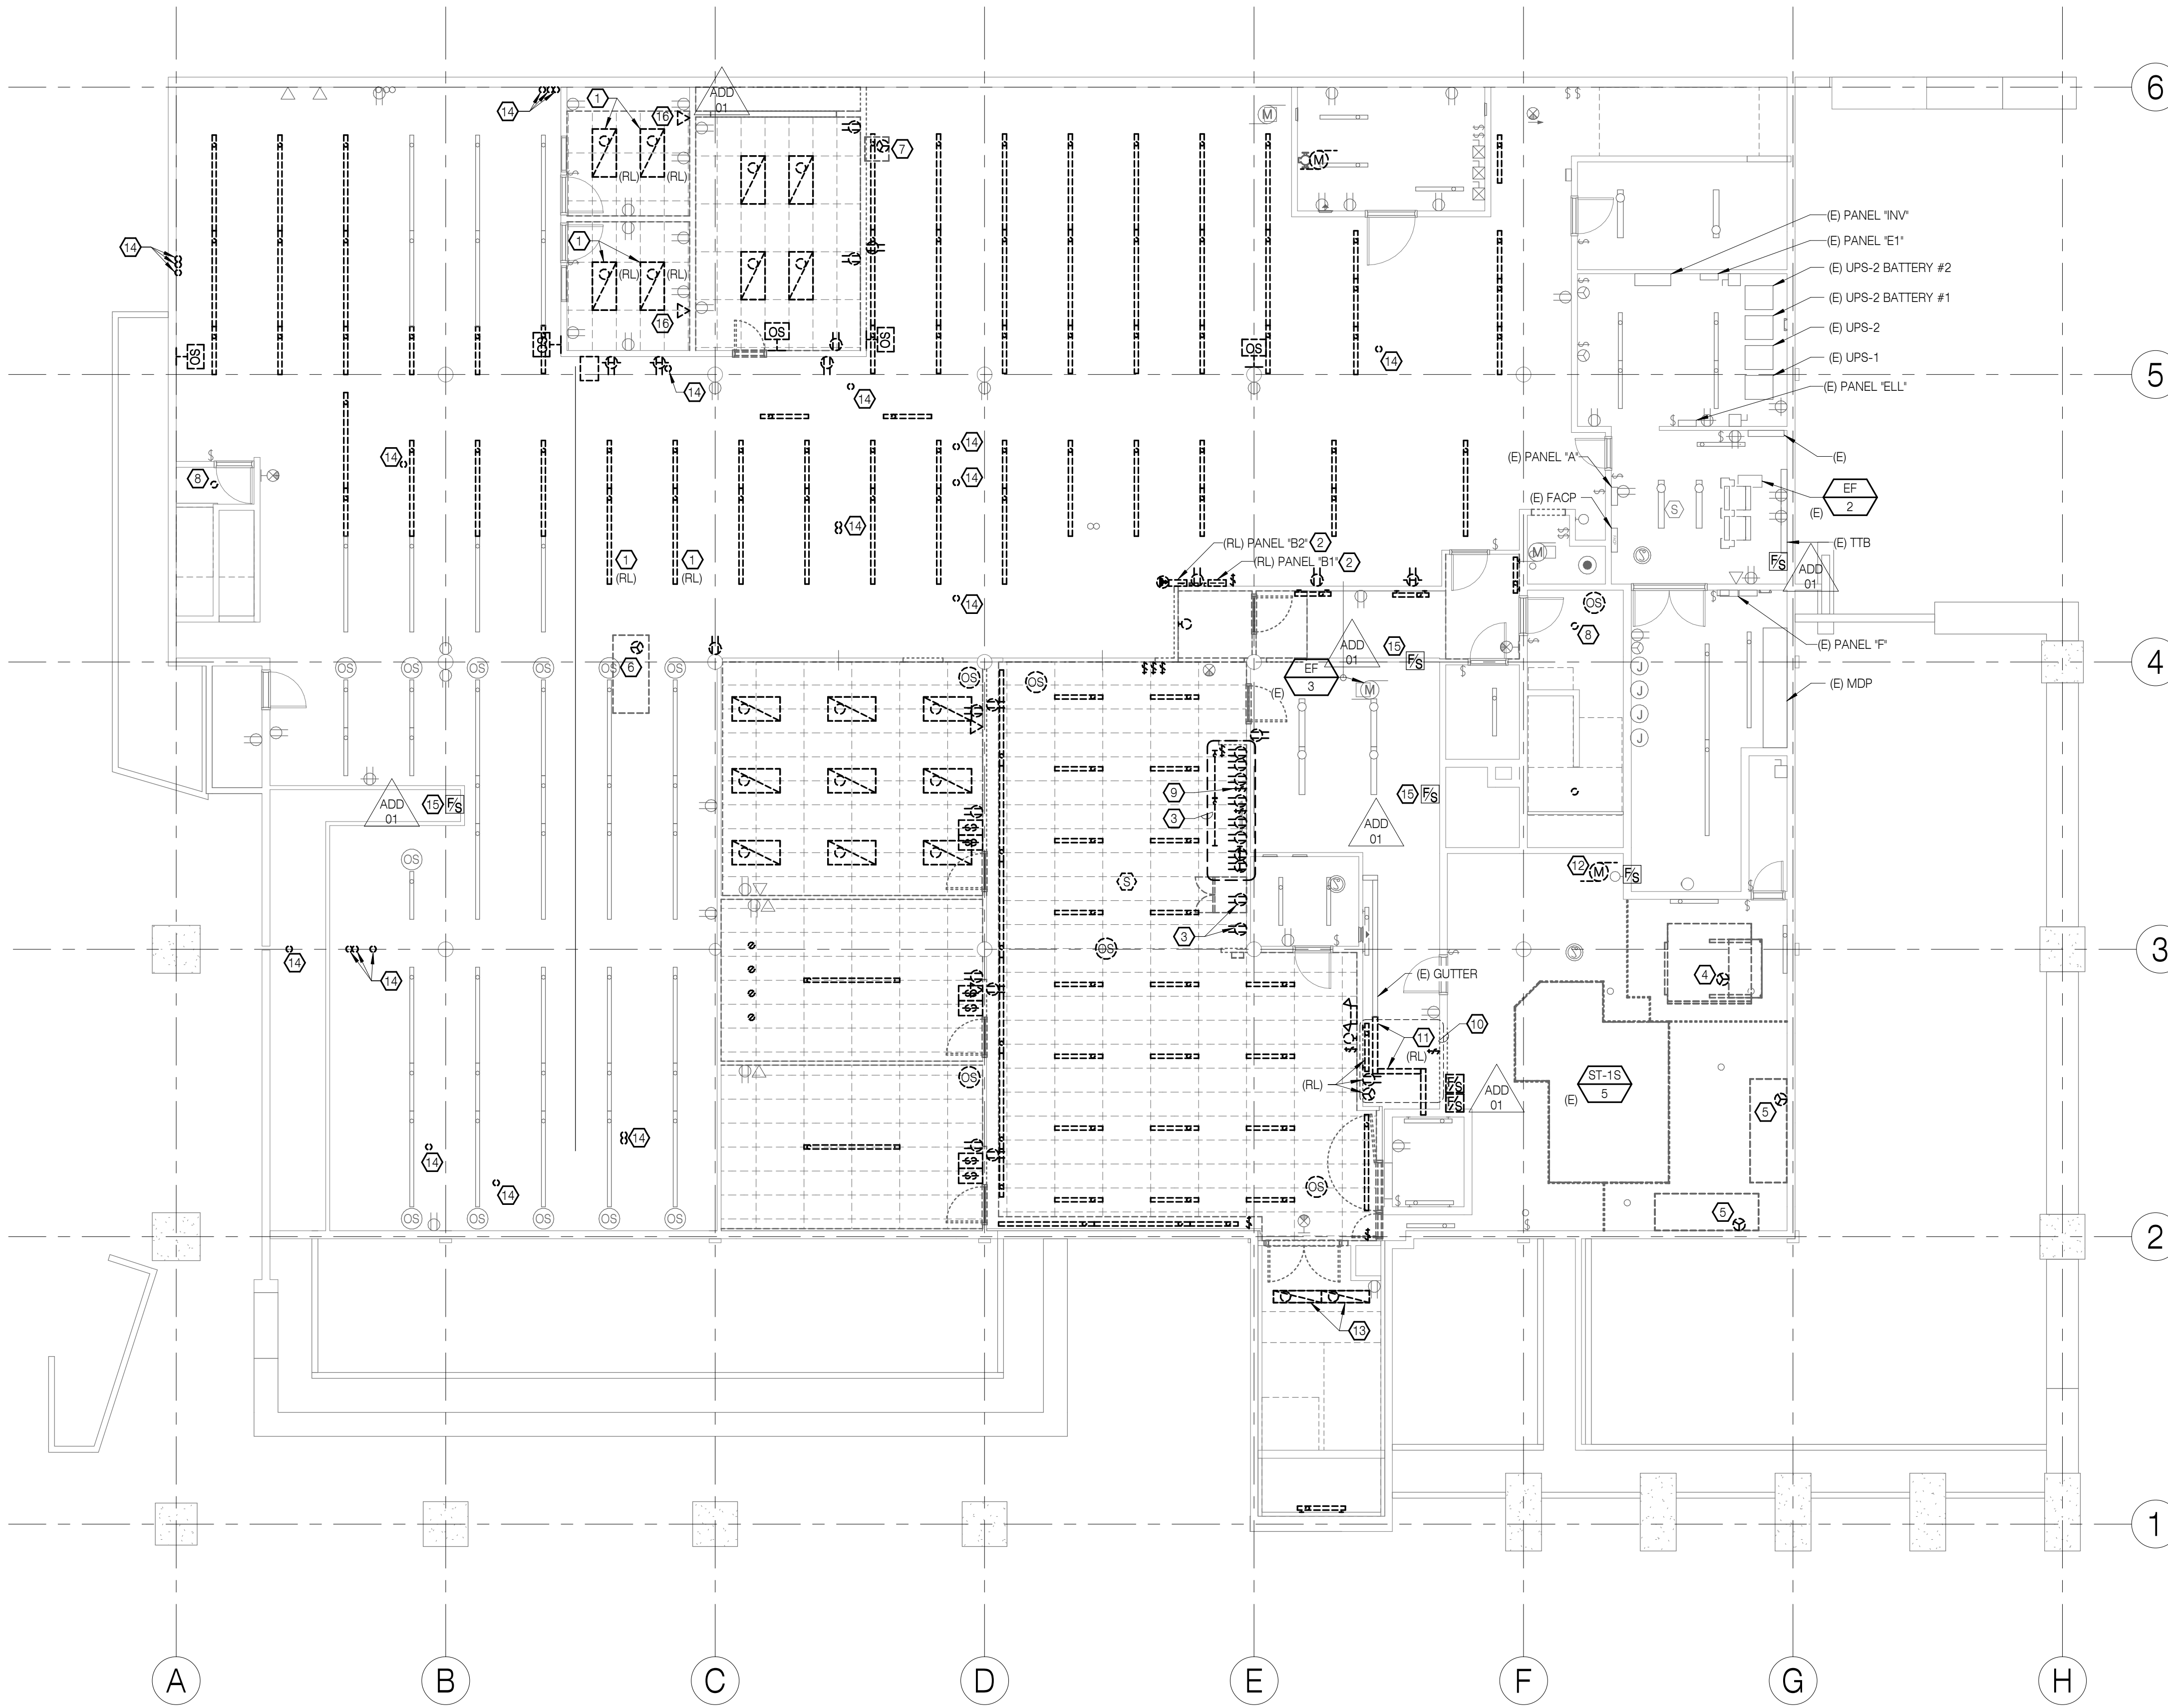

SHEET NOTES:


1. TYPE, QUANTITY, AND LOCATION OF ALL FIXTURES TO BE DEMOLISHED ARE APPROXIMATE. COORDINATE DEMOLITION SCOPE WITH ARCHITECTURAL.
2. REMOVE EXISTING SPEAKER SYSTEM.
3. REMOVE ALL EXISTING CARD READERS AND SALVAGE TO OWNER.
4. REMOVE ALL EXISTING SECURITY CAMERAS AND RETAIN FOR RELOCATION.
5. SECURITY SYSTEMS AND DEVICES FOR KAISER PORTION OF FACILITY ARE TO REMAIN IN OPERATION DURING ALL PHASES OF THE PROJECT. COORDINATE WITH ARCHITECT PRIOR TO DEMOLITION.

REFERENCE NOTES:

- 1 REMOVE FIXTURE AND RETAIN FOR RELOCATION.
- 2 PANELS TO BE RELOCATED ON OPPOSITE SIDE OF WALL. REFERENCE 1/E120.
- 3 DEMOLISH FIXTURES ABOVE COUNTERTOP LEVEL. RETAIN LOWER FIXTURES AND CIRCUITS FOR REUSE IN SAME LOCATION ON NEW FIRE RATED WALL.
- 4 EXISTING MULTIZONE SUPPLY FAN TO BE DEMOLISHED. COORDINATE WITH MECHANICAL. REFERENCE 1/M101.
- 5 DECOMMISSIONED 40-TON CHILLER TO BE DEMOLISHED. COORDINATE WITH MECHANICAL. REFERENCE 1/M101.
- 6 EXISTING AC UNIT AND CONTROLS TO BE DEMOLISHED. COORDINATE WITH MECHANICAL. REFERENCE 1/M101.
- 7 EXISTING RETURN FAN AND CONTROLS TO BE DEMOLISHED. COORDINATE WITH MECHANICAL. REFERENCE 1/M101.
- 8 DEMOLISH EXISTING FIXTURE. RETAIN J-BOX AT CEILING AND CONDUCTORS FOR USE WITH NEW FIXTURE.
- 9 DEMOLISH SWITCH CONTROLLING ADJACENT RECEPTACLE AND RECONNECT RECEPTACLE TO SAME CIRCUIT.
- 10 REMOVE FIXTURES AND SWITCHES FROM AREA TO BE DEMOLISHED TO ALLOW REPLACEMENT OF MECHANICAL EQUIPMENT. RETAIN FOR REINSTALLATION IN SAME LOCATION AFTER REPLACEMENT OF WALL.
- 11 REMOVE PORTION OF EXISTING GUTTER TO ALLOW REPLACEMENT OF MECHANICAL EQUIPMENT. GUTTER AND WIRING SHALL BE REPLACED FOLLOWING REPLACEMENT OF WALL.
- 12 DEMOLISH EXISTING SEWAGE EJECTOR PUMP & CONTROLS.
- 13 DEMOLISH FLUORESCENT ELEMENTS. RETAIN FIXTURE HOUSINGS TO MOUNT RETROFIT LED ASSEMBLY.
- 14 DEMOLISH EXISTING PENETRATION TO FIRST FLOOR. REFERENCE 1/E102.
- 15 TEMPORARILY DISCONNECT POWER TO EXISTING DAMPER. DAMPER MUST REMAIN CLOSED DURING CONSTRUCTION. COORDINATE WITH MECHANICAL. REFERENCE 1/M101.
- 16 REMOVE FACEPLATE AND DATA CABLING. RETAIN J-BOX FOR INSTALLATION OF NEW OUTLET IN SAME LOCATION.



RECORD DRAWING
 NOTE: Documents have been corrected as per data supplied by Contractor and Revision / Change Order Drawings. They do not necessarily show all existing conditions and may not be completely accurate. Field verify existing / hidden conditions prior to commencement of new work.
 DATE: AUGUST 20, 2020

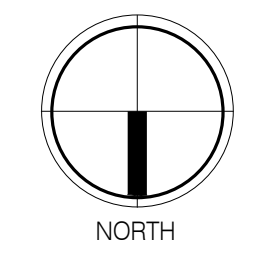


1 ELECTRICAL DEMOLITION - LOWER LEVEL
1/8" = 1'-0"

SHEET TITLE:
ELECTRICAL DEMOLITION - LOWER LEVEL

REVISIONS:

#	DESCRP.	DATE
1	ADD 01	05.17.19
8	PR 05	09.16.19

ISSUE DATE: 08/20/2020

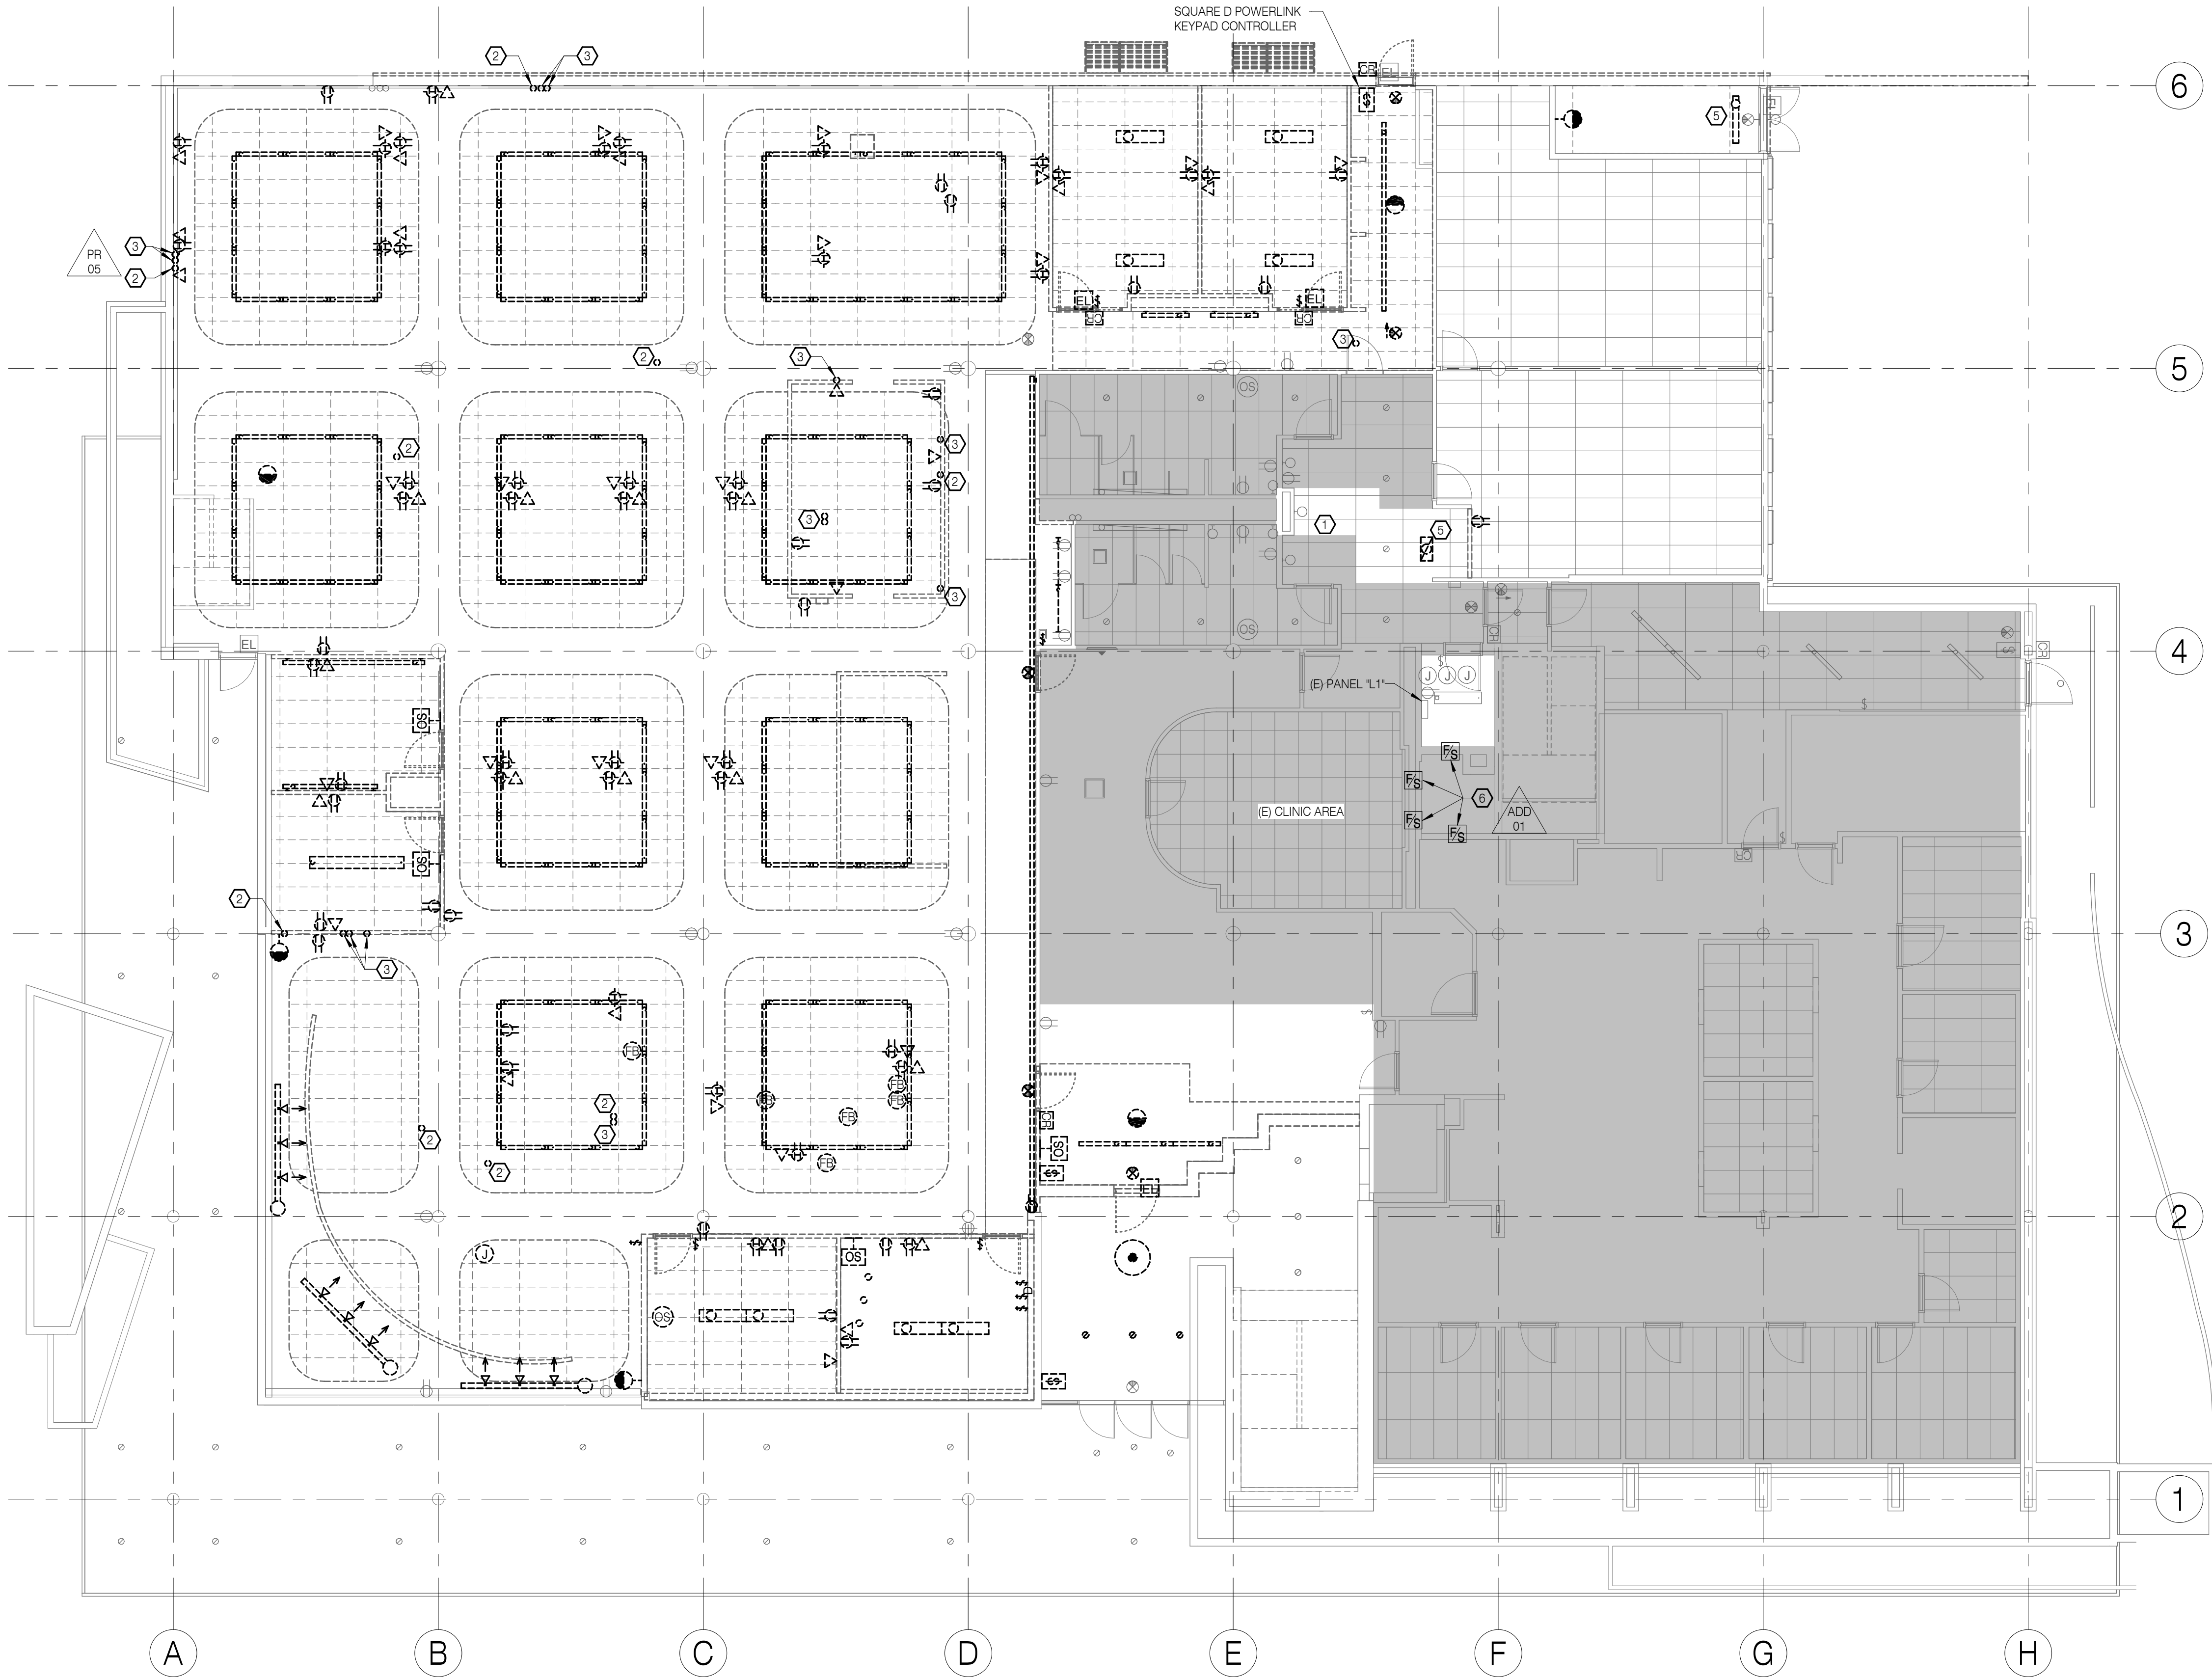

- SHEET NOTES:**
1. TYPE, QUANTITY, AND LOCATION OF ALL FIXTURES TO BE DEMOLISHED ARE APPROXIMATE. COORDINATE DEMOLITION SCOPE WITH ARCHITECTURAL.
 2. REMOVE EXISTING SPEAKER SYSTEM.
 3. REMOVE ALL EXISTING CARD READERS AND SALVAGE TO OWNER.
 4. REMOVE ALL EXISTING SECURITY CAMERAS AND RETAIN FOR RELOCATION.
 5. SECURITY SYSTEMS AND DEVICES FOR KAISER PORTION OF FACILITY ARE TO REMAIN IN OPERATION DURING ALL PHASES OF THE PROJECT. COORDINATE WITH ARCHITECT PRIOR TO DEMOLITION.

- REFERENCE NOTES:**
- 1 DISCONNECT (E) WATER COOLER FOR REMOVAL. RETAIN CIRCUIT FOR NEW COOLER INSTALLATION. COORDINATE WITH PLUMBING. REFERENCE 1/P102.
 - 2 DEMOLISH EXISTING POWER PENETRATION FROM LOWER LEVEL. COORDINATE WITH ARCHITECTURAL.
 - 3 DEMOLISH EXISTING DATA PENETRATION FROM LOWER LEVEL. COORDINATE WITH ARCHITECTURAL.
 - 4 CARD READER TO REMAIN OPERATIONAL UNTIL REPLACEMENT IS INSTALLED AND OPERATIONAL.
 - 5 RETAIN CIRCUIT SERVING DEMOLISHED FIXTURE FOR USE WITH NEW FIXTURE IN SAME AREA.
 - 6 EXISTING DAMPERS TO REMAIN OPERATIONAL DURING CONSTRUCTION

ADD 01

RECORD DRAWING

NOTE: Documents have been corrected as per data supplied by Contractor and Revision / Change Order Drawings. They do not necessarily show all existing conditions and may not be completely accurate. Field verify existing / hidden conditions prior to commencement of new work.


DATE: AUGUST 20, 2020

SHEET TITLE:
ELECTRICAL DEMOLITION - FIRST FLOOR


REVISIONS:

#	DESCRIP.	DATE
1	ADD 01	05.17.19
8	PR 05	09.16.19

ISSUE DATE: 08/20/2020

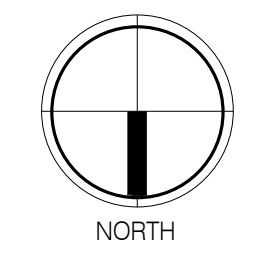

1 ELECTRICAL DEMOLITION - FIRST FLOOR
1/8" = 1'-0"

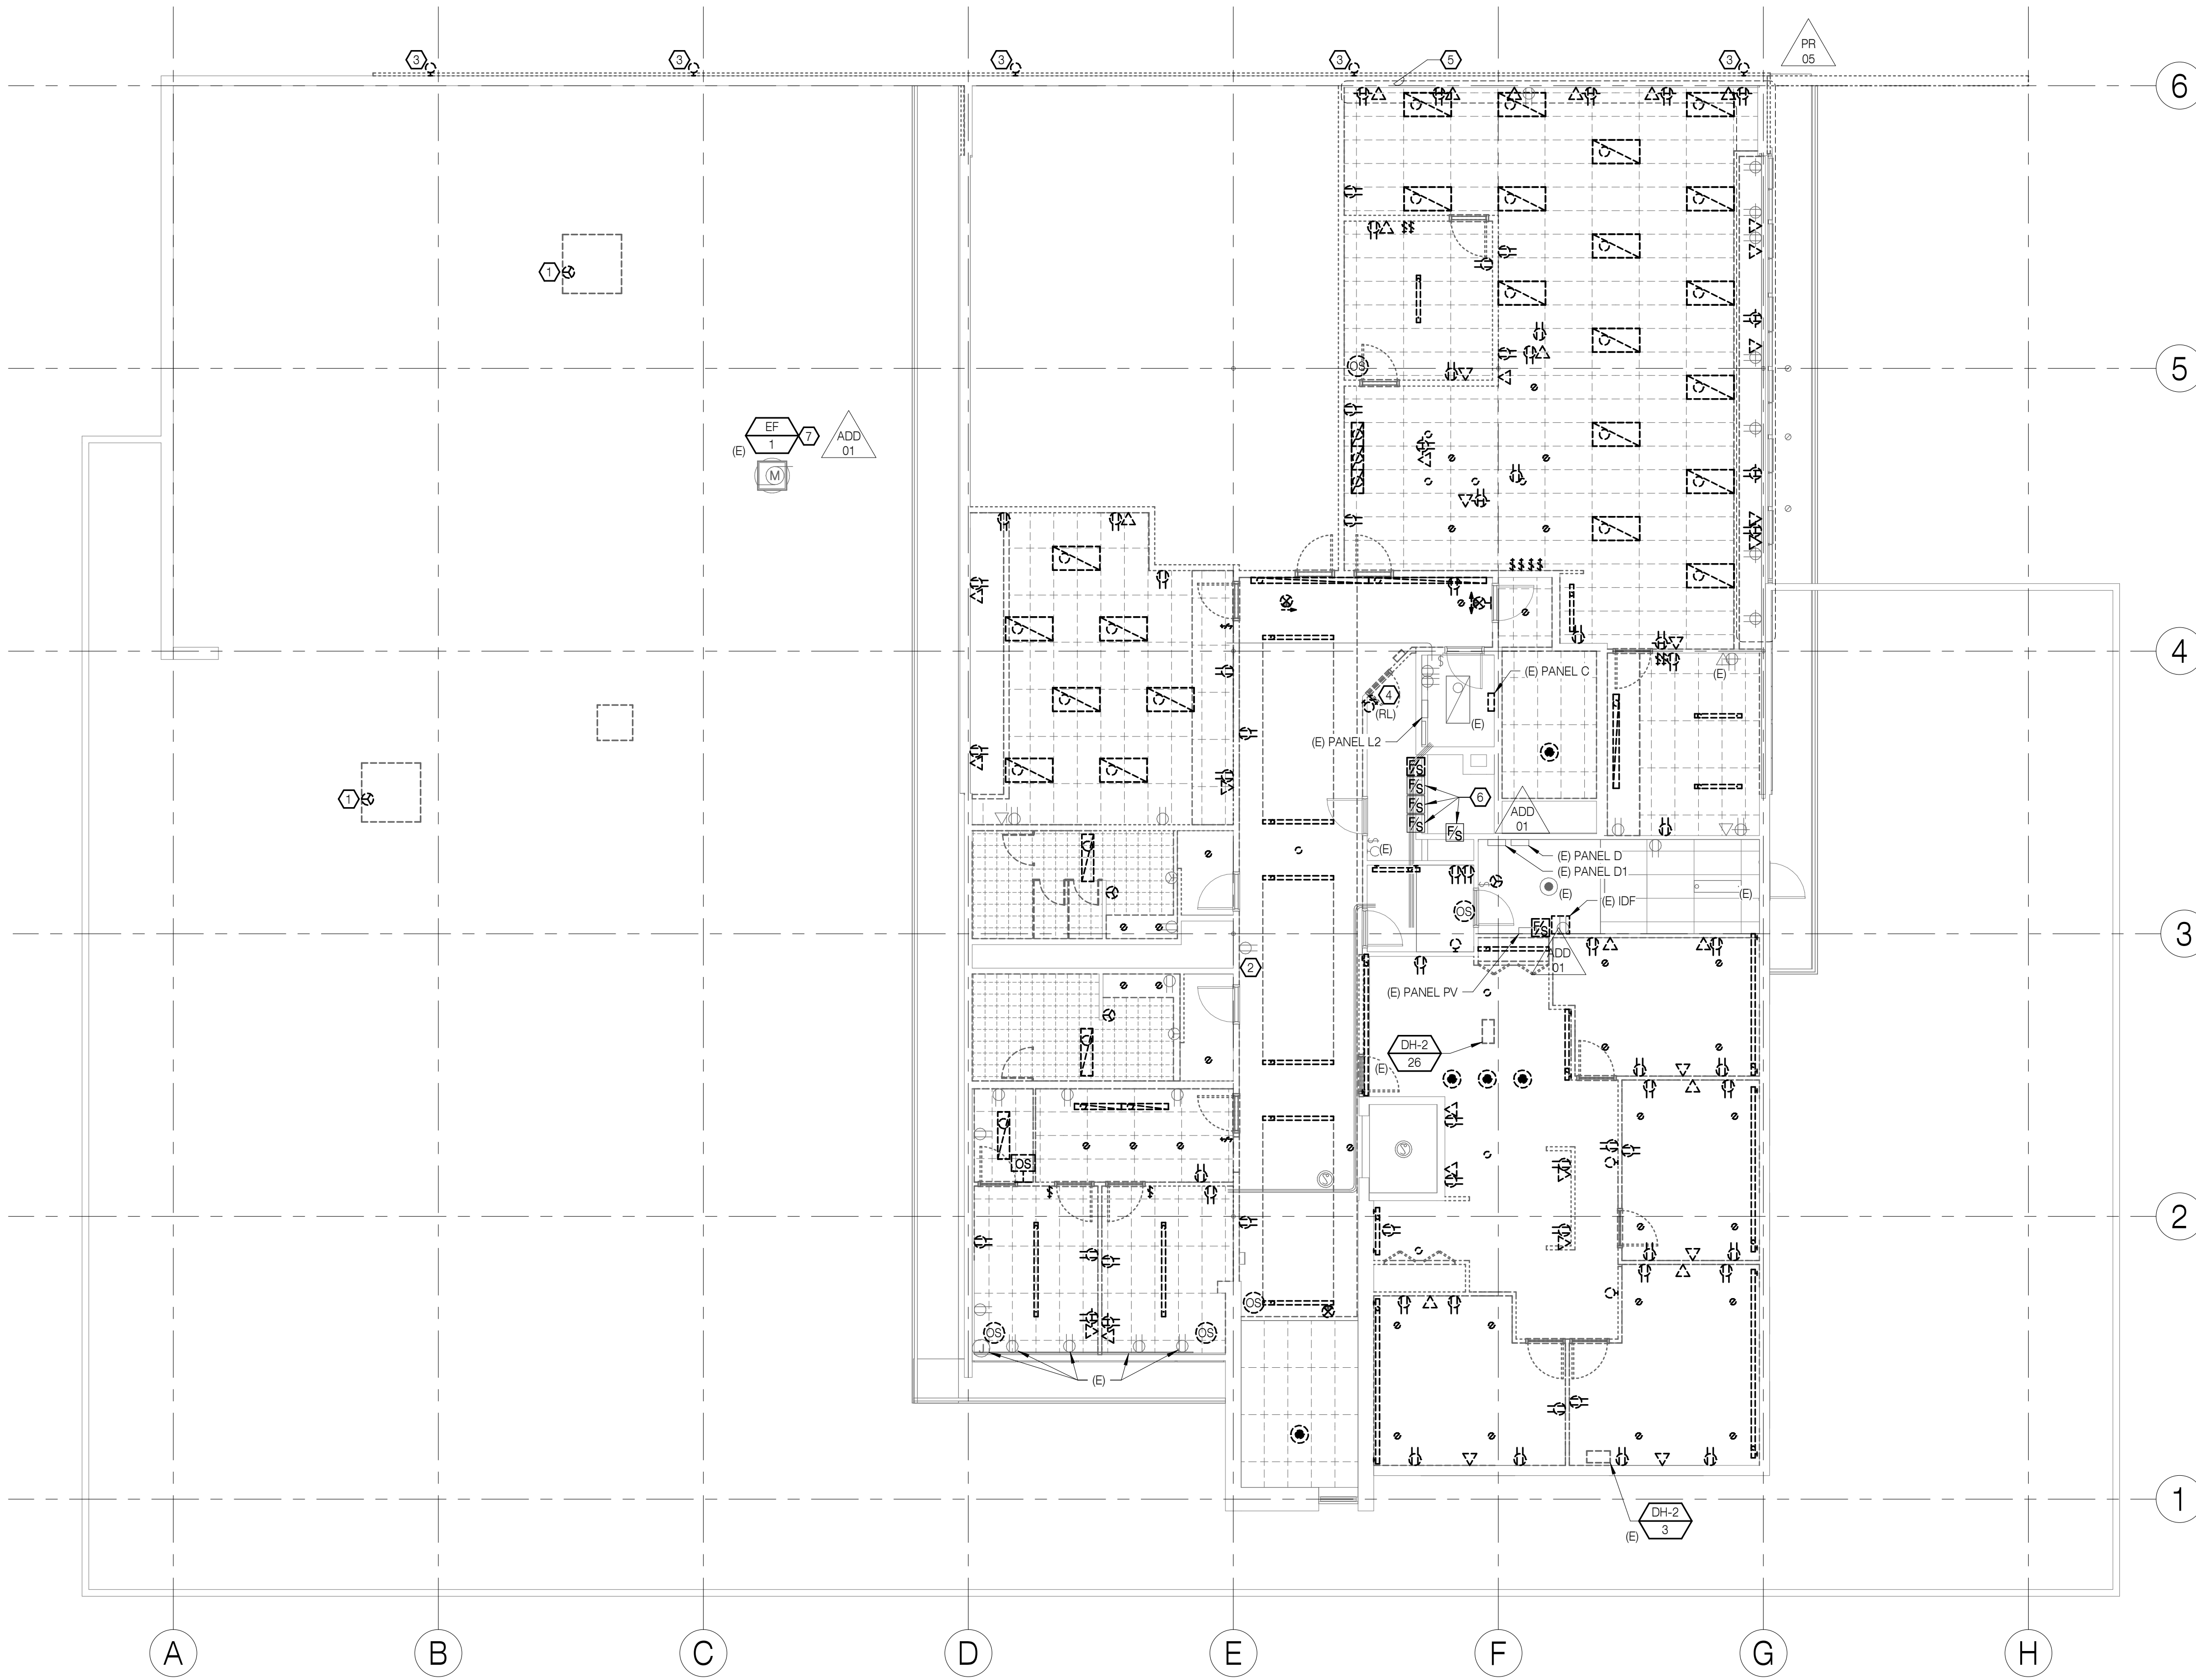

- SHEET NOTES:**
1. TYPE, QUANTITY, AND LOCATION OF ALL FIXTURES TO BE DEMOLISHED ARE APPROXIMATE. COORDINATE DEMOLITION SCOPE WITH ARCHITECTURAL.
 2. REMOVE EXISTING SPEAKER SYSTEM.
 3. REMOVE ALL EXISTING CARD READERS AND SALVAGE TO OWNER.
 4. REMOVE ALL EXISTING SECURITY CAMERAS AND RETAIN FOR RELOCATION.
 5. SECURITY SYSTEMS AND DEVICES FOR KAISER PORTION OF FACILITY ARE TO REMAIN IN OPERATION DURING ALL PHASES OF THE PROJECT. COORDINATE WITH ARCHITECT PRIOR TO DEMOLITION.

- REFERENCE NOTES:**
- 1 EXISTING HEAT PUMP TO BE DEMOLISHED. COORDINATE WITH MECHANICAL. REFERENCE 1/M103.
 - 2 DISCONNECT (E) WATER COOLER FOR REMOVAL. RETAIN CIRCUIT FOR NEW COOLER INSTALLATION. COORDINATE WITH PLUMBING. REFERENCE 1/P103.
 - 3 EXTERIOR WALL PACK
 - 4 REMOVE SWITCH AND FIXTURE. RETAIN FOR RELOCATION.
 - 5 DEMOLISH ALL RECEPTACLES TO BE OBSOURED BY NEW SYSTEMS FURNITURE. REMOVE CONDUCTORS AND DATA CABLING AND PROVIDE BLANK FACEPLATES. COORDINATE WITH ARCHITECTURAL AND OWNERS REPRESENTATIVE. REFERENCE 1/E123.
 - 6 TEMPORARILY DISCONNECT POWER TO EXISTING DAMPERS. DAMPERS MUST REMAIN CLOSED DURING CONSTRUCTION. COORDINATE WITH MECHANICAL. REFERENCE 1/M103.
 - 7 DISCONNECT POWER TO EXHAUST FAN EF-1 FOR REFURBISHMENT. COORDINATE WITH MECHANICAL.

RECORD DRAWING
 NOTE: Documents have been corrected as per data supplied by Contractor and Revision / Change Order Drawings. They do not necessarily show all existing conditions and may not be completely accurate. Field verify existing / hidden conditions prior to commencement of new work.
 DATE: AUGUST 20, 2020



RECORD DRAWING
 20 AUGUST 2020

SW E
 SYSTEMS WEST ENGINEERS
 725 A Street
 Springfield, OR 97477
 541.342.7210
 systemswestengineers.com
 SWE Proj. No. U003.08

RECORD DRAWINGS
HOMES FOR GOOD OFFICE BUILDING
REMODEL
 100 WEST 30TH AVENUE
 EUGENE, OR 97401


SHEET TITLE:
ELECTRICAL DEMOLITION - SECOND FLOOR

REVISIONS:


#	DESCRP.	DATE
1	ADD 01	05.17.19
8	PR 05	09.16.19

ISSUE DATE: 08/20/2020

E103

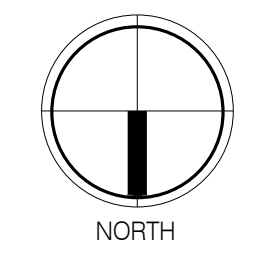

1 ELECTRICAL DEMOLITION - SECOND FLOOR
 1/8" = 1'-0"

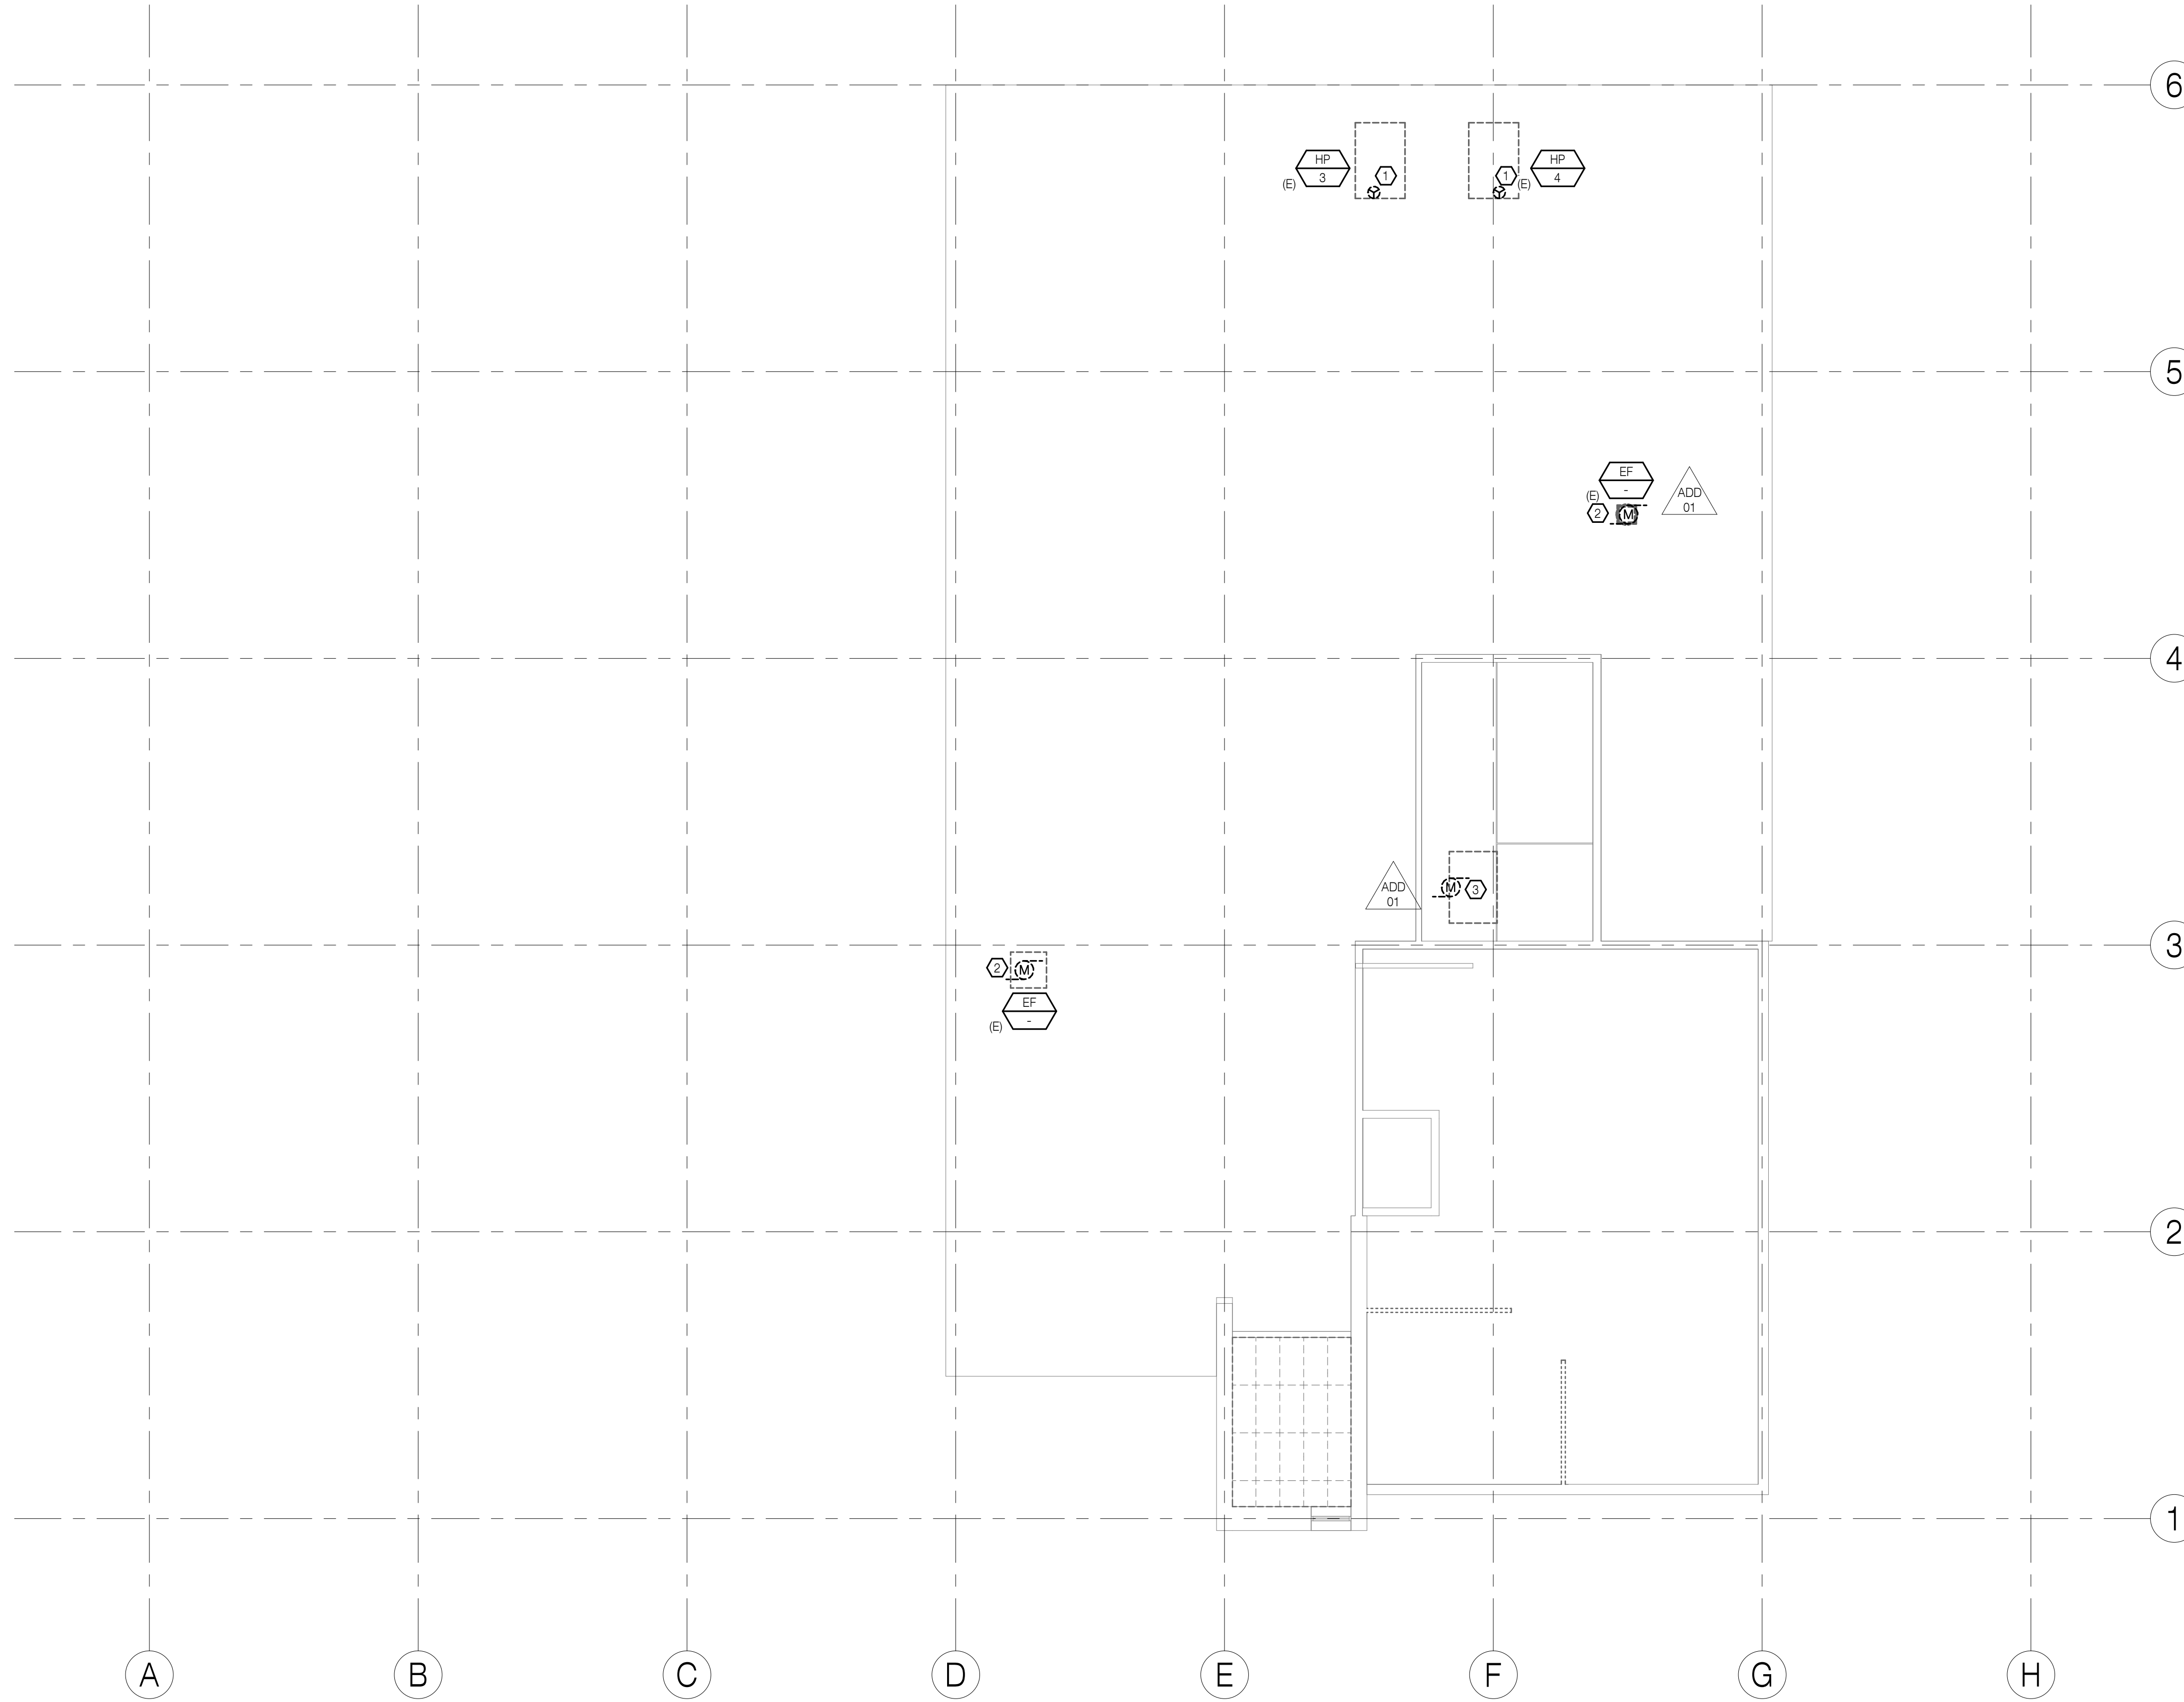

REFERENCE NOTES:

- ① EXISTING HEAT PUMP TO BE DEMOLISHED. COORDINATE WITH MECHANICAL. REFERENCE 1/M104.
- ② EXISTING EXHAUST FAN TO BE DEMOLISHED. COORDINATE WITH MECHANICAL. REFERENCE 1/M104.
- ③ EXISTING RETURN FAN TO BE DEMOLISHED. COORDINATE WITH MECHANICAL. REFERENCE 1/M104.



RECORD DRAWING


NOTE: Documents have been corrected as per data supplied by Contractor and Revision / Change Order Drawings. They do not necessarily show all existing conditions and may not be completely accurate. Field verify existing / hidden conditions prior to commencement of new work.
DATE: AUGUST 20, 2020

SHEET TITLE:
ELECTRICAL DEMOLITION - SECOND FLOOR ROOF

REVISIONS:


#	DESCRP.	DATE
1	ADD 01	05.17.19

ISSUE DATE: 08/20/2020

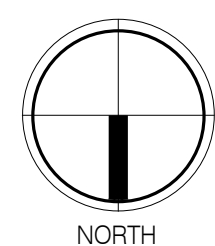

1

ELECTRICAL DEMOLITION - SECOND FLOOR ROOF
1/8" = 1'-0"

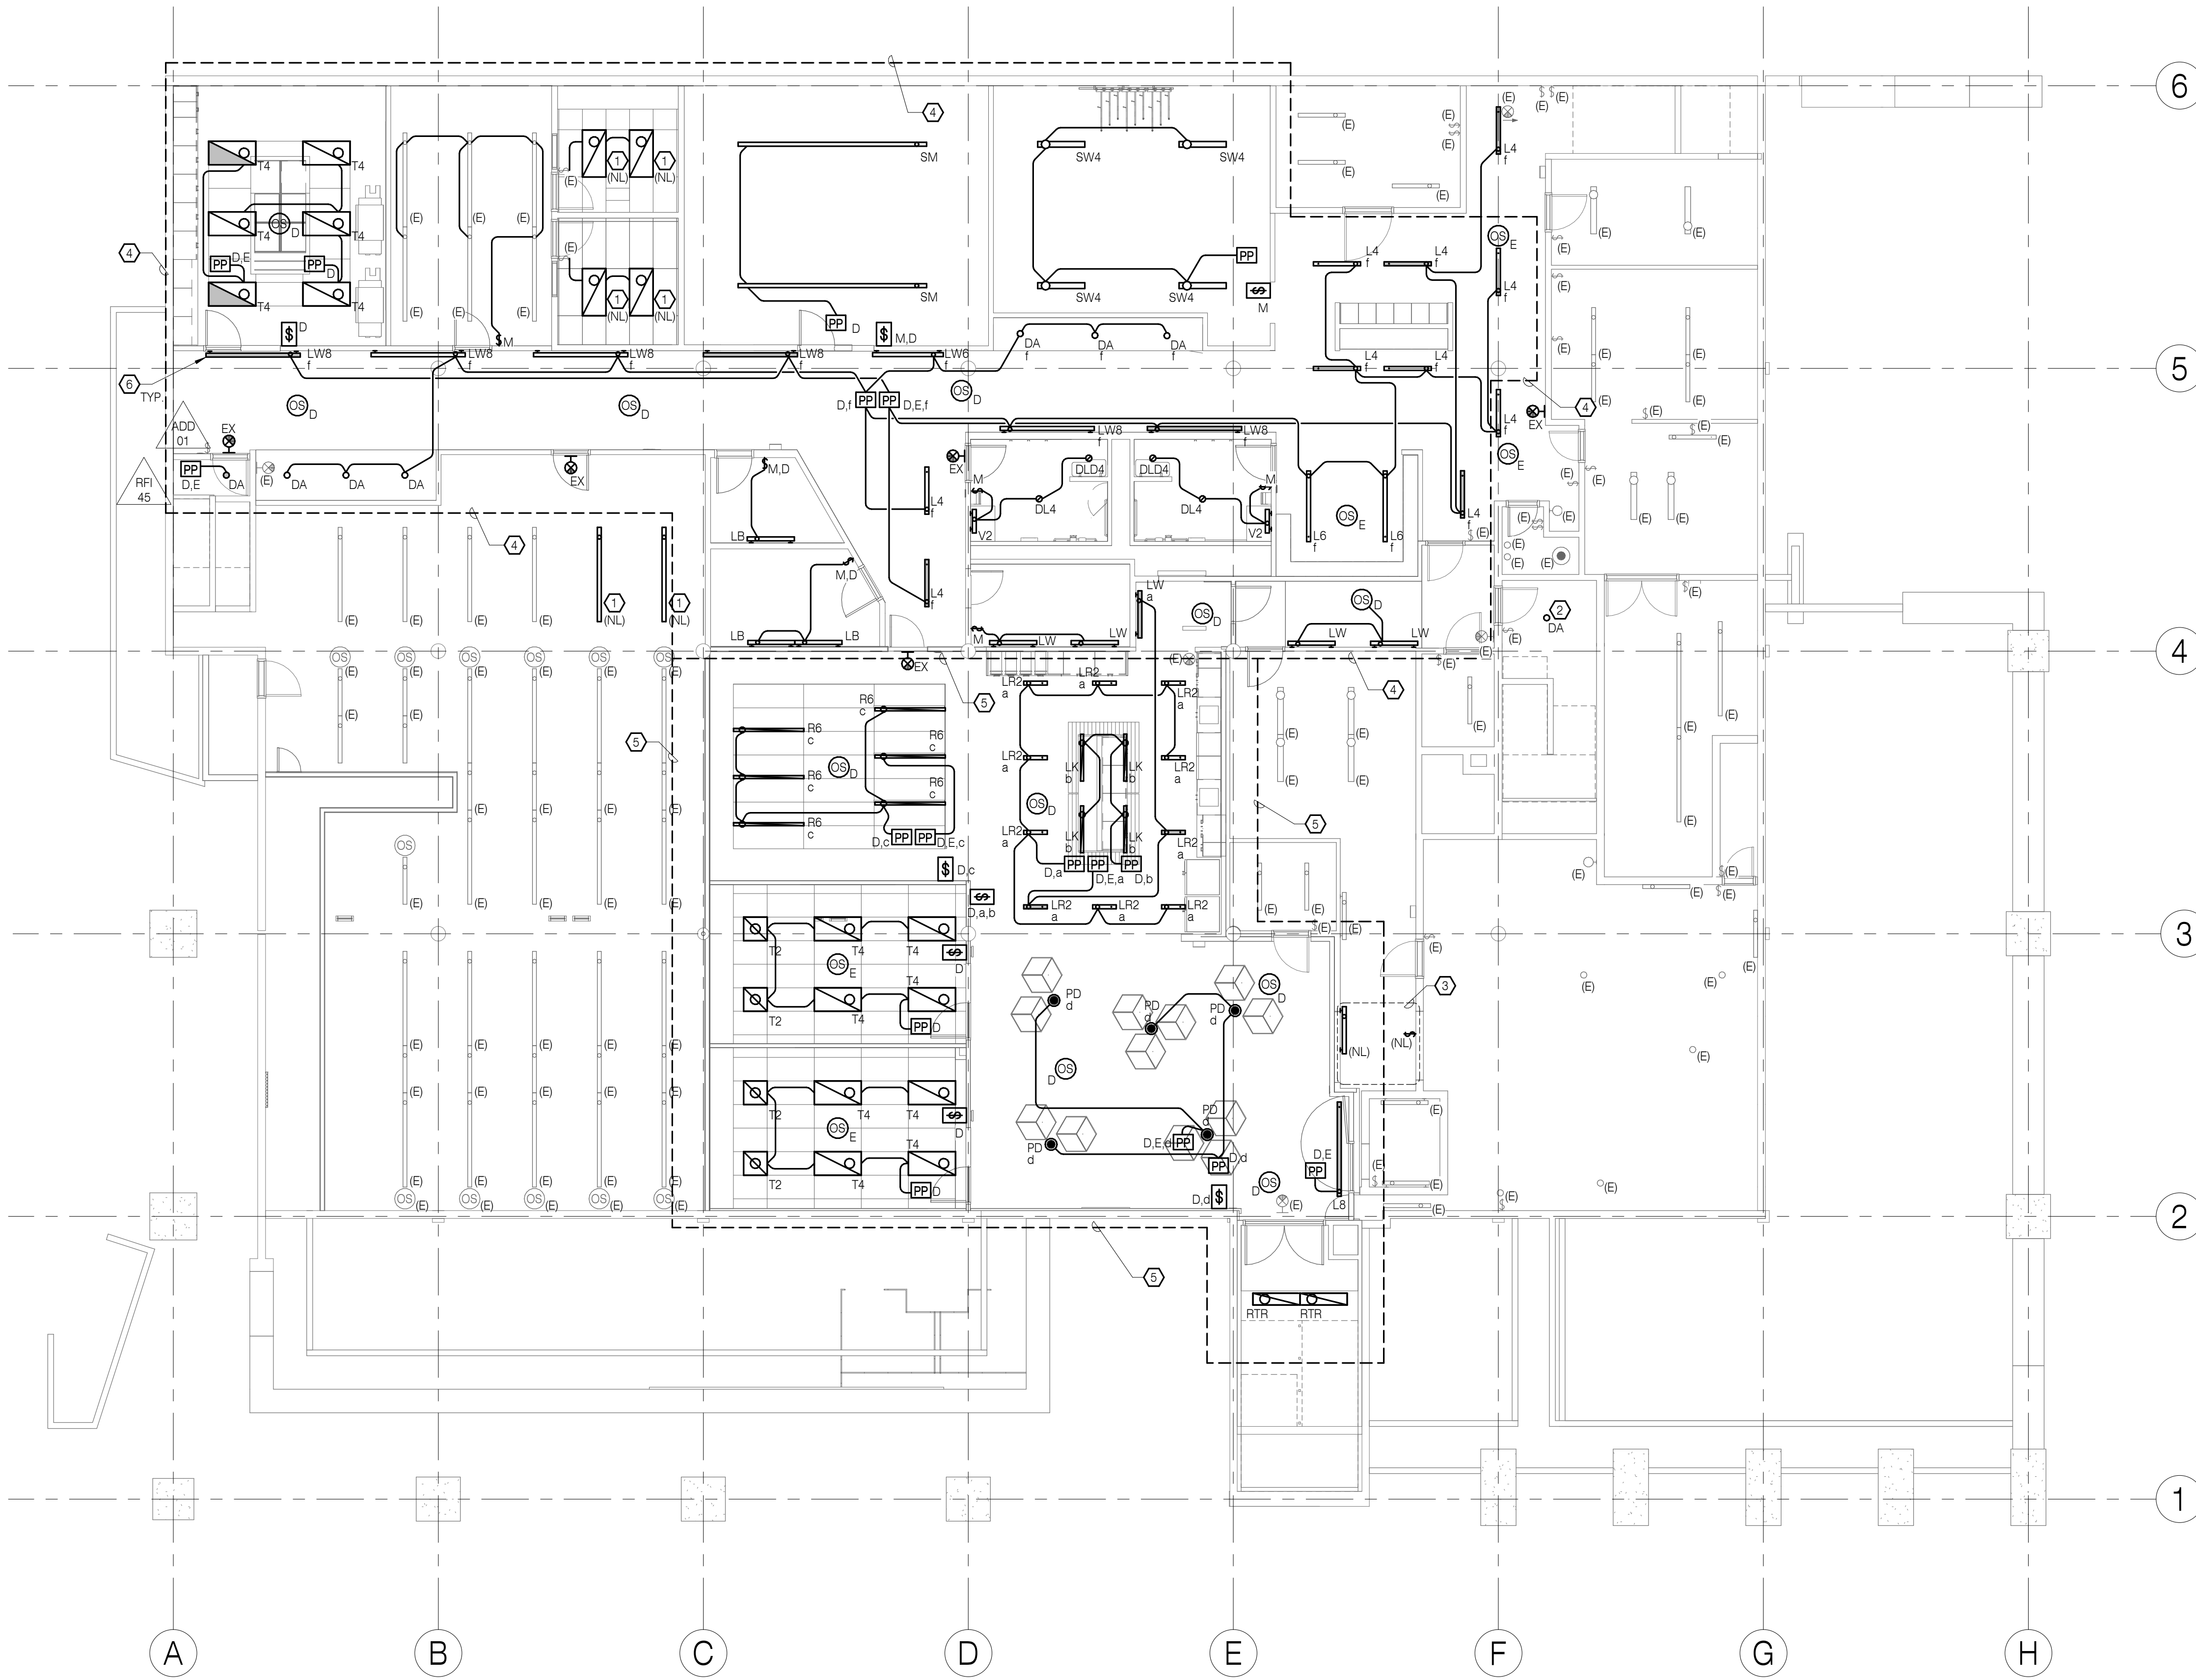

- REFERENCE NOTES:
- 1 FIXTURE REMOVED DURING DEMOLITION. REINSTALL AT NEW LOCATION.
 - 2 INSTALL NEW FIXTURE AT EXISTING JUNCTION BOX AND CONNECT TO CIRCUIT MADE AVAILABLE BY DEMOLITION OF EXISTING FIXTURE.
 - 3 REINSTALL FIXTURES AND SWITCHES IN PREVIOUS AREA FOLLOWING REPLACEMENT OF WALL. RECONNECT TO CIRCUITS AND LOADS PREVIOUSLY CONNECTED TO DEVICES.
 - 4 CIRCUIT NORMAL LUMINAIRES TO L-1, EXIT SIGNS TO L1-2 AND EMERGENCY LUMINAIRES TO THE LIGHTING INVERTER (FIRST FLOOR) CIRCUIT 1 IN THIS AREA.
 - 5 CIRCUIT NORMAL LUMINAIRES TO L-3, EXIT SIGNS TO L1-2 AND EMERGENCY LUMINAIRES TO THE LIGHTING INVERTER (FIRST FLOOR) CIRCUIT 1 IN THIS AREA.
 - 6 INSTALL WALL-MOUNTED FIXTURES IN HALL 029 AT 7' - 4" AFF. COORDINATE LOCATION AND ELEVATION WITH ARCHITECTURAL.

RECORD DRAWING
20 AUGUST 2020

SW E
SYSTEMS WEST ENGINEERS
725 A Street
Springfield, OR 97477
541.342.7210
systemswestengineers.com
SWE Proj. No. U003.08

RECORD DRAWINGS
HOMES FOR GOOD OFFICE BUILDING REMODEL
100 WEST 10TH AVENUE
EUGENE, OR 97401

RECORD DRAWING
NOTE: Documents have been corrected as per data supplied by Contractor and Revision / Change Order Drawings. They do not necessarily show all existing conditions and may not be completely accurate. Field verify existing / hidden conditions prior to commencement of new work.
DATE: AUGUST 20, 2020


SHEET TITLE:
LIGHTING PLAN - LOWER LEVEL

REVISIONS:


#	DESCRIP.	DATE
1	ADD 01	05.17.19
9	RFI 45	09.16.19

ISSUE DATE: 08/20/2020

E111

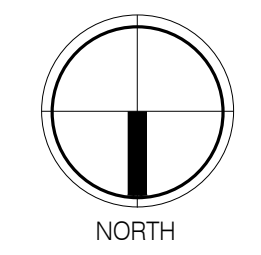

1 LIGHTING PLAN - LOWER LEVEL
1/8" = 1'-0"

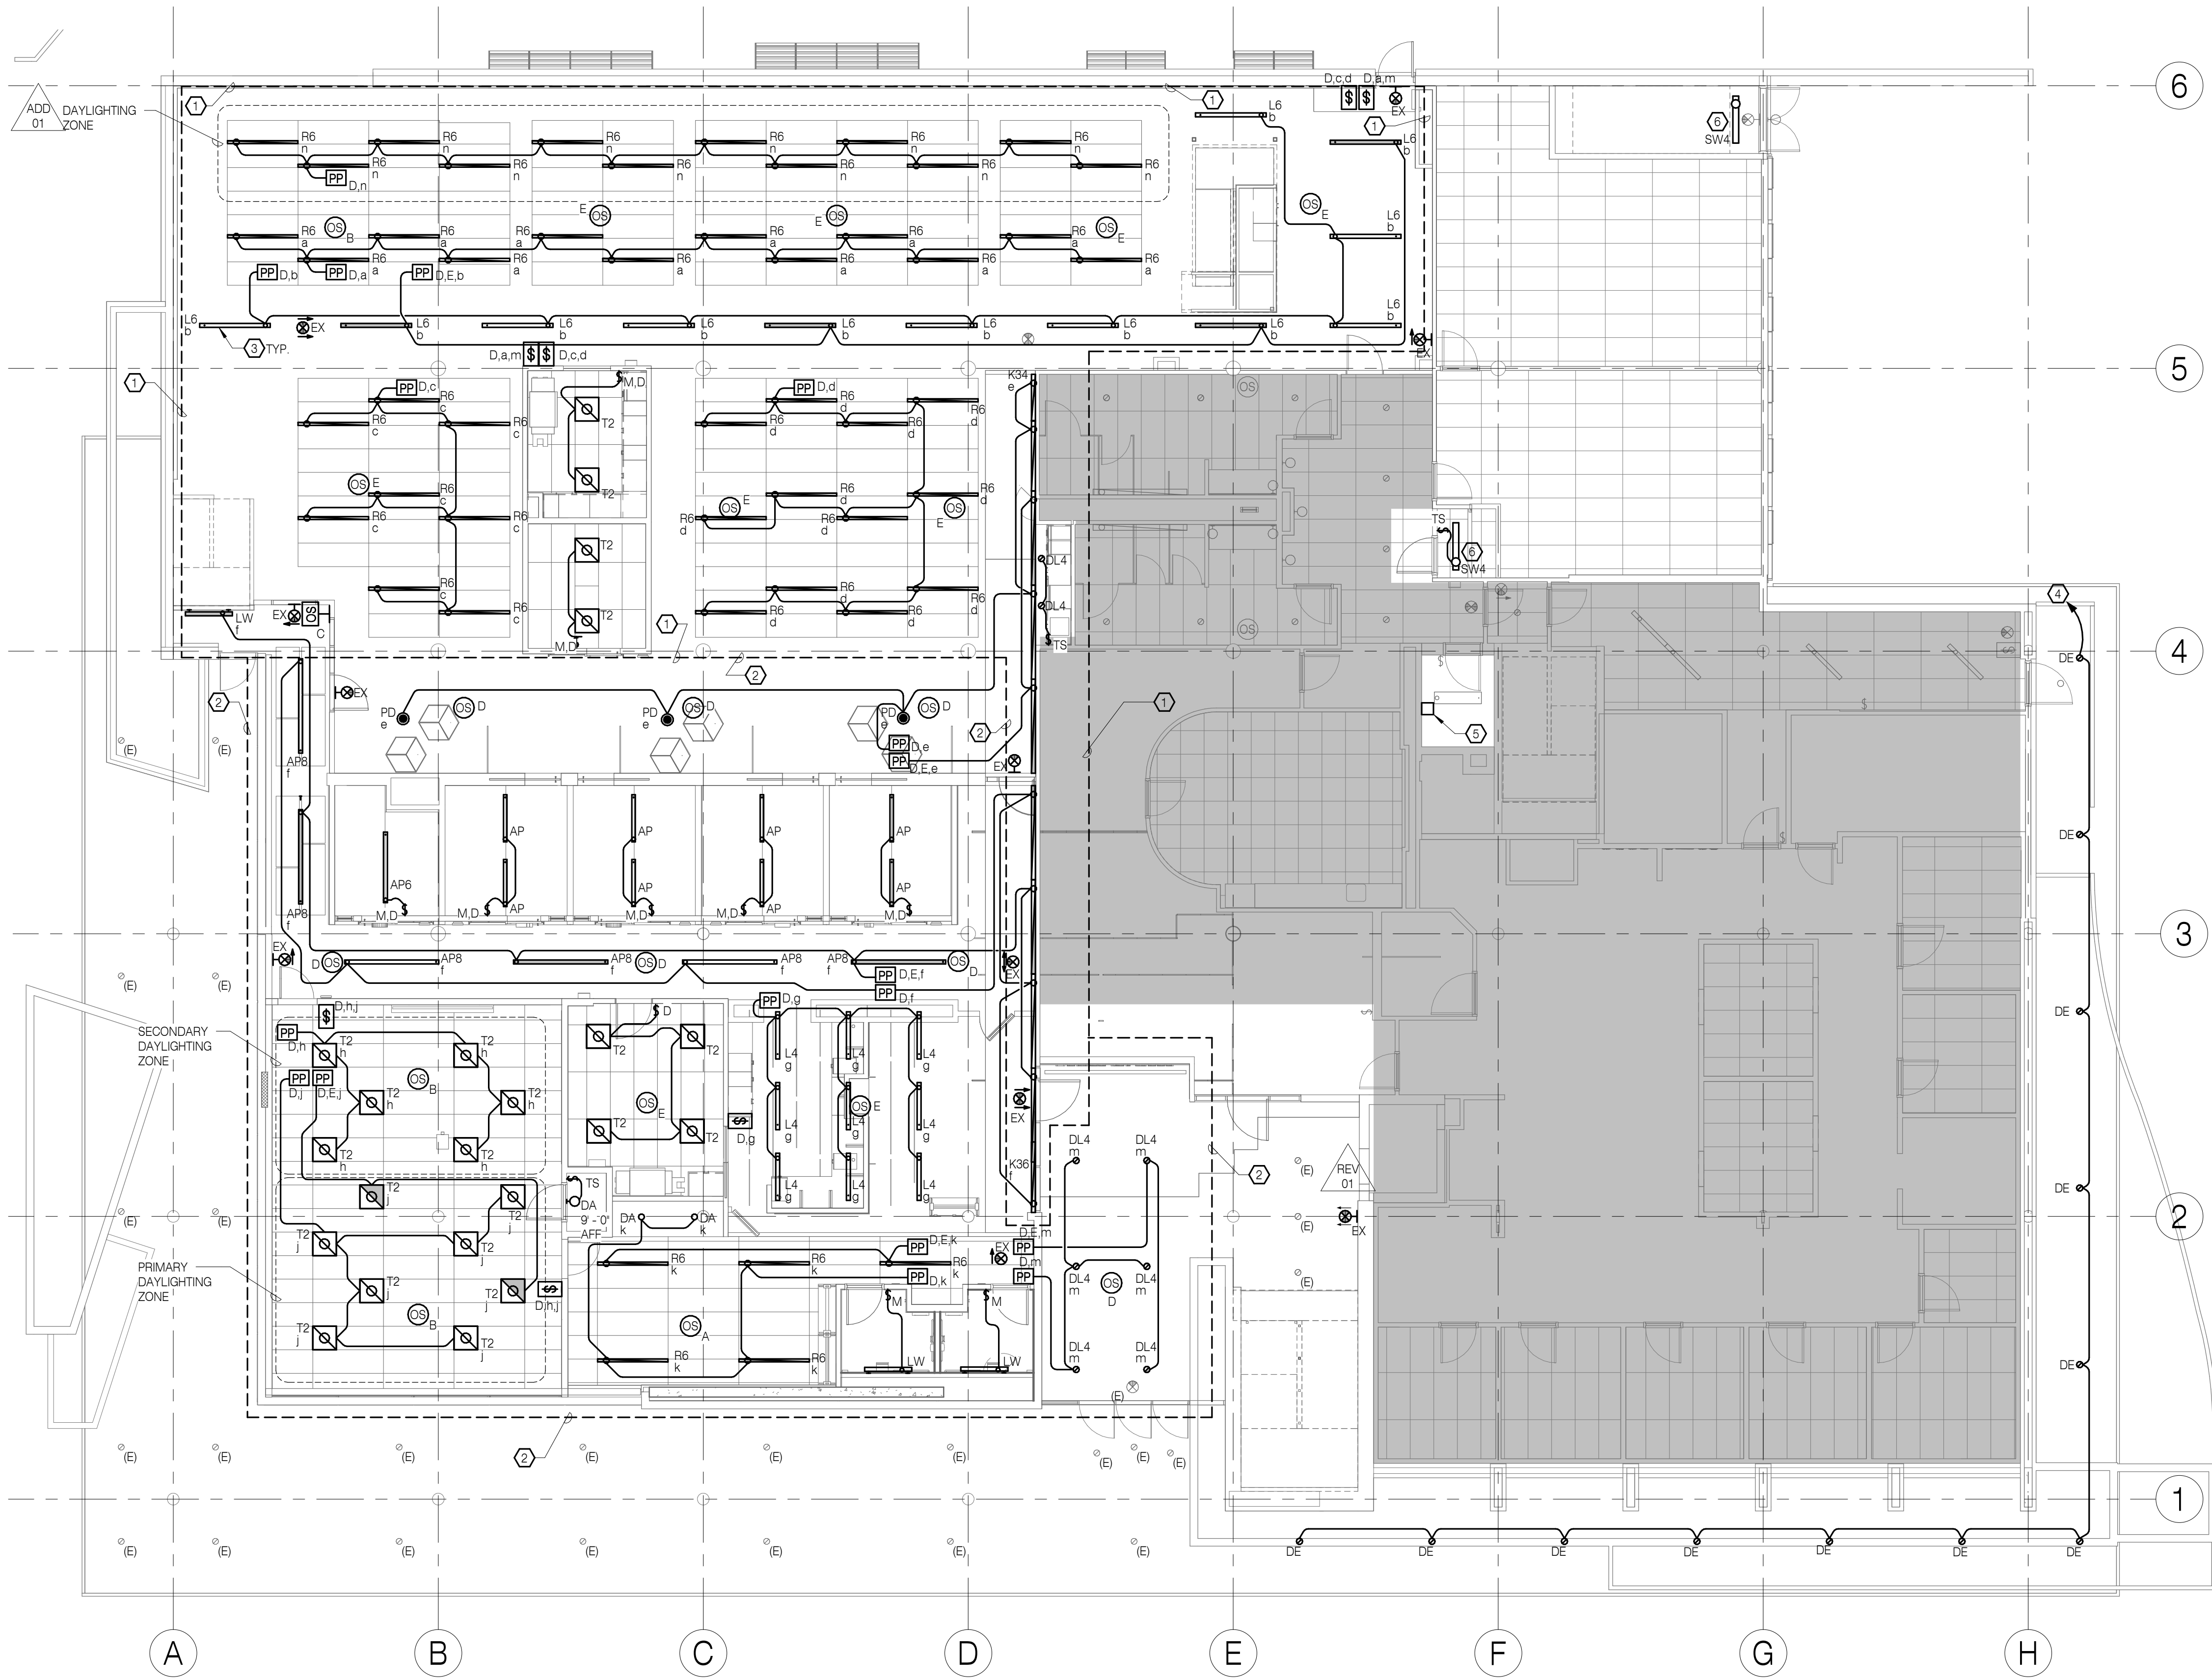

- REFERENCE NOTES:
- 1 CIRCUIT NORMAL LUMINAIRES TO L1-5, EXIT SIGNS TO L1-2 AND EMERGENCY LUMINAIRES TO LIGHTING INVERTER (FIRST FLOOR) CIRCUIT 2 IN THIS AREA.
 - 2 CIRCUIT NORMAL LUMINAIRES TO L1-7, EXIT SIGNS TO L1-2 AND EMERGENCY LUMINAIRES TO LIGHTING INVERTER (FIRST FLOOR) CIRCUIT 2 IN THIS AREA.
 - 3 SUSPEND L6 FIXTURES TO SAME HEIGHT A.F.F. AS ADJACENT R6 FIXTURES IN OPEN OFFICE AREA.
 - 4 CIRCUIT TO L1-9 VIA ASTRONOMICAL TIME CLOCK
 - 5 ASTRONOMICAL TIME CLOCK
 - 6 CONNECT NEW FIXTURE TO CIRCUIT MADE AVAILABLE BY DEMOLITION OF PREVIOUS FIXTURE IN SAME AREA.

PIVOT
ARCHITECTURE

RECORD DRAWING
20 AUGUST 2020

SW
E
SYSTEMS WEST
ENGINEERS
725 A Street
Springfield, OR 97477
541.342.7210
systemswestengineers.com
SWE Proj. No. U003.08

RECORD DRAWINGS
HOMES FOR GOOD OFFICE BUILDING
REMODEL
100 WEST 30TH AVENUE
EUGENE, OR 97401

RECORD DRAWING
NOTE: Documents have been corrected as per data supplied by Contractor and Revision / Change Order Drawings. They do not necessarily show all existing conditions and may not be completely accurate. Field verify existing / hidden conditions prior to commencement of new work.
DATE: AUGUST 20, 2020

SHEET TITLE:
LIGHTING PLAN - FIRST FLOOR


REVISIONS:

#	DESCRP.	DATE
1	ADD 01	05.17.19
2	REV 01	06.14.19

ISSUE DATE: 08/20/2020

E112

1 LIGHTING PLAN - FIRST FLOOR
1/8" = 1'-0"

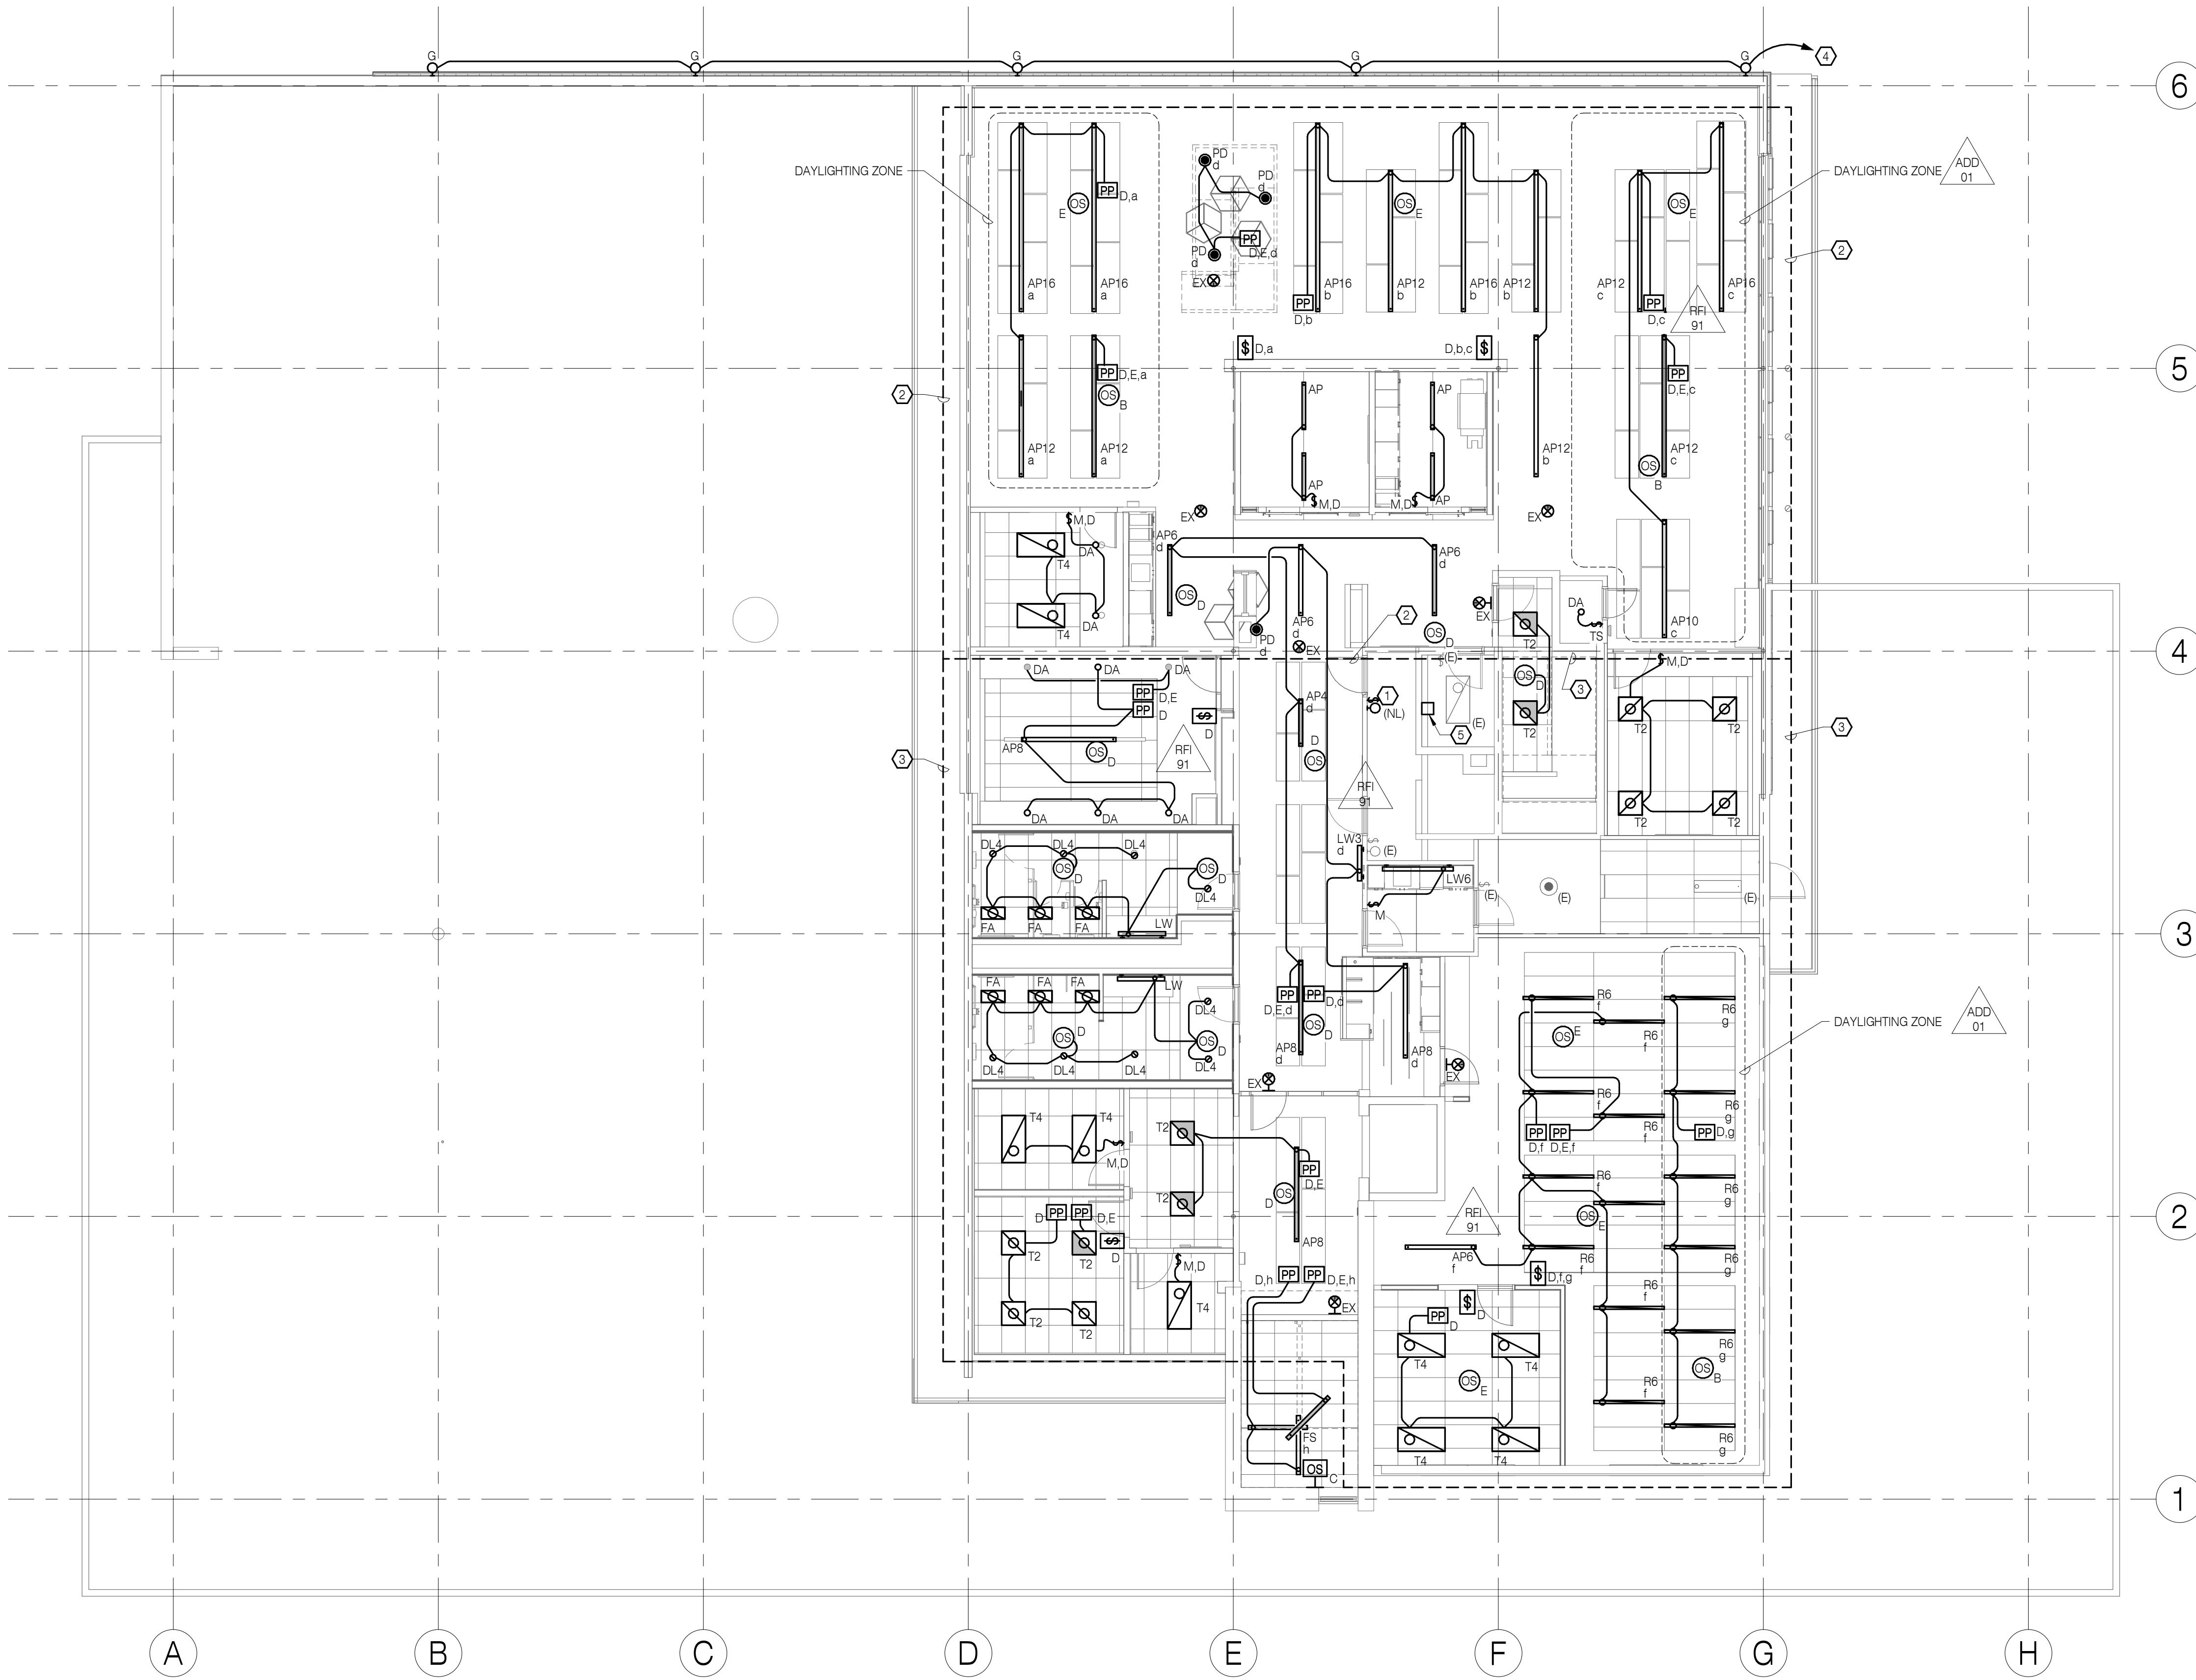

- REFERENCE NOTES:
- 1 REINSTALL FIXTURE AND SWITCH ON NEW WALL. RECONNECT TO CIRCUIT PREVIOUSLY CONNECTED TO DEVICES. INTERCEPT AND EXTEND EXISTING CONDUCTORS AS NECESSARY TO SERVE DEVICE IN NEW LOCATION.
 - 2 CIRCUIT NORMAL LUMINAIRES TO L2-2, EXIT SIGNS TO L2-6 AND EMERGENCY LUMINAIRES TO LIGHTING INVERTER (FIRST FLOOR) CIRCUIT 3 IN THIS AREA.
 - 3 CIRCUIT NORMAL LUMINAIRES TO L2-4, EXIT SIGNS TO L2-6 AND EMERGENCY LUMINAIRES TO LIGHTING INVERTER (FIRST FLOOR) CIRCUIT 3 IN THIS AREA.
 - 4 CIRCUIT TO L2-8 VIA ASTRONOMICAL TIME CLOCK
 - 5 ASTRONOMICAL TIME CLOCK

RECORD DRAWING
20 AUGUST 2020

SW E
SYSTEMS WEST ENGINEERS
725 A Street
Springfield, OR 97477
541.342.7210
systemswestengineers.com
SWE Proj. No. U003.08

RECORD DRAWING
NOTE: Documents have been corrected as per data revision / Change Order Drawings. They do not necessarily show all existing conditions and may not be completely accurate. Field verify existing / hidden conditions prior to commencement of new work.
DATE: AUGUST 20, 2020

RECORD DRAWINGS
HOMES FOR GOOD OFFICE BUILDING REMODEL
100 WEST 30TH AVENUE
EUGENE, OR 97401


SHEET TITLE:
LIGHTING PLAN - SECOND FLOOR

REVISIONS:


#	DESCRP.	DATE
1	ADD 01	05.17.19
12	RFI 91	02.18.20

ISSUE DATE: 08/20/2020

E113

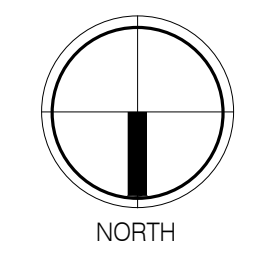

1 LIGHTING PLAN - SECOND FLOOR
1/8" = 1'-0"

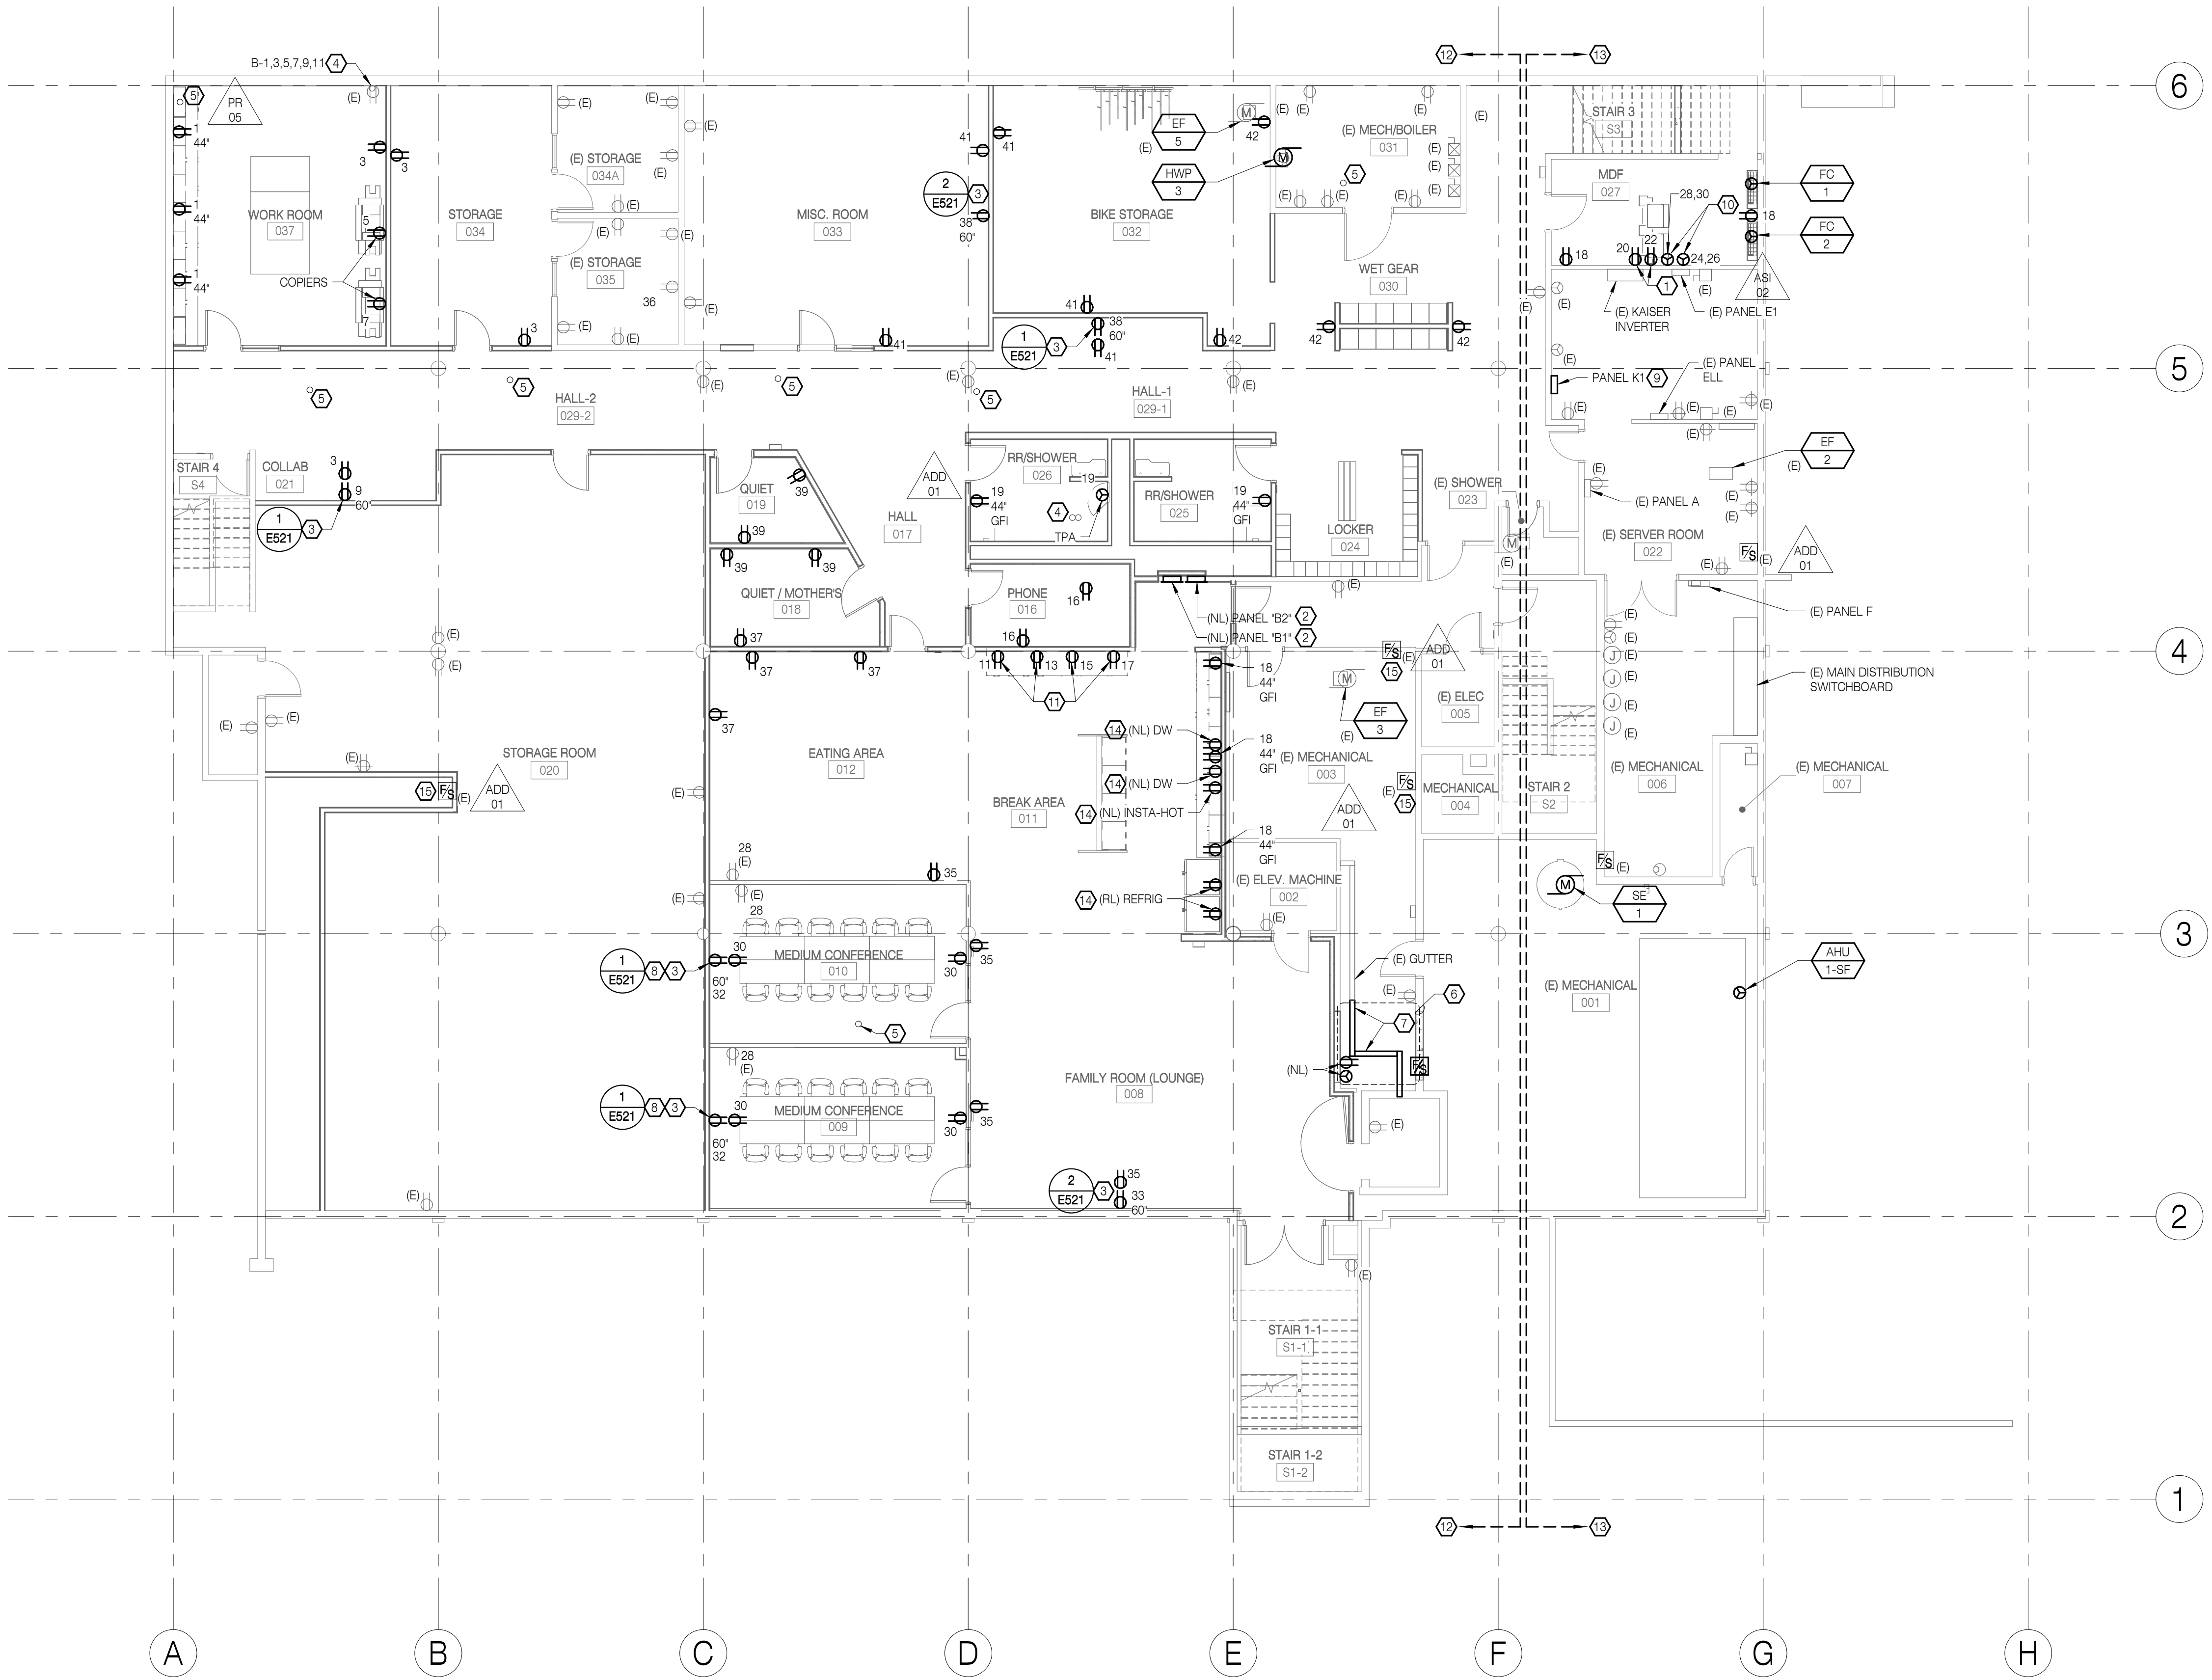

- REFERENCE NOTES:
- 1 PROVIDE (2) 120V RECEPTACLE MOUNTED ON WALL FOR DATA RACKS. COORDINATE RECEPTACLE LOCATIONS WITH OFOI DATA RACKS.
 - 2 PROVIDE NEW FLUSH-MOUNT PANEL TRIM KITS AND RELOCATE EXISTING PANELS IN NEW LOCATION SHOWN.
 - 3 WALL MOUNTED FLAT SCREEN MONITOR. REFERENCE DETAIL INDICATED.
 - 4 EXISTING POWER PENETRATION TO FIRST FLOOR ABOVE
 - 5 NEW POWER PENETRATION TO FIRST FLOOR ABOVE TO SERVE SYSTEMS FURNITURE
 - 6 REINSTALL FIXTURES IN PREVIOUS AREA FOLLOWING REPLACEMENT OF WALL. RECONNECT TO CIRCUITS AND LOADS PREVIOUSLY CONNECTED TO DEVICES.
 - 7 REPLACE PORTION OF EXISTING GUTTER REMOVED DURING DEMOLITION. INTERCEPT AND EXTEND CONDUCTORS TO REPLACE CIRCUITING REMOVED DURING DEMOLITION.
 - 8 PROVIDE FSR PWB-FR-450 FIRE RATED WALL BOX AT THIS LOCATION.
 - 9 NEW PANELBOARD. PROVIDE PLYWOOD AS REQUIRED FOR MOUNTING.
 - 10 PROVIDE (2) 208V, 30A, 1PH RECEPTACLES TO SERVE FUTURE UPS AT DATA RACKS. COORDINATE CONFIGURATION, LOCATION, AND ELEVATION WITH ARCHITECT AND OWNERS REPRESENTATIVE FOR NEW OFOI RACK.
 - 11 MICROWAVE OVEN RECEPTACLES AT 44" AFF
 - 12 NEW FIRE/SMOKE DAMPERS IN THIS AREA ARE ASSIGNED TO PANEL 'A' CIRCUIT 38. OTHER NEW CIRCUITS SHOWN IN THIS AREA ARE ASSIGNED TO PANEL B-1 U.O.N.
 - 13 NEW CIRCUITS SHOWN IN THIS AREA ARE ASSIGNED TO PANEL 'A' U.O.N.
 - 14 REINSTALL FIXTURES IN PREVIOUS AREA FOLLOWING CONSTRUCTION OF FIRE RATED WALL. RECONNECT TO CIRCUITS PREVIOUSLY SERVING FIXTURES. EXTEND CIRCUITS AS NECESSARY.
 - 15 RECONNECT POWER TO EXISTING DAMPER. COORDINATE WITH MECHANICAL. REFERENCE 1/M121.

RECORD DRAWING
 NOTE: Documents have been corrected as per data supplied by Contractor and Revision / Change Order Drawings. They do not necessarily show all existing conditions and may not be completely accurate. Field verify existing / hidden conditions prior to commencement of new work.
 DATE: AUGUST 20, 2020

PIVOT
 ARCHITECTURE
RECORD DRAWING
 20 AUGUST 2020

SW E
 SYSTEMS WEST ENGINEERS
 725 A Street
 Springfield, OR 97477
 541.342.7210
 systemswestengineers.com
 SWE Proj. No. U003.08

RECORD DRAWINGS
HOMES FOR GOOD OFFICE BUILDING
REMODEL
 100 WEST 10TH AVENUE
 EUGENE, OR 97401


SHEET TITLE:
POWER PLAN - LOWER LEVEL

REVISIONS:


#	DESCRP.	DATE
1	ADD 01	05.17.19
4	ASI 02	07.24.19
8	PR 05	09.16.19

ISSUE DATE: 08/20/2020

E121

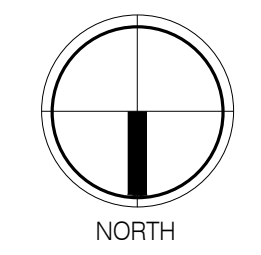

1 POWER PLAN - LOWER LEVEL
 1/8" = 1'-0"

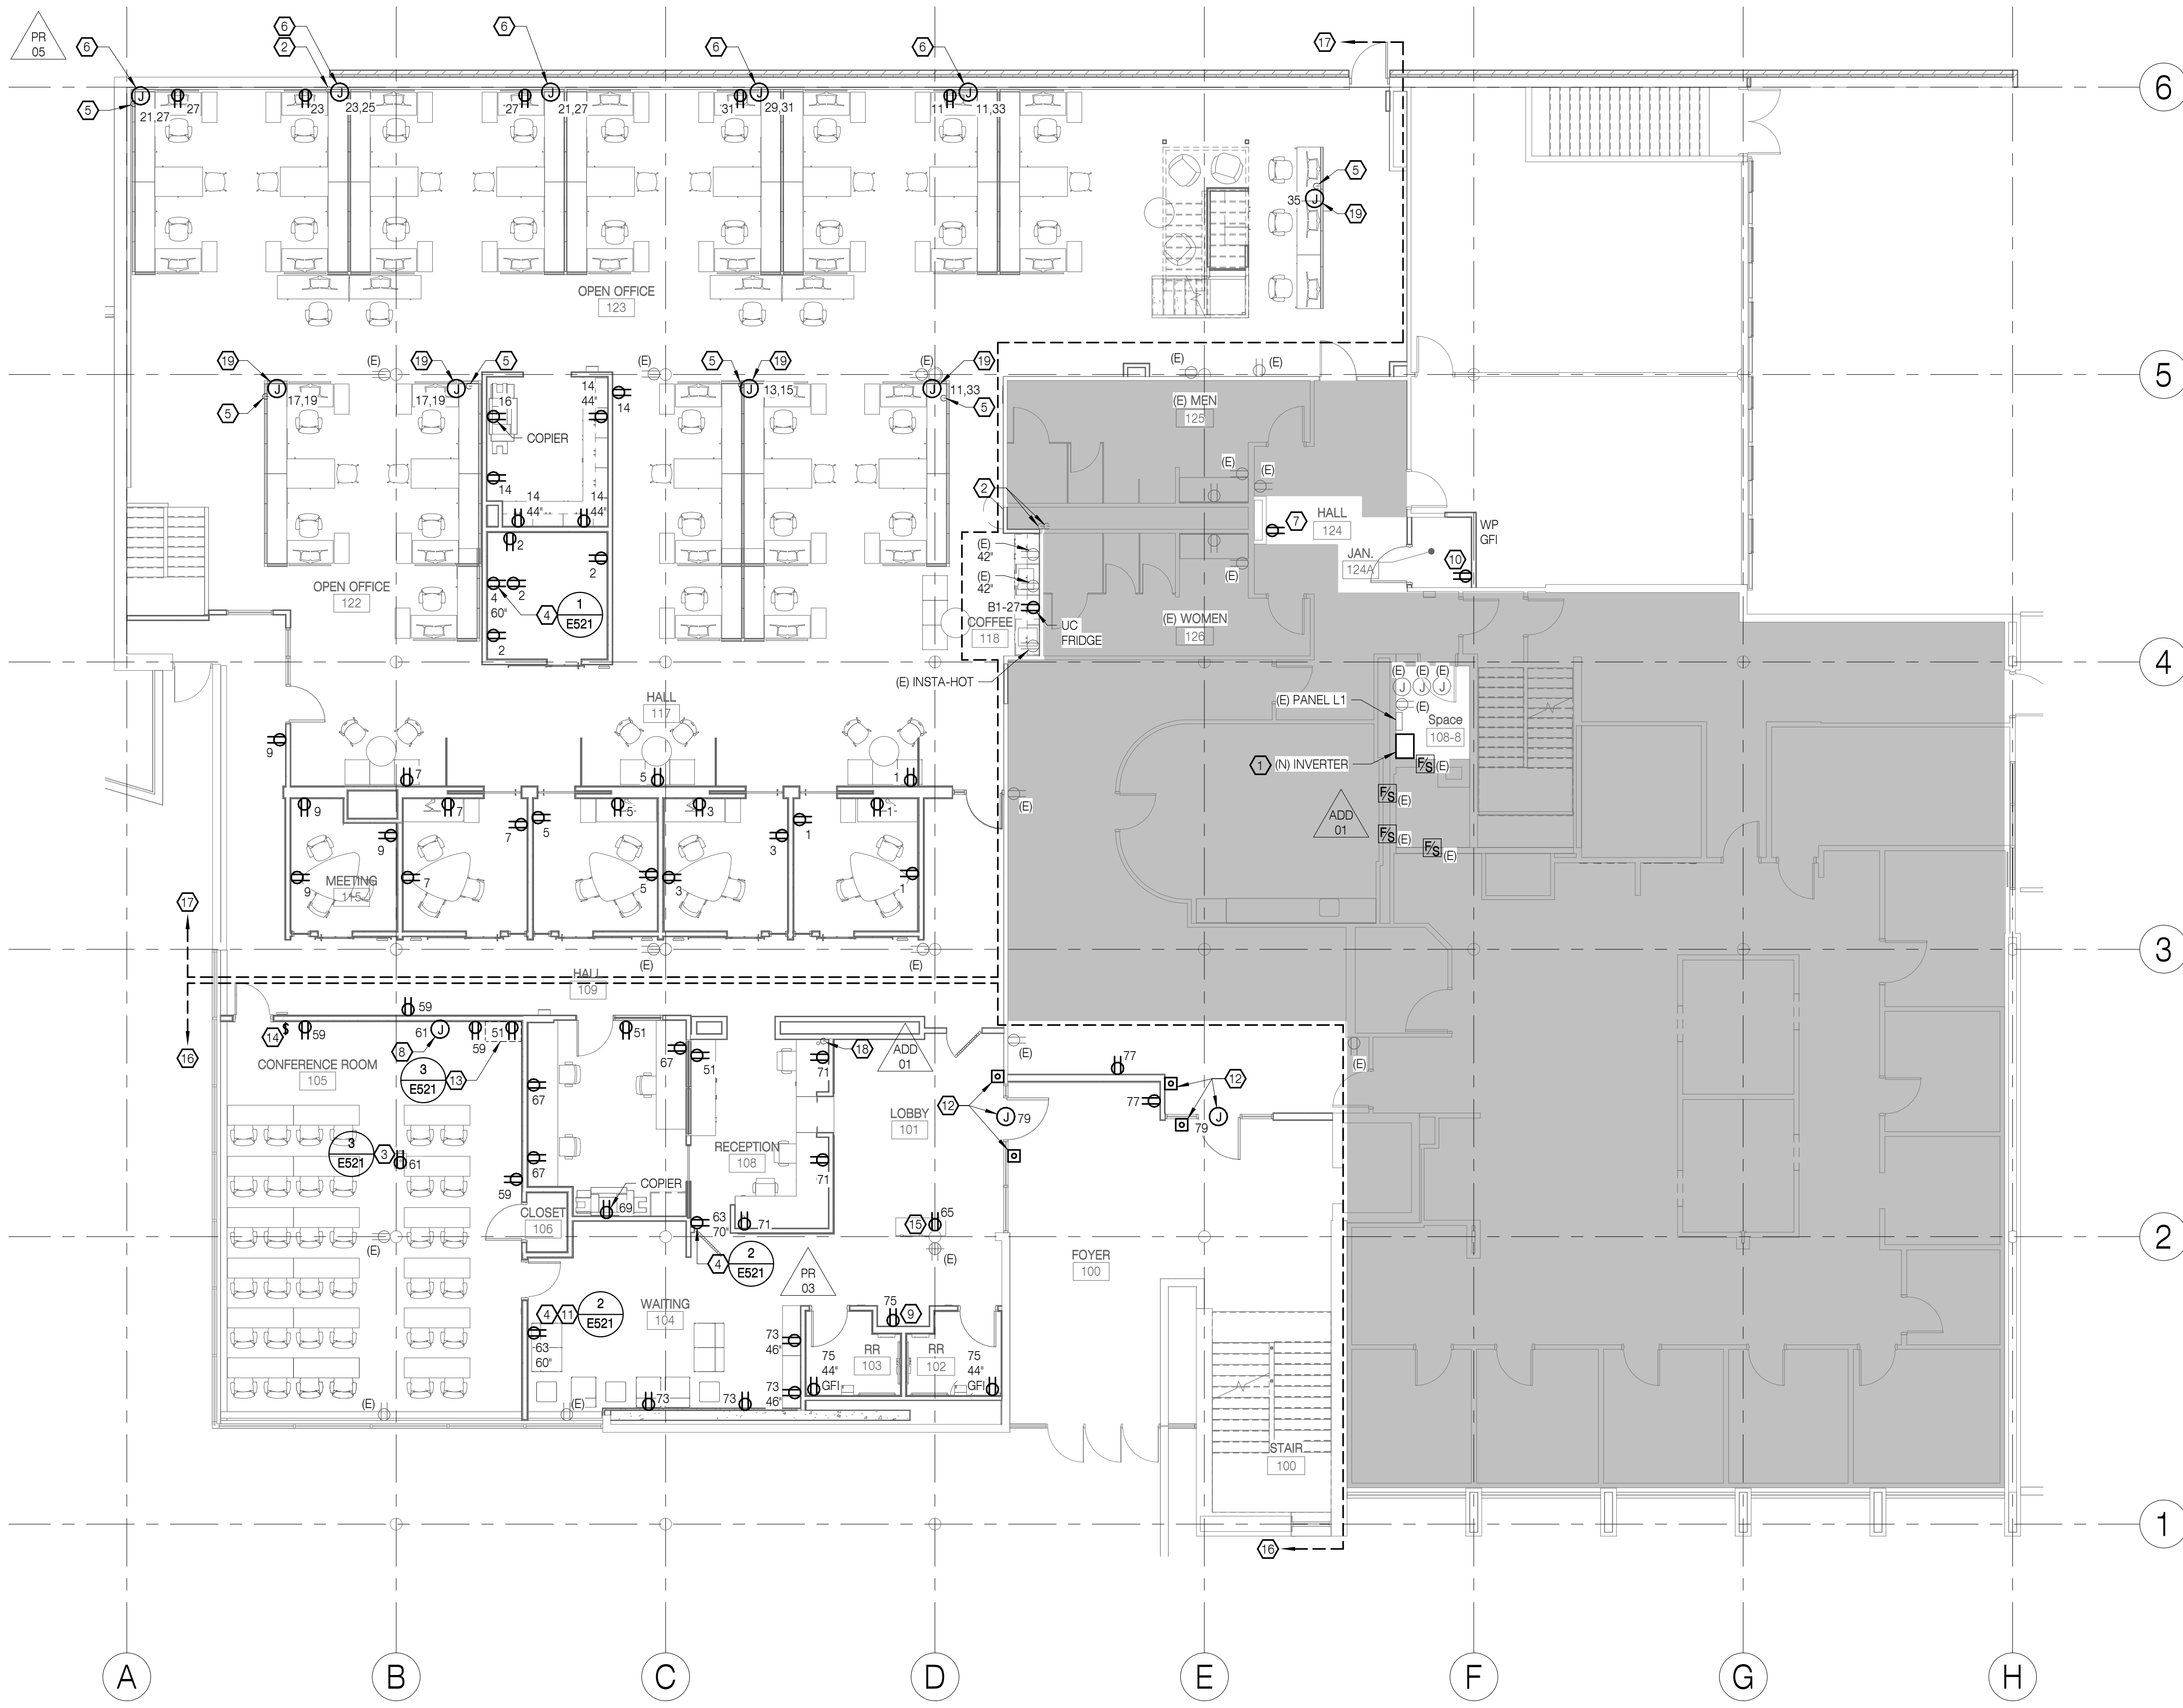

1 POWER PLAN - FIRST FLOOR
1/8" = 1'-0"

- REFERENCE NOTES:
- 1 REPLACE EXISTING LIGHTING INVERTER WITH NEW INVERTER. BASIS OF DESIGN: MEYERS ILLUMINATOR IE SERIES 3.0 KW 120/120.
 - 2 EXISTING POWER PENETRATION FROM LOWER LEVEL.
 - 3 CEILING MOUNTED PROJECTOR. REFERENCE DETAIL INDICATED. COORDINATE LOCATION AND CONFIGURATION WITH ARCHITECT.
 - 4 WALL MOUNTED FLAT SCREEN MONITOR. REFERENCE DETAIL INDICATED.
 - 5 NEW POWER PENETRATION FROM LOWER LEVEL TO SERVE SYSTEMS FURNITURE.
 - 6 PROVIDE POWER CONNECTION TO SYSTEMS FURNITURE. COORDINATE LOCATION AND CONFIGURATION WITH FURNITURE EQUIPMENT SUPPLIER AND ARCHITECTURAL.
 - 7 NEW WATER COOLER. CONNECT TO EXISTING CIRCUIT MADE AVAILABLE BY DEMOLITION OF EXISTING COOLER. COORDINATE LOCATION AND CONFIGURATION WITH PLUMBING. REFERENCE 1/P112.
 - 8 JUNCTION BOX FOR ON WALL ABOVE ACCESSIBLE CEILING FOR MOTORIZED PROJECTOR SCREEN. COORDINATE LOCATION AND ELEVATION WITH ARCHITECT PRIOR TO ROUGH-IN.
 - 9 NEW WATER COOLER.
 - 10 CONNECT RECEPTACLE TO CIRCUIT MADE AVAILABLE DURING DEMOLITION.
 - 11 PROVIDE FSR PWB-FR-450 FIRE RATED WALL BOX AT THIS LOCATION.
 - 12 MOTORIZED ADA DOOR OPERATOR. PROVIDE POWER AS SHOWN TO CONTROLLER BY OTHERS. PROVIDE 4-SQUARE BOX FOR PUSHBUTTON LOCATION WITH PATHWAY TO ACCESSIBLE CEILING FOR CONNECTION TO DOOR CONTROLLER. COORDINATE WITH EQUIPMENT INSTALLER.
 - 13 AV CABINET. REFERENCE DETAIL INDICATED AND COORDINATE LOCATION AND CONNECTION REQUIREMENTS WITH ARCHITECT PRIOR TO ROUGH-IN.
 - 14 MOTORIZED PROJECTOR SCREEN CONTROL. COORDINATE LOCATION AND CONNECTION REQUIREMENTS WITH ARCHITECT PRIOR TO ROUGH-IN.
 - 15 CLIENT SELF CHECK-IN IPAD. CONNECT NEW RECEPTACLE TO CIRCUIT SERVING EXISTING RECEPTACLE ELSEWHERE ON COLUMN.
 - 16 NEW FIRE/SMOKE DAMPERS IN THIS AREA ARE ASSIGNED TO PANEL 'A' CIRCUIT 40. OTHER NEW CIRCUITS SHOWN IN THIS AREA ARE ASSIGNED TO PANEL 'B'-2 U.O.N.
 - 17 NEW FIRE/SMOKE DAMPERS IN THIS AREA ARE ASSIGNED TO PANEL 'A' CIRCUIT 40. OTHER NEW CIRCUITS SHOWN IN THIS AREA ARE ASSIGNED TO PANEL 'A' U.O.N.
 - 18 NEW POWER PENETRATION FROM LOWER LEVEL TO SERVE RECEPTION DESK.
 - 19 PROVIDE JUNCTION BOX MOUNTED TO BOTTOM OF STRUCTURE BELOW FOR CONNECTION TO SYSTEMS FURNITURE. COORDINATE LOCATION WITH FURNITURE EQUIPMENT SUPPLIER AND ARCHITECTURAL.

RECORD DRAWING
NOTE: Documents have been corrected as per data supplied by Contractor and Revision / Change Order Drawings. They do not necessarily show all existing conditions and may not be completely accurate. Field verify existing / hidden conditions prior to commencement of new work.
DATE: AUGUST 20, 2020

PIVOT
ARCHITECTURE

RECORD DRAWING
20 AUGUST 2020

SW E
SYSTEMS WEST ENGINEERS
725 A Street
Springfield, OR 97477
541.342.7210
systemswestengineers.com
SWE Proj. No. U003.08

RECORD DRAWINGS
HOMES FOR GOOD OFFICE BUILDING
REMODEL
100 WEST 10TH AVENUE
EUGENE, OR 97401

SHEET TITLE:
POWER PLAN - FIRST FLOOR

REVISIONS:

#	DESCRIP.	DATE
1	ADD 01	05.17.19
5	PR 03	08.13.19
8	PR 05	09.16.19

ISSUE DATE: 08/20/2020

E122




- SHEET NOTES:**
1. LOCATION OF ALL EXISTING DEVICES TO BE RETAINED IS APPROXIMATE AND MUST BE FIELD VERIFIED. REFERENCE 1/E103. COORDINATE WITH ARCHITECTURAL.
- REFERENCE NOTES:**
- 1 WALL MOUNTED FLAT SCREEN MONITOR. REFERENCE DETAIL INDICATED.
 - 2 NEW WATER COOLER. CONNECT TO EXISTING CIRCUIT MADE AVAILABLE BY DEMOLITION OF EXISTING COOLER. COORDINATE LOCATION AND CONFIGURATION WITH PLUMBING. REFERENCE 1/P113.
 - 3 PROVIDE (1) 120V RECEPTACLE MOUNTED ON WALL. COORDINATE EXACT LOCATION WITH OWNERS REPRESENTATIVE AND ARCHITECT.
 - 4 PROVIDE POWER CONNECTION TO SYSTEMS FURNITURE. COORDINATE LOCATION AND CONFIGURATION WITH ARCHITECT.
 - 5 PROVIDE JUNCTION BOX ABOVE CEILING LEVEL FOR FUTURE ROOM RESERVATION SYSTEM CONNECTION. COORDINATE LOCATION AND CONNECTION REQUIREMENTS WITH ARCHITECT PRIOR TO ROUGH-IN.
 - 6 PROVIDE 208V, 20A, 1PH RECEPTACLE TO SERVE FUTURE UPS AT DATA RACKS. COORDINATE CONFIGURATION, LOCATION, AND ELEVATION FOR NEW OFOI DATA RACK WITH OWNERS REPRESENTATIVE AND ARCHITECT.
 - 7 WIREMOLD AT 1' - 6" AFF ON BRICK OR CMU WALLS
 - 8 ROUTE WIREMOLD VERTICALLY TO ACCESSIBLE CEILING ABOVE.
 - 9 RECEPTACLES ABOVE REPAIR COUNTER AT +46" AFF. COORDINATE LOCATION AND ELEVATION WITH ARCHITECT.
 - 10 EXISTING PHOTOVOLTAIC COMBINER PANEL.
 - 11 CONNECT NEW FIXTURE TO EXISTING CIRCUIT SERVING NEARBY EXISTING GENERAL RECEPTACLES IN ELECTRICAL ROOM.
 - 12 PROVIDE FLOOR POKE-THROUGH. REFERENCE 1/E133. COORDINATE LOCATION AND CONFIGURATION WITH EQUIPMENT SUPPLIER AND ARCHITECTURAL.
 - 13 REINSTALL EXISTING RECEPTACLE ON FACE OF ACOUSTICAL PANEL. EXTEND WIRING AS NECESSARY.
 - 14 NEW FIRE/SMOKE DAMPERS IN THIS AREA ARE ASSIGNED TO PANEL 'D' CIRCUIT 21. OTHER NEW CIRCUITS SHOWN IN THIS AREA ARE ASSIGNED TO PANEL 'C' U.O.N.
 - 15 NEW FIRE/SMOKE DAMPERS IN THIS AREA ARE ASSIGNED TO PANEL 'D' CIRCUIT 21. OTHER NEW CIRCUITS SHOWN IN THIS AREA ARE ASSIGNED TO PANEL 'D' U.O.N.
 - 16 RECONNECT POWER TO EXISTING DAMPERS. COORDINATE WITH MECHANICAL. REFERENCE 1/M123.
 - 17 RECONNECT POWER TO EXHAUST FAN EF-1 FOLLOWING REFURBISHMENT. COORDINATE WITH MECHANICAL.


RECORD DRAWING
 NOTE: Documents have been corrected as per data supplied by Contractor and Revision / Change Order Drawings. They do not necessarily show all existing conditions and may not be completely accurate. Field verify existing / hidden conditions prior to commencement of new work.
 DATE: AUGUST 20, 2020

REVISIONS:

#	DESCRP.	DATE
1	ADD 01	05.17.19
4	ASI 02	07.24.19
8	PR 05	09.16.19
11	PR 06	12.03.19

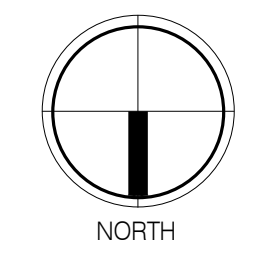

1 POWER PLAN - SECOND FLOOR
 1/8" = 1'-0"

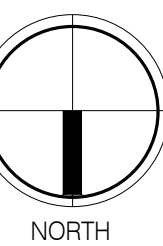

A

B

C

D

E

F

G

H

1


2

3

4

5

6

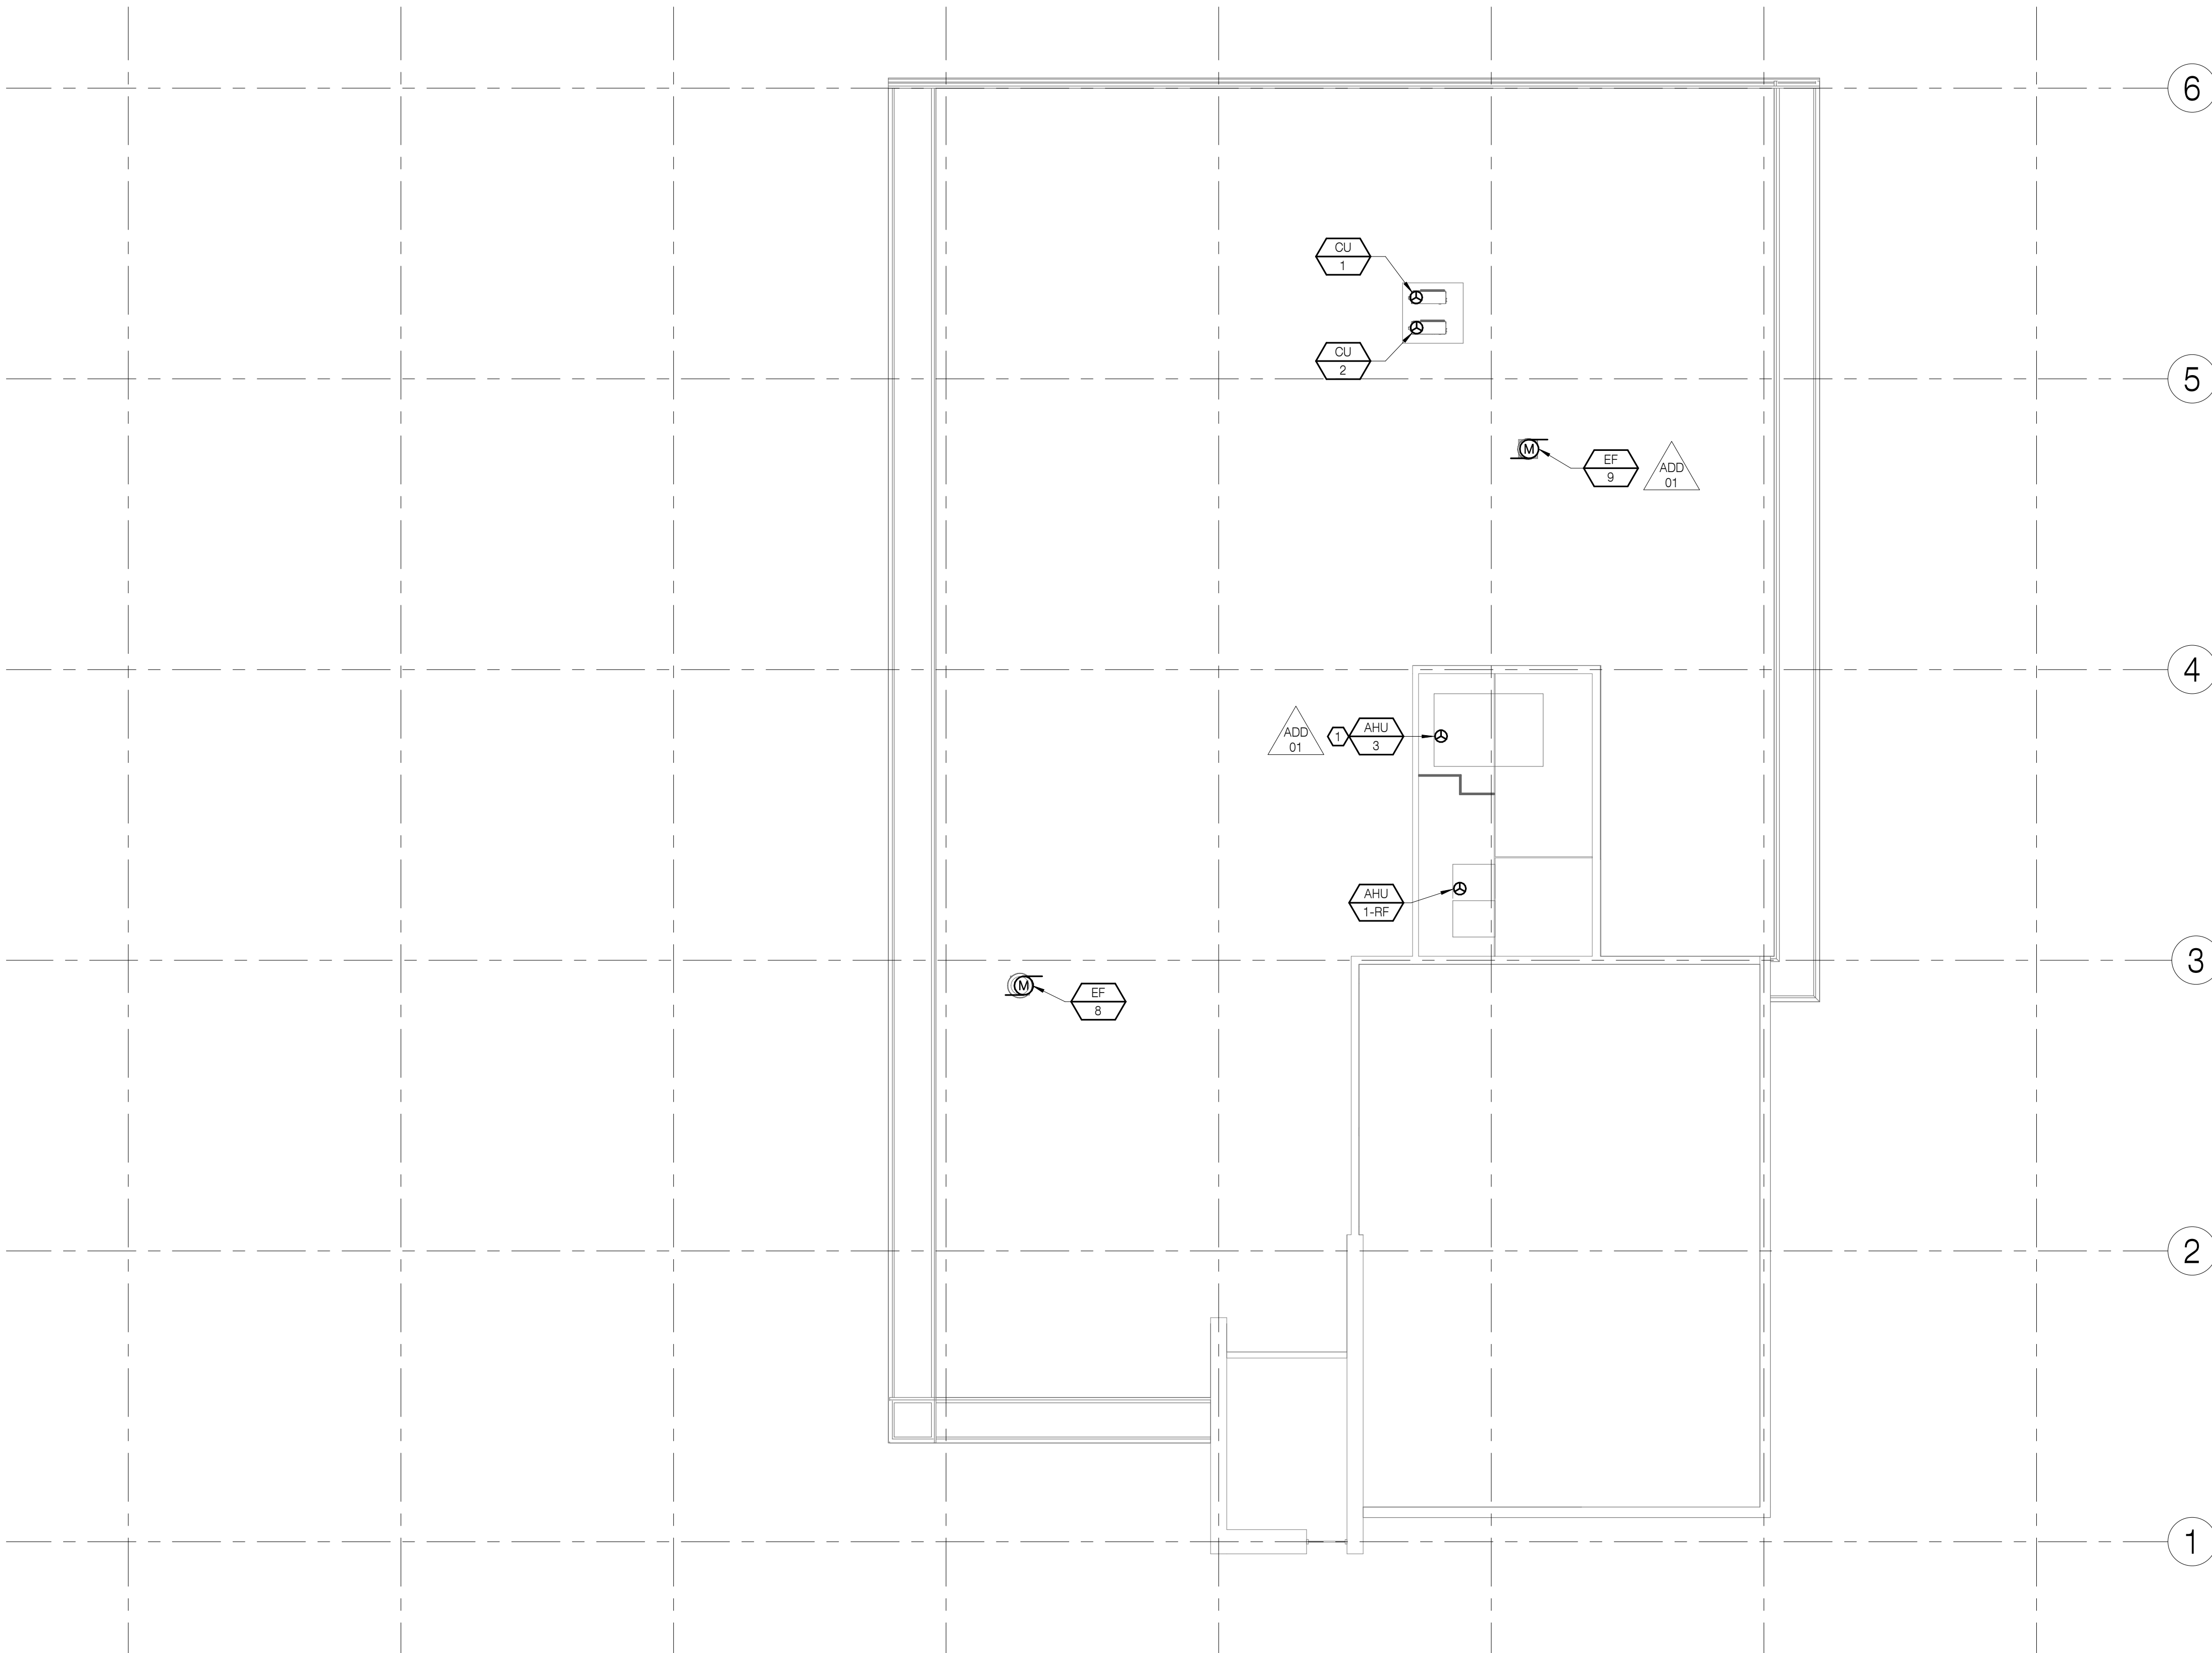

REFERENCE NOTES:

ADD 01 1 TEMPORARY UNIT SERVING CLINIC. PROVIDE TEMPORARY POWER TO UNIT DURING CONSTRUCTION AND DISCONNECT POWER FOLLOWING CONSTRUCTION. COORDINATE WITH MECHANICAL. REFERENCE 51M531 AND MECHANICAL EQUIPMENT CONNECTION SCHEDULE.


RECORD DRAWING
NOTE: Documents have been corrected as per data supplied by Contractor and Revision / Change Order Drawings. They do not necessarily show all existing conditions and may not be completely accurate. Field verify existing / hidden conditions prior to commencement of new work.
DATE: AUGUST 20, 2020

SHEET TITLE:
POWER PLAN - SECOND FLOOR ROOF

REVISIONS:

#	DESCRP.	DATE
1	ADD 01	05.17.19

ISSUE DATE: 08/20/2020

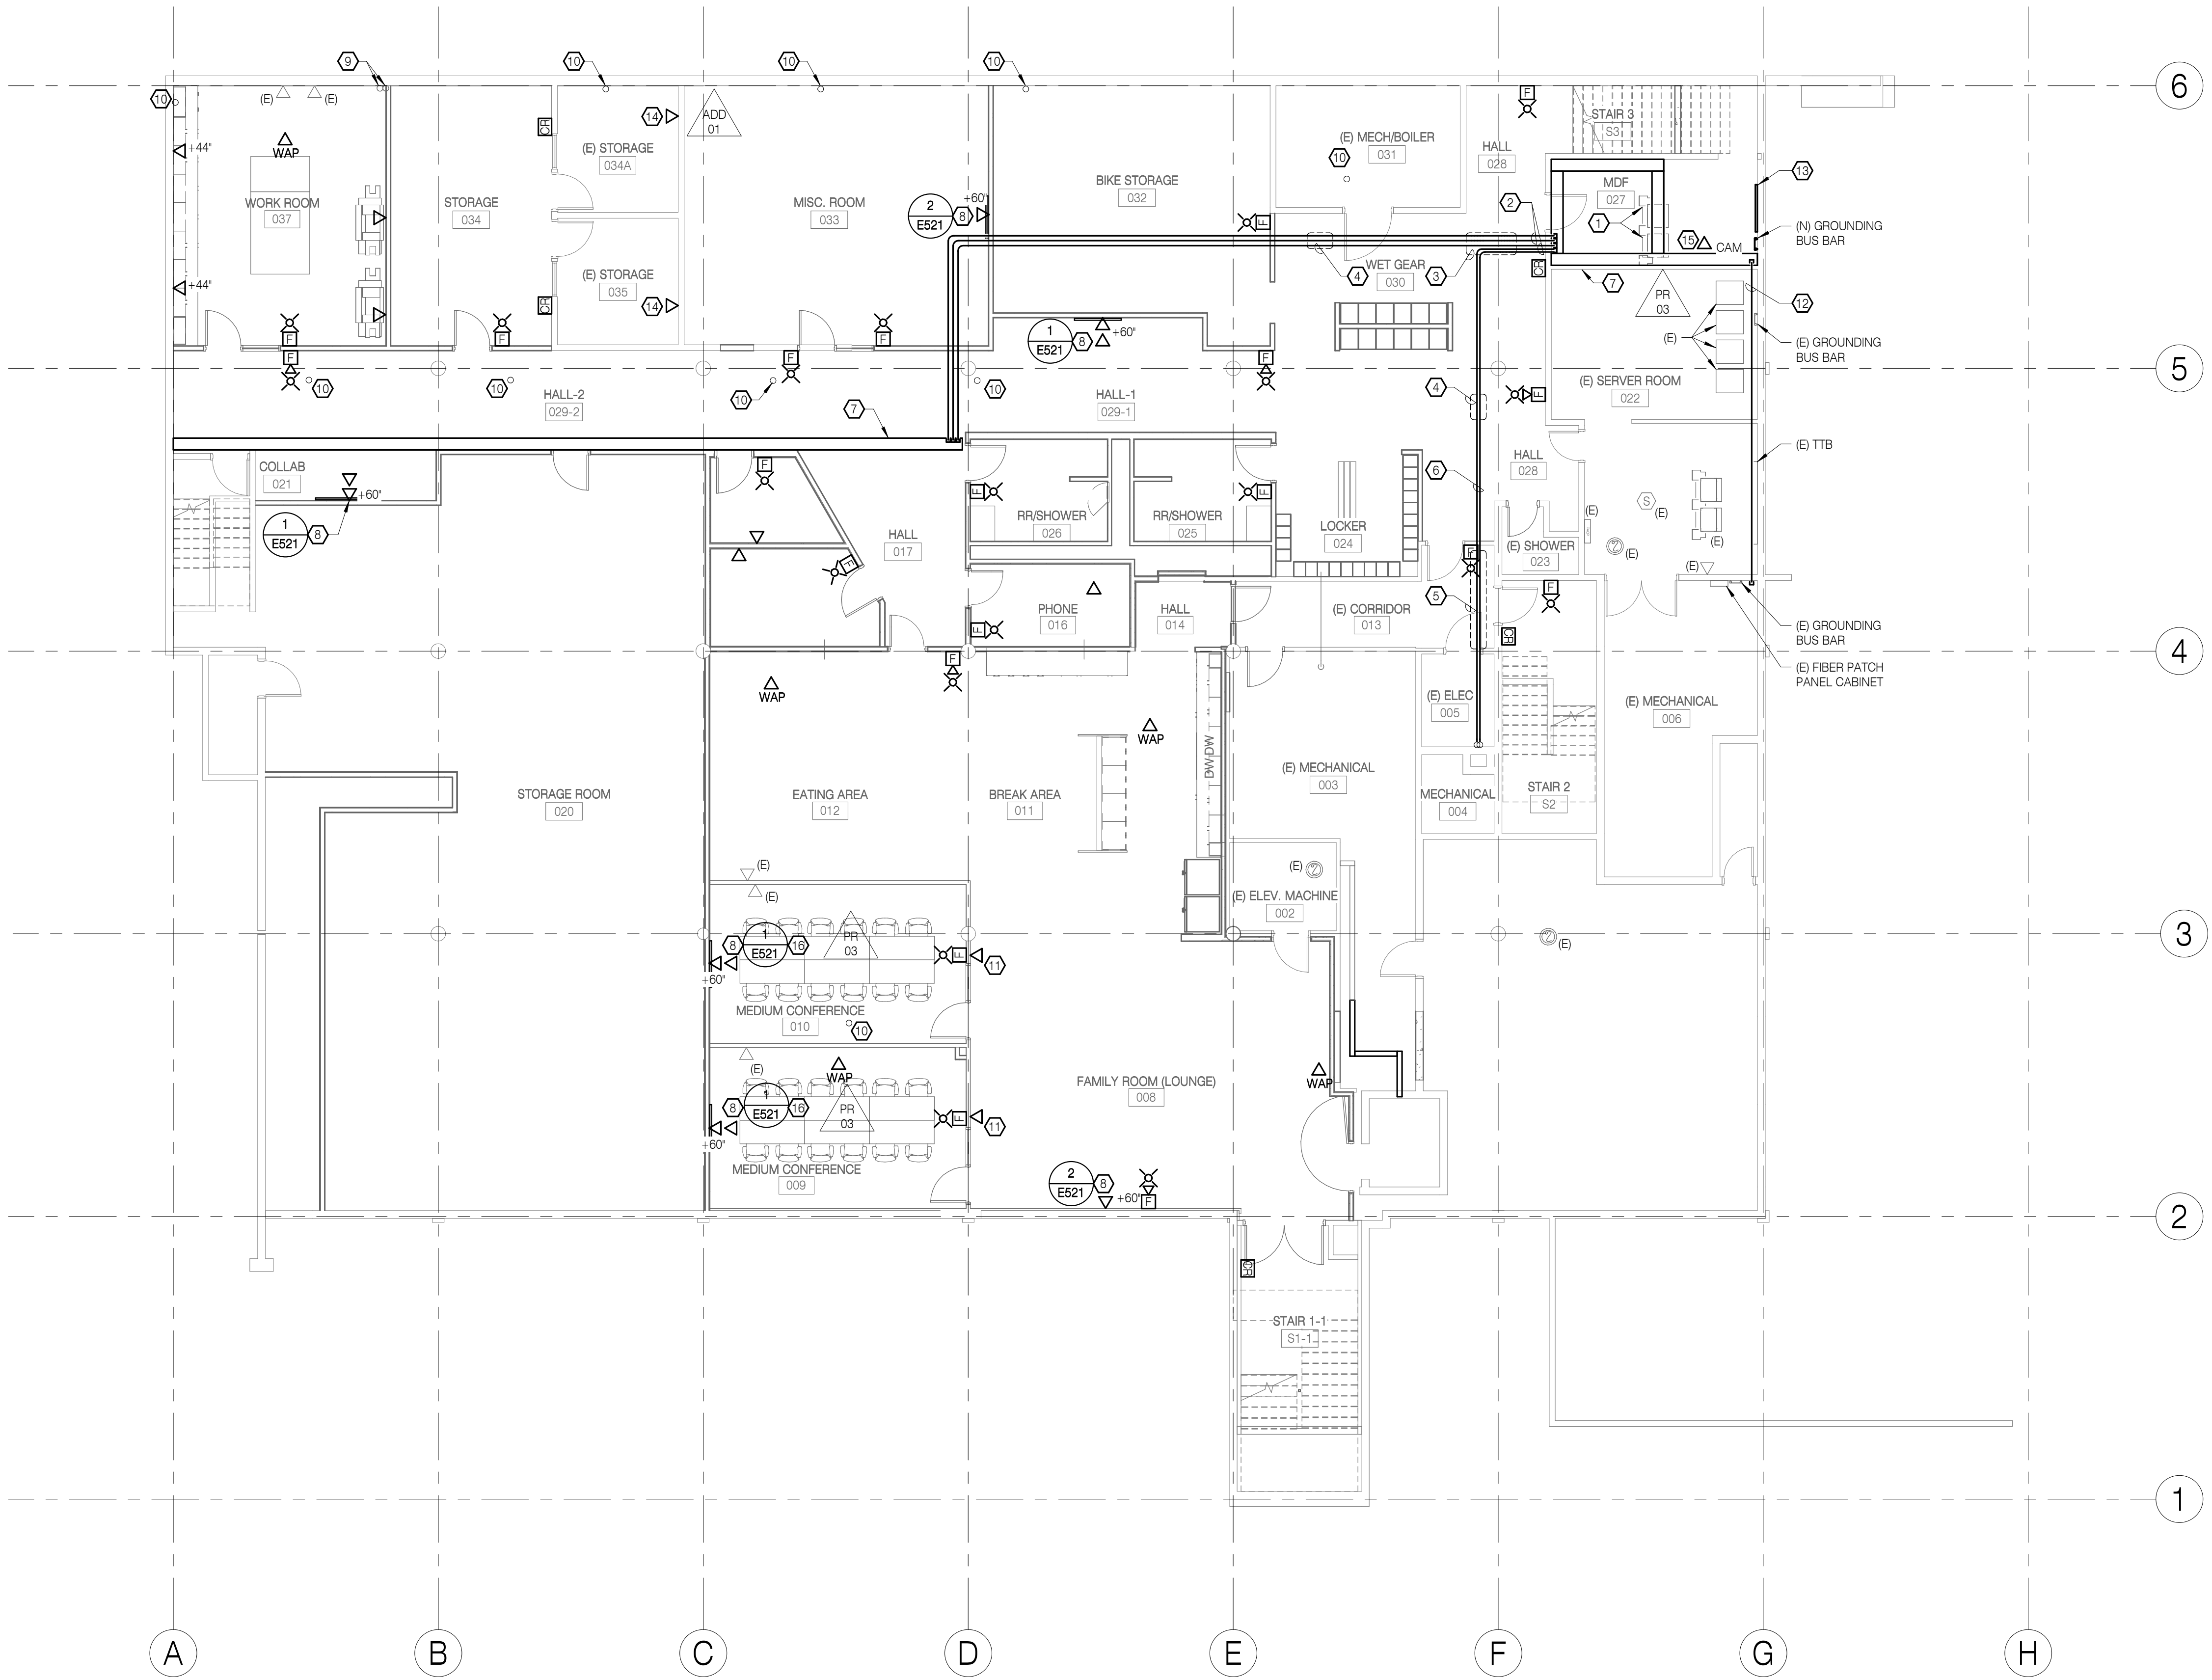

SHEET NOTES:

1. ROUTE CABLE TRAY UNDER OR AROUND DUCTWORK AND PIPES AS NECESSARY. COORDINATE INSTALLATION WITH ARCHITECT PRIOR TO ROUGH-IN.

REFERENCE NOTES:

- ① (2) NEW FOUR-POST DATA RACKS, 0FOI.
- ② (3) 3" AND (2) 2" CONDUIT PENETRATIONS FROM MDF ROOM AT 7' - 6" AFF
- ③ BEND CONDUITS UPWARD FROM 7' - 6" AFF AT MDF ROOM TO MOUNT TIGHT TO STRUCTURE AS SOON AS PRACTICAL IN THIS AREA.
- ④ ROUTE CONDUITS ABOVE EXISTING DUCTWORK IN THIS AREA.
- ⑤ REMOVE AND REPLACE FIRE-RATED CEILING FOR INSTALLATION OF CONDUITS ABOVE CEILING.
- ⑥ (2) 2" CONDUITS CONTINUE TO 2ND FLOOR ELECTRICAL ROOM. PROVIDE 12-STRAND SINGLE MODE FIBER AND (12) CAT 6 CABLES. REFERENCE 1/E132 AND 1/E133.
- ⑦ 12' x 4" LADDER RACK STYLE CABLE TRAY AT 8' - 1" AFF
- ⑧ WALL MOUNTED FLAT SCREEN MONITOR. REFERENCE DETAIL INDICATED.
- ⑨ EXISTING DATA PENETRATION TO FIRST FLOOR ABOVE
- ⑩ NEW DATA PENETRATION TO FIRST FLOOR ABOVE. REFERENCE 1/E132.
- ⑪ PROVIDE DATA RECEPTACLE AT +48" A.F.F. FOR FUTURE ROOM RESERVATION SYSTEM CONNECTION. COORDINATE LOCATION AND CONNECTION REQUIREMENTS WITH ARCHITECT PRIOR TO ROUGH-IN.
- ⑫ PROVIDE 2" C. FOR FIBER FROM PATCH PANEL CABINET IN SERVER ROOM TO MDF ROOM.
- ⑬ NEW TELEPHONE TERMINAL BOARD. PROVIDE 3/4" PLYWOOD COATED WITH FIRE RETARDANT PAINT. COORDINATE LOCATION AND CONFIGURATION REQUIREMENTS WITH ARCHITECT PRIOR TO ROUGH-IN.
- ⑭ PROVIDE NEW DATA OUTLETS IN EXISTING LOCATIONS TO SERVE SECURE COMPUTERS IN STORAGE ROOMS. PROVIDE CABLING THROUGH EXISTING PATHWAY TO NEW CABLE TRAY IN HALL 029-2 AND CONTINUE TO MDF ROOM 027.
- ⑮ INTERIOR CAMERA LOCATION: PROVIDE ROUGH IN FOR CAMERA. PROVIDE CAT 6 CABLE ROUTED TO VIDEO MANAGEMENT SERVER LOCATION IN MDF. PROVIDE MINIMUM 3' OF CABLE AT TERMINATION POINTS. COORDINATE WITH EQUIPMENT SUPPLIER.
- ⑯ PROVIDE FIRE RATED BOX FSR PWB-FR-450 FOR FLAT SCREEN BACK BOX.


ADD 01

PR 03


RECORD DRAWING
 NOTE: Documents have been corrected as per data supplied by Contractor and Revision / Change Order Drawings. They do not necessarily show all existing conditions and may not be completely accurate. Field verify existing / hidden conditions prior to commencement of new work.
 DATE: AUGUST 20, 2020

REVISIONS:

#	DESCRIP.	DATE
1	ADD 01	05.17.19
5	PR 03	08.13.19
8	PR 05	09.16.19

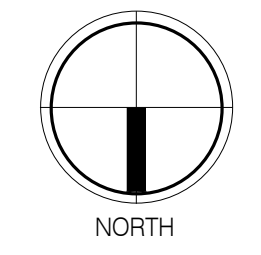

1 LOW VOLTAGE PLAN - LOWER LEVEL
 1/8" = 1'-0"

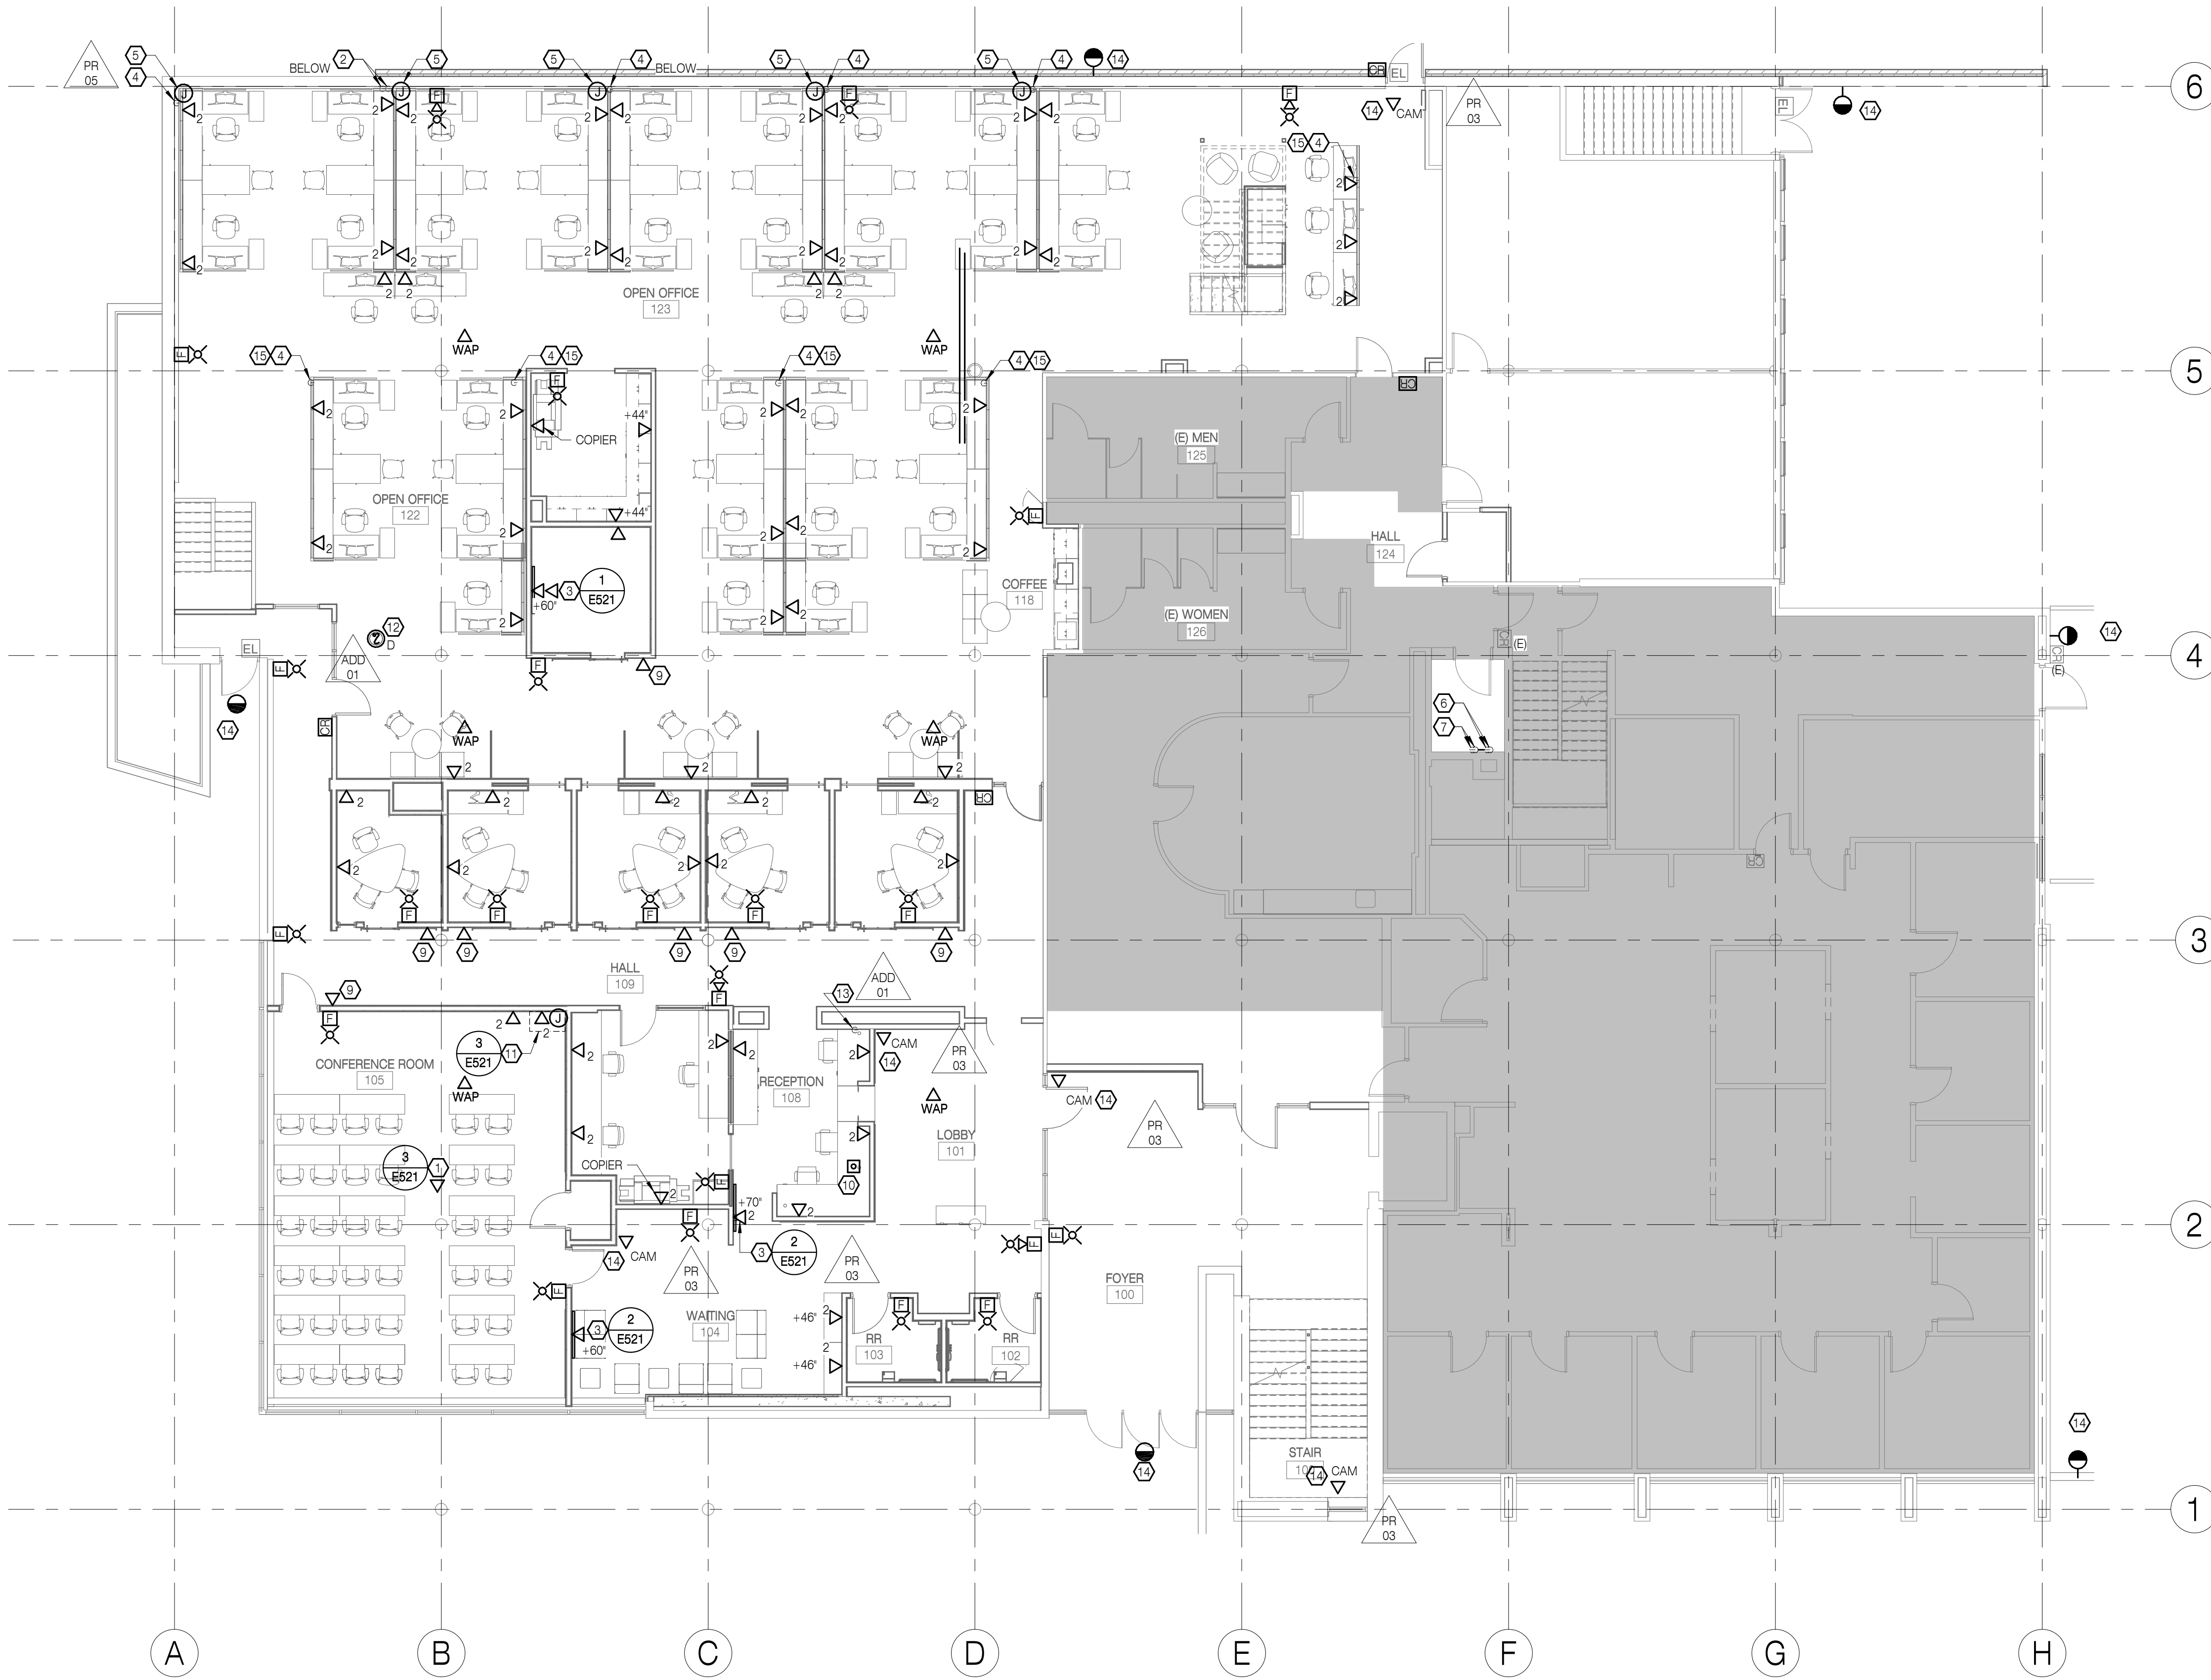


REFERENCE NOTES:

- 1 CEILING MOUNTED PROJECTOR. REFERENCE DETAIL INDICATED. COORDINATE LOCATION AND CONFIGURATION WITH ARCHITECT.
- 2 EXISTING DATA PENETRATION FROM LOWER LEVEL
- 3 WALL MOUNTED FLAT SCREEN MONITOR. REFERENCE DETAIL INDICATED.
- 4 NEW 1-1/2" C. DATA PENETRATION FROM LOWER LEVEL TO SERVE SYSTEMS FURNITURE
- 5 PROVIDE DATA CONNECTION TO SYSTEMS FURNITURE. CONTRACTOR TO INSTALL DATA TO EACH WORKSTATION AND FINISH WITH FACEPLATE. COORDINATE LOCATION AND CONFIGURATION WITH ARCHITECT.
- 6 (2) 2" DATA CONDUITS FROM LOWER LEVEL. REFERENCE 1/E131.
- 7 (2) 2" DATA CONDUITS CONTINUE TO 2ND FLOOR ELECTRICAL CLOSET. REFERENCE 1/E133.
- 8 WALL MOUNTED FLAT SCREEN MONITOR. REFERENCE DETAIL 2/E521.
- 9 PROVIDE DATA RECEPTACLE AT +48" A.F.F. FOR FUTURE ROOM RESERVATION SYSTEM CONNECTION. COORDINATE LOCATION AND CONNECTION REQUIREMENTS WITH ARCHITECT PRIOR TO ROUGH-IN.
- 10 PANIC/LOCKOUT PUSHBUTTON AT RECEPTION. COORDINATE LOCATION WITH ARCHITECT PRIOR TO ROUGH-IN.
- 11 AV CABINET. REFERENCE DETAIL INDICATED. COORDINATE LOCATION AND CONFIGURATION WITH ARCHITECT PRIOR TO ROUGH-IN.
- 12 PROVIDE DUCT SMOKE DETECTOR FOR AHU-2 IN RETURN AIR PLENUM ABOVE CEILING. COORDINATE WITH MECHANICAL.
- 13 NEW 1-1/2" C. DATA PENETRATION FROM LOWER LEVEL TO SERVE RECEPTION DESK.
- 14 INTERIOR AND EXTERIOR CAMERA LOCATIONS. PROVIDE ROUGH IN FOR CAMERA. PROVIDE CAT6 CABLE ROUTED TO VIDEO MANAGEMENT SERVER LOCATION IN MDF. PROVIDE MINIMUM 5' OF CABLE AT TERMINATION POINTS. COORDINATE WITH EQUIPMENT SUPPLIER.
- 15 PROVIDE INSULATING BUSHINGS ON EACH END OF THE CONDUIT SLEEVES BEING USED FOR DATA FLOOR PENETRATION.

- ADD 01
- PR 03
- PR 05

RECORD DRAWING
 NOTE: Documents have been corrected as per data supplied by Contractor and Revision / Change Order Drawings. They do not necessarily show all existing conditions and may not be completely accurate. Field verify existing / hidden conditions prior to commencement of new work.
 DATE: AUGUST 20, 2020

1 LOW VOLTAGE PLAN - FIRST FLOOR
 1/8" = 1'-0"

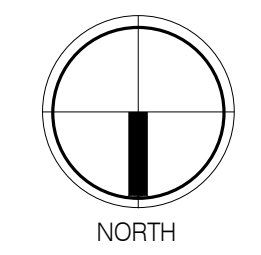


REVISIONS:

#	DESCRP.	DATE
1	ADD 01	05.17.19
5	PR 03	08.13.19
8	PR 05	09.16.19



- REFERENCE NOTES:**
- 1 (2) 2" CONDUIT FROM BASEMENT MDF ROOM TO ELECTRICAL ROOM 223. REFERENCE 1/E130 AND 1/E131.
 - 2 PROVIDE 2' x 1' x 6" WALL MOUNTED PULL BOX FOR DATA CABLING.
 - 3 (2) 2" CONDUIT FROM PULL BOX TO ELECTRICAL ROOM 226. ROUTE AROUND DUCTWORK IN CHASES. COORDINATE WITH MECHANICAL.
 - 4 (1) 3" CONDUIT PENETRATION FROM ELECTRICAL ROOM 208 TO CABLE TRAY IN CONFERENCE ROOM
 - 5 CABLE TRAY BELOW CEILING. COORDINATE WITH EXISTING WORK.
 - 6 WALL MOUNTED FLAT SCREEN MONITOR. REFERENCE DETAIL INDICATED.
 - 7 (1) NEW FOUR-POST DATA RACK, OFOI.
 - 8 (1) 3" CONDUIT PENETRATION FROM ELECTRICAL ROOM 208 TO CABLE TRAY IN OPEN OFFICE
 - 9 CABLE TRAY AT APPROX. 9' - 6" AFF BETWEEN CEILING JOISTS
 - 10 (4) 1" EXISTING CONDUITS AVAILABLE FOR USE
 - 11 (3) 1" EXISTING CONDUITS AVAILABLE FOR USE
 - 12 (1) 3" CONDUIT ROUTED THROUGH WEBBED CEILING JOISTS BETWEEN CABLE TRAYS
 - 13 PROVIDE DATA CONNECTION TO SYSTEMS FURNITURE. CONTRACTOR TO INSTALL DATA CABLING TO EACH WORKSTATION AND FINISH WITH FACEPLATE. COORDINATE LOCATION AND CONFIGURATION WITH ARCHITECT.
 - 14 CABLE TRAY STOPS AT WIDE FLANGE BEAM AT GRID LINE. ROUTE CABLING UNDER BEAM TO NEXT SEGMENT OF CABLE TRAY.
 - 15 CABLE TRAY ABOVE CEILING CLOUDS
 - 16 PROVIDE DATA RECEPTACLE AT +48" A.F.F. FOR FUTURE ROOM RESERVATION SYSTEM CONNECTION. COORDINATE LOCATION AND CONNECTION REQUIREMENTS WITH ARCHITECT PRIOR TO ROUGH-IN.
 - 17 MOMENTARY BUZZ-IN PUSHBUTTON AT RECEPTION. COORDINATE LOCATION AND CONNECTION REQUIREMENTS WITH ARCHITECT PRIOR TO ROUGH-IN.
 - 18 PROVIDE (12) CAT 6 CABLES FROM IDF 226 TO MDF 027 ON THE LOWER LEVEL. EXACT LOCATION OF BEGINNING AND ENDING TERMINATION LOCATIONS WITHIN SPACES TO BE DETERMINED WITH ARCHITECT AND OWNER'S REPRESENTATIVE.
 - 19 WIREMOLD. REFERENCE 1/E123.
 - 20 RECEPTACLES ABOVE REPAIR COUNTER AT +46" AFF. COORDINATE LOCATION AND ELEVATION WITH ARCHITECT.
 - 21 PROVIDE FLOOR POKE-THROUGH. REFERENCE 1/E123. COORDINATE LOCATION AND CONFIGURATION WITH FURNITURE EQUIPMENT SUPPLIER AND ARCHITECTURAL.
 - 22 REINSTALL EXISTING RECEPTACLE ON FACE OF ACOUSTICAL PANEL. EXTEND WIRING AS NECESSARY.
 - 23 PROVIDE DUCT SMOKE DETECTOR FOR AHU-3 AT TOP OF SHAFT ABOVE. COORDINATE WITH MECHANICAL.
 - 24 INTERIOR SECURITY CAMERA LOCATIONS. PROVIDE ROUGH IN FOR CAMERA. PROVIDE CAT6 CABLE ROUTED TO VIDEO MANAGEMENT SERVER LOCATION IN MDF. PROVIDE MINIMUM 3' OF CABLE AT TERMINATION POINTS. COORDINATE WITH EQUIPMENT SUPPLIER.


RECORD DRAWING
 NOTE: Documents have been corrected as per data supplied by Contractor and Revision / Change Order Drawings. They do not necessarily show all existing conditions and may not be completely accurate. Field verify existing / hidden conditions prior to commencement of new work.
 DATE: AUGUST 20, 2020

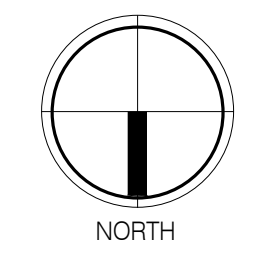

1 LOW VOLTAGE PLAN - SECOND FLOOR
 1/8" = 1'-0"

REVISIONS:

#	DESCRP.	DATE
1	ADD 01	05.17.19
5	PR 03	08.13.19
8	PR 05	09.16.19

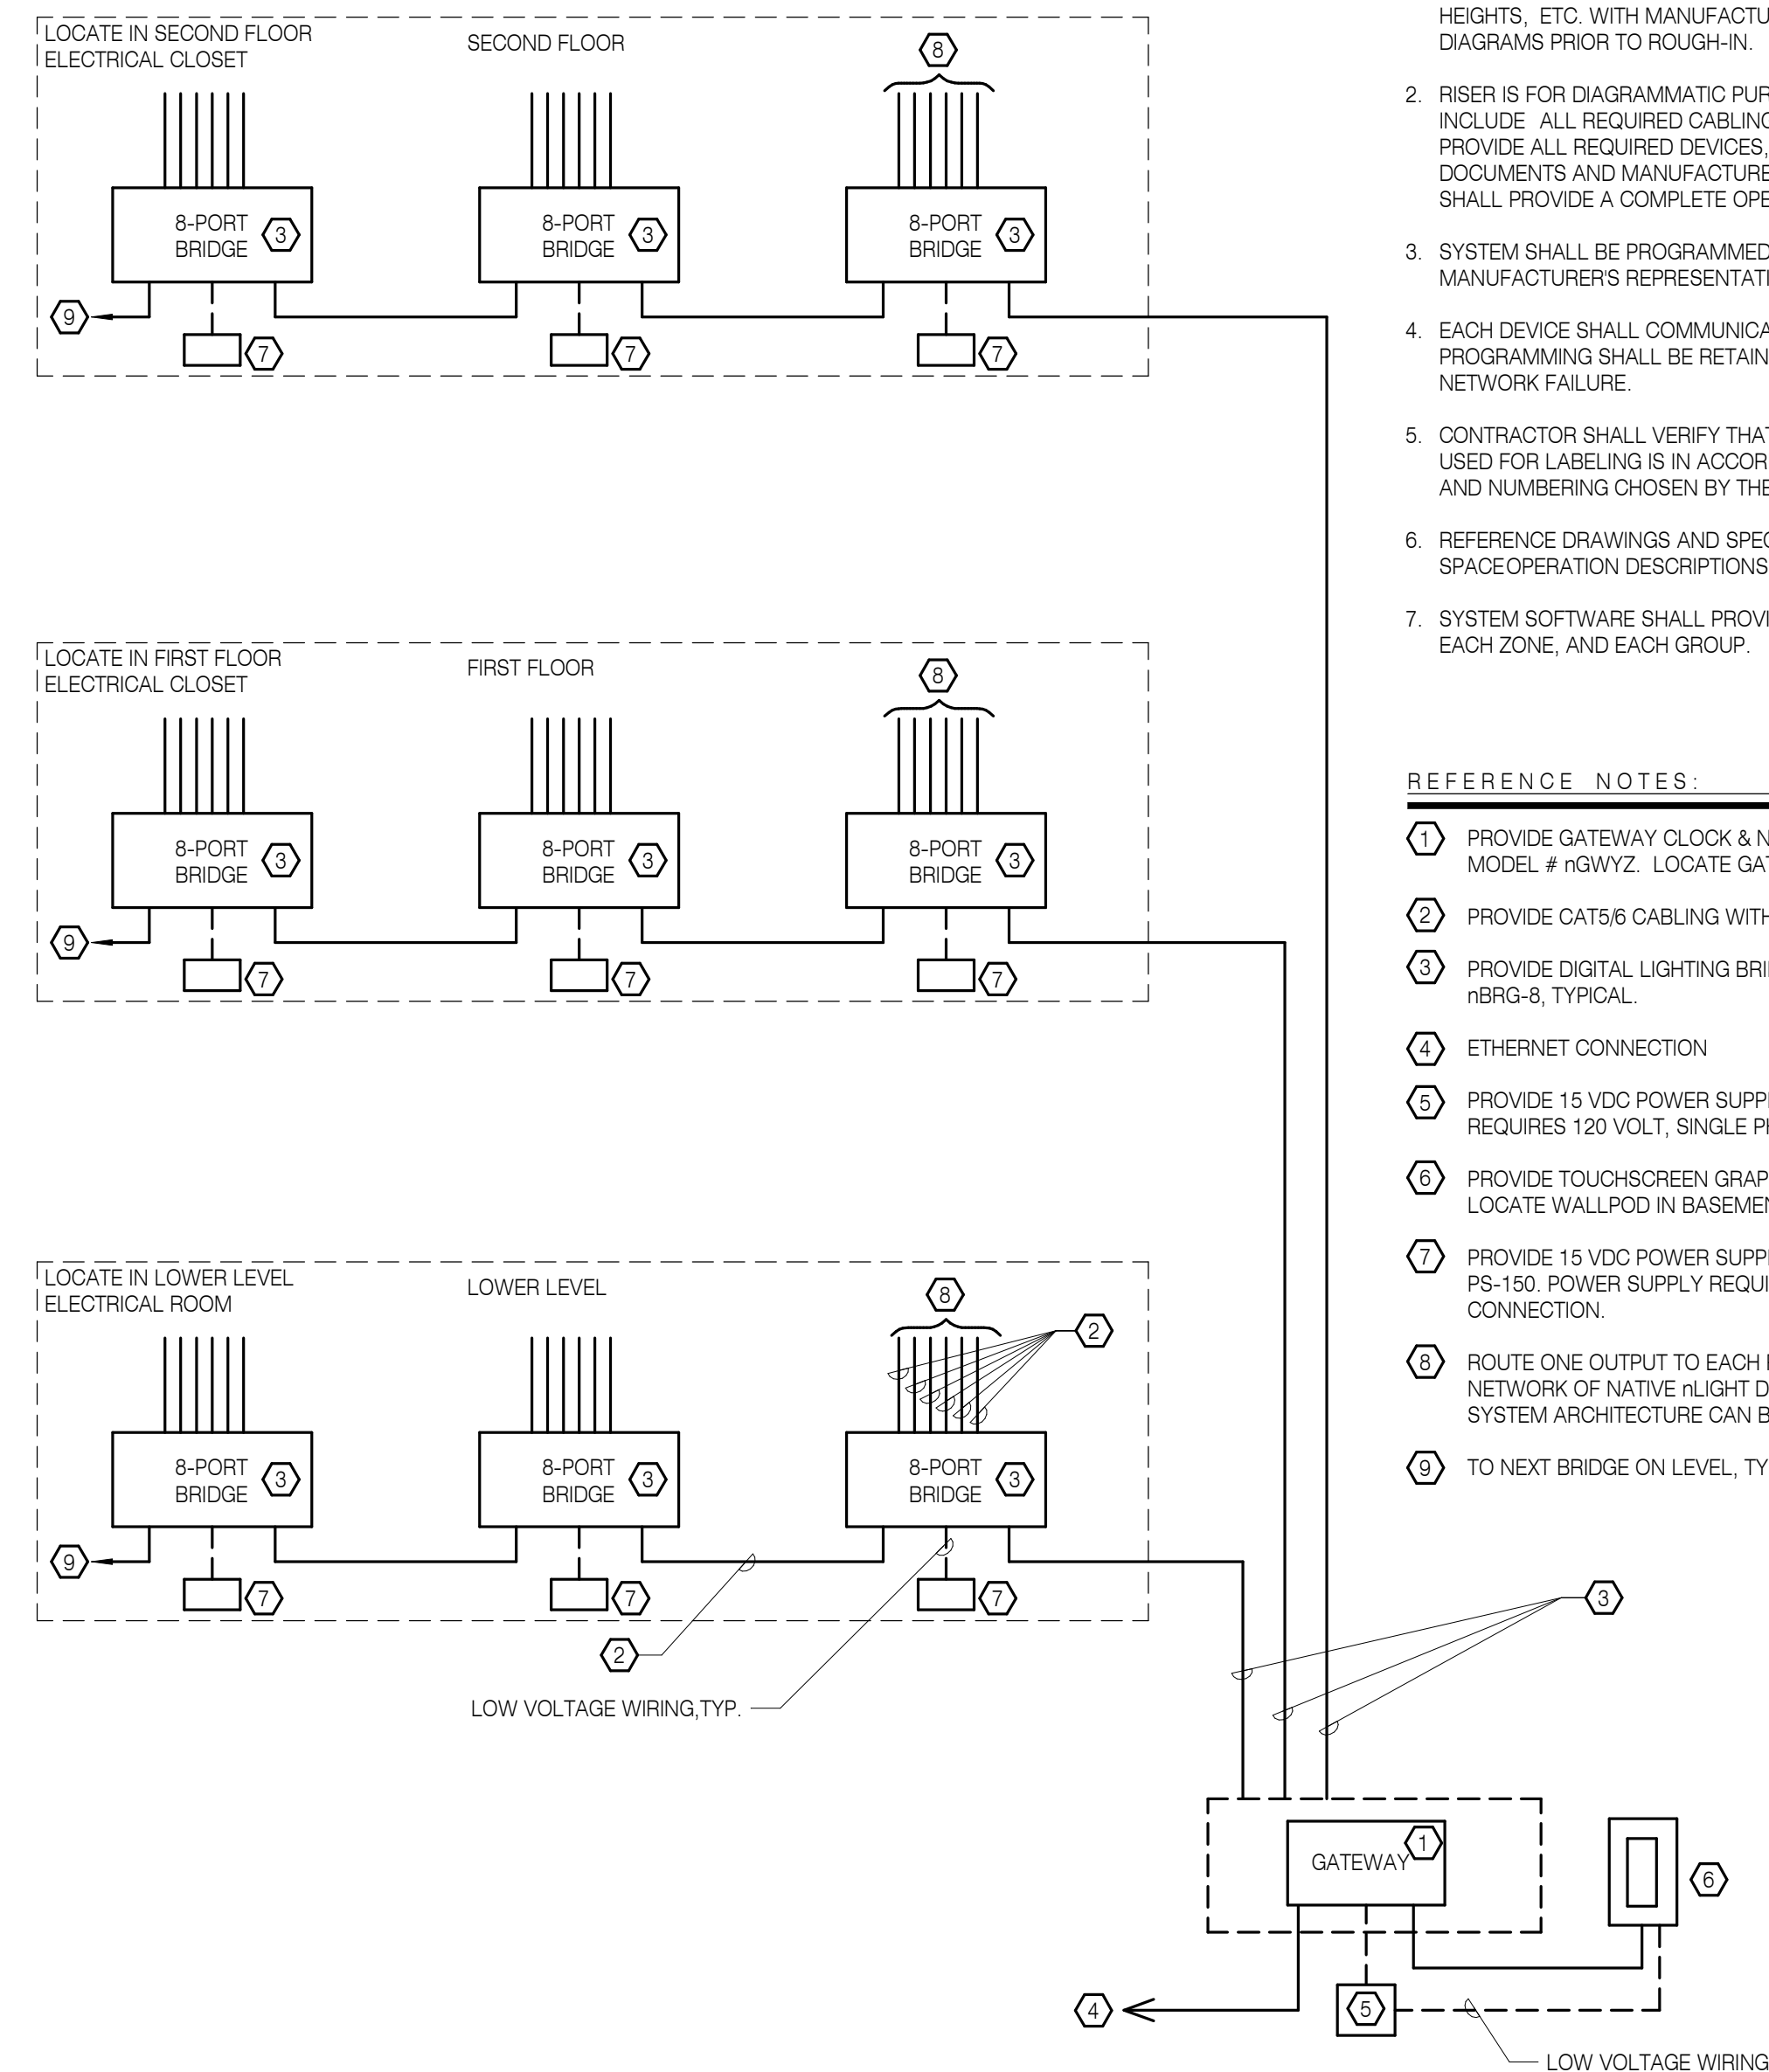

LIGHTING CONTROL RISER DIAGRAM GENERAL NOTES:

1. COORDINATE ALL DEVICE BACKBOX SIZES, LOCATIONS, MOUNTING HEIGHTS, ETC. WITH MANUFACTURERS RECOMMENDATIONS AND WIRING DIAGRAMS PRIOR TO ROUGH-IN.
2. RISER IS FOR DIAGRAMMATIC PURPOSES ONLY AND DOES NOT INDICATE OR INCLUDE ALL REQUIRED CABLING, CONDUIT, ETC. CONTRACTOR SHALL PROVIDE ALL REQUIRED DEVICES, CABLING, CONDUIT, ETC. PER THESE DOCUMENTS AND MANUFACTURERS RECOMMENDATIONS CONTRACTOR SHALL PROVIDE A COMPLETE OPERATIONAL SYSTEM.
3. SYSTEM SHALL BE PROGRAMMED AND COMMISSIONED BY A TRAINED MANUFACTURERS REPRESENTATIVE.
4. EACH DEVICE SHALL COMMUNICATE BY NETWORK CABLE AND SYSTEM PROGRAMMING SHALL BE RETAINED ON GATEWAY IN EVENT OF A NETWORK FAILURE.
5. CONTRACTOR SHALL VERIFY THAT ROOM NAMES AND NUMBERING SCHEME USED FOR LABELING IS IN ACCORDANCE WITH THE ACTUAL ROOM NAMES AND NUMBERING CHOSEN BY THE OWNER.
6. REFERENCE DRAWINGS AND SPECIFICATIONS FOR LIGHTING ZONES AND SPACE OPERATION DESCRIPTIONS.
7. SYSTEM SOFTWARE SHALL PROVIDE REAL-TIME STATUS OF EACH RELAY, EACH ZONE, AND EACH GROUP.

REFERENCE NOTES:

1. PROVIDE GATEWAY CLOCK & NETWORKING INTERFACE CONTROLLER, MODEL # nGWYZ. LOCATE GATEWAY IN BASEMENT ELECTRICAL ROOM.
2. PROVIDE CAT5/6 CABLING WITH RJ-45 MODULAR ENDS, TYPICAL.
3. PROVIDE DIGITAL LIGHTING BRIDGE, QUANTITY AS REQUIRED, MODEL #: nBRG-8, TYPICAL.
4. ETHERNET CONNECTION
5. PROVIDE 15 VDC POWER SUPPLY, MODEL #: PS-250. POWER SUPPLY REQUIRES 120 VOLT, SINGLE PHASE CONNECTION.
6. PROVIDE TOUCHSCREEN GRAPHIC WALLPOD, MODEL #: nPOD-GFX. LOCATE WALLPOD IN BASEMENT ELECTRICAL ROOM.
7. PROVIDE 15 VDC POWER SUPPLY FOR BRIDGE TYPICAL, MODEL #: PS-150. POWER SUPPLY REQUIRES 120 VOLT, SINGLE PHASE CONNECTION.
8. ROUTE ONE OUTPUT TO EACH ROOM OR SPACE AND CONNECT TO NETWORK OF NATIVE LIGHT DEVICES IN EACH ROOM OR SPACE. SYSTEM ARCHITECTURE CAN BE TOPOLOGY FREE, TYPICAL.
9. TO NEXT BRIDGE ON LEVEL, TYPICAL.

1 LIGHTING CONTROL SYSTEM RISER DIAGRAM
NOT TO SCALE


RECORD DRAWING

NOTE: Documents have been corrected as per data supplied by Contractor and Revision / Change Order Drawings. They do not necessarily show all existing conditions and may not be completely accurate. Field verify existing / hidden conditions prior to commencement of new work.
DATE: AUGUST 20, 2020

SHEET TITLE:
LIGHTING DETAILS

REVISIONS:
DESCR. DATE

ISSUE DATE: 08/20/2020

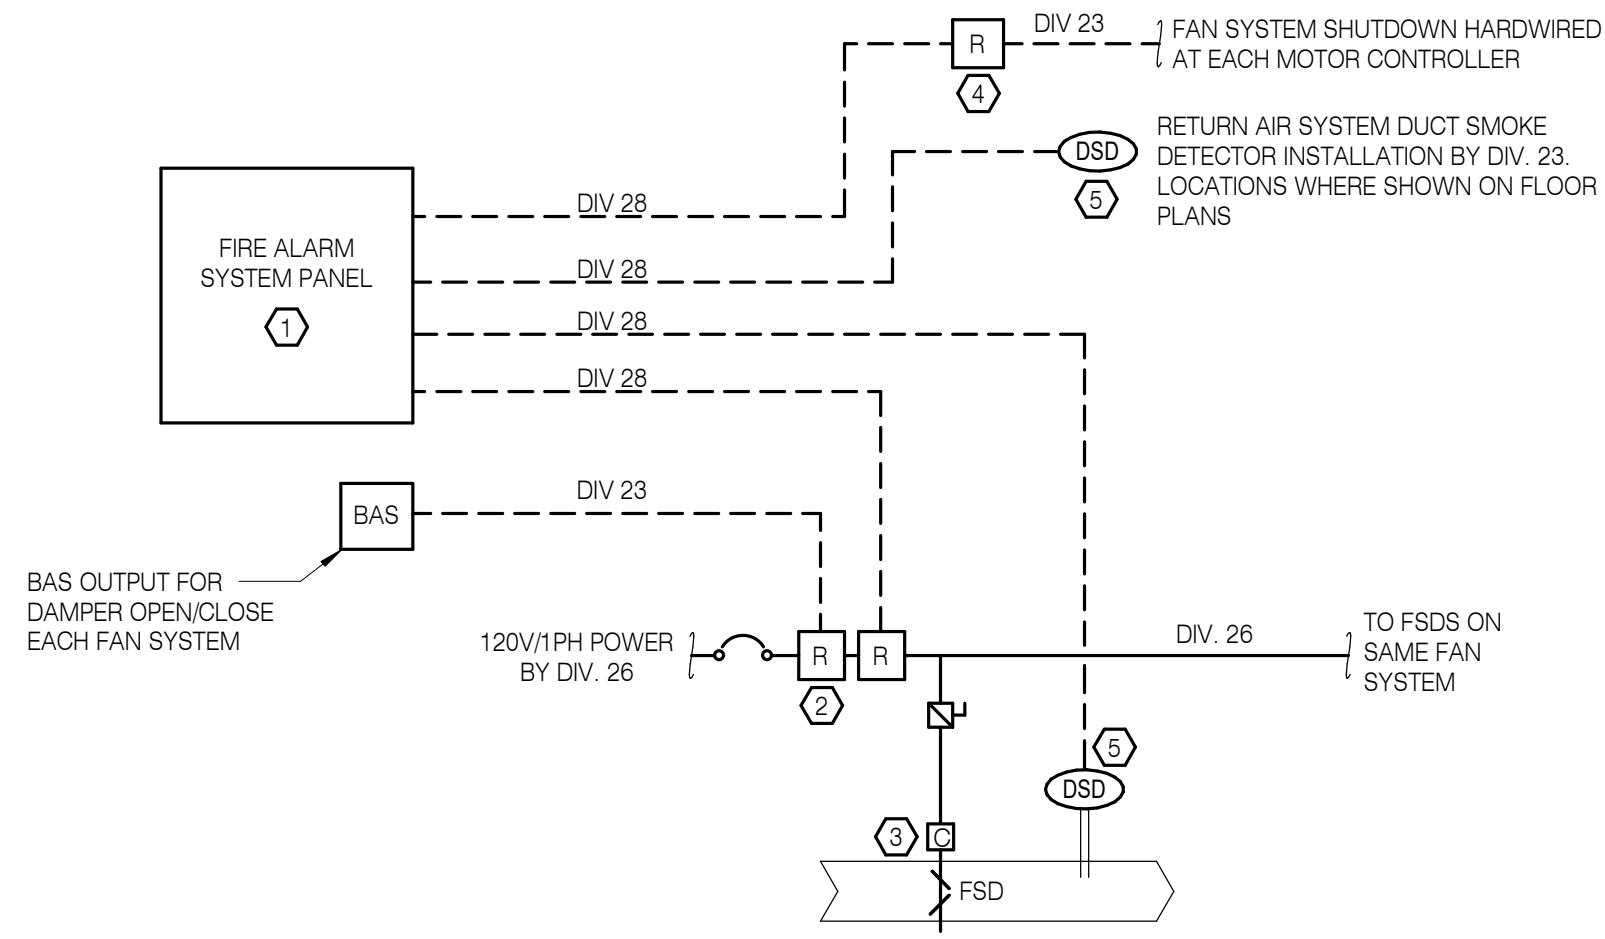

- GENERAL NOTES:**
- REFER TO MECHANICAL AND ELECTRICAL FLOOR PLANS AND DETAILS FOR FIRE/SMOKE DAMPER AND DUCT SMOKE DETECTOR QUANTITIES AND LOCATIONS.
 - CONTRACTOR SHALL COORDINATE DUCT SMOKE DETECTOR INSTALLATION AT EACH LOCATION PRIOR TO COMMENCING WORK. DIV. 23 SHALL INSTALL DUCT SMOKE DETECTORS, AND MODIFY DUCTWORK AS REQUIRED TO ACCOMMODATE DETECTOR INSTALLATION. PROVIDE ALL WORK TO SUIT INSTALLATION REQUIREMENTS AND ALL APPLICABLE CODES.
 - REFER TO DIV. 28 FOR ALARM SEQUENCE OF OPERATIONS.

- REFERENCE NOTES:**
- REFER TO ELECTRICAL PLANS FOR FIRE ALARM PANEL LOCATION.
 - ADDRESSABLE FIRE ALARM CONTROL MODULES BY DIV. 28. INSTALL ADJACENT TO ELECTRICAL PANEL.
 - FIRE SMOKE DAMPER PROVIDED BY DIV. 23. POWER ALL FIRE SMOKE DAMPERS FOR EACH FAN SYSTEM FROM SAME CIRCUIT.
 - ADDRESSABLE FIRE ALARM CONTROL MODULE BY DIV. 28. INSTALL ADJACENT TO BAS PANEL.
 - DUCT SMOKE DETECTOR FURNISHED & WIRED BY DIV. 28, INSTALLED BY DIV. 23.

1 AIR HANDLER FIRE ALARM CONTROL
NOT TO SCALE

RECORD DRAWING
NOTE: Documents have been corrected as per data supplied by Contractor and Revision / Change Order Drawings. They do not necessarily show all existing conditions and may not be completely accurate. Field verify existing / hidden conditions prior to commencement of new work.
DATE: AUGUST 20, 2020

RECORD DRAWINGS
HOMES FOR GOOD OFFICE BUILDING
REMODEL
100 WEST 80TH AVENUE
EUGENE, OR 97401

SHEET TITLE:
POWER DISTRIBUTION DETAILS

REVISIONS:
DESCRP. DATE


ISSUE DATE: 08/20/2020

E511


RECORD DRAWING
20 AUGUST 2020

SW E
SYSTEMS WEST ENGINEERS
725 A Street
Springfield, OR 97477
541.342.7210
systemswestengineers.com
SWE Proj. No. U003.08


PIVOT
ARCHITECTURE

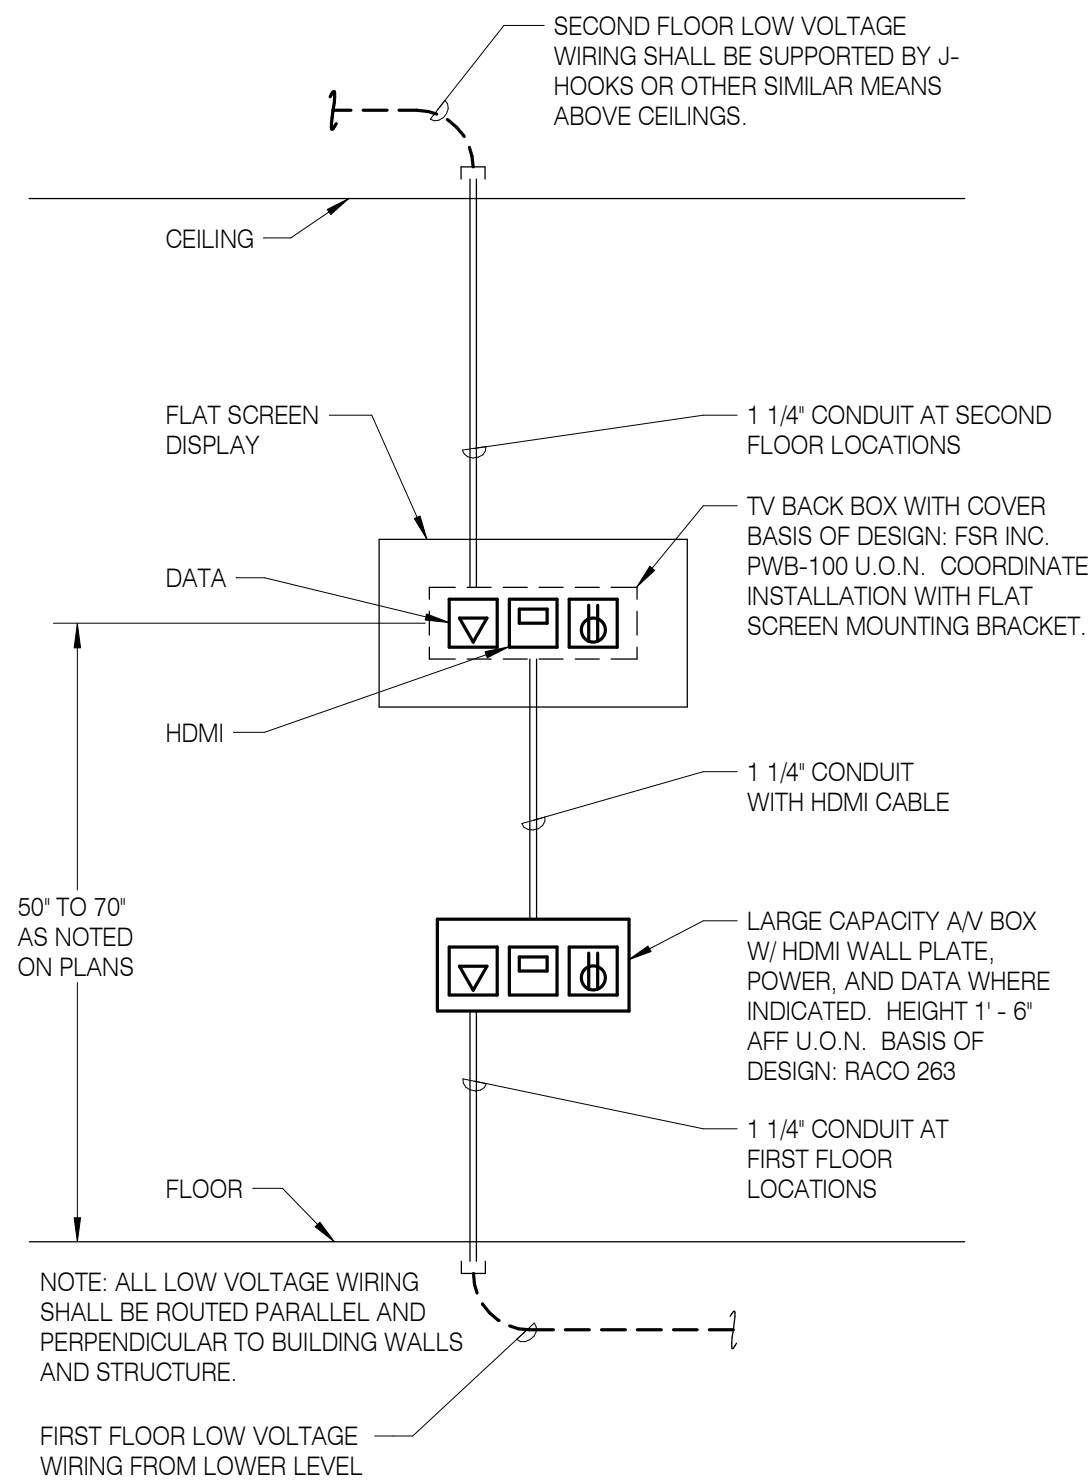

1 FLAT SCREEN INSTALLATION 1
NOT TO SCALE

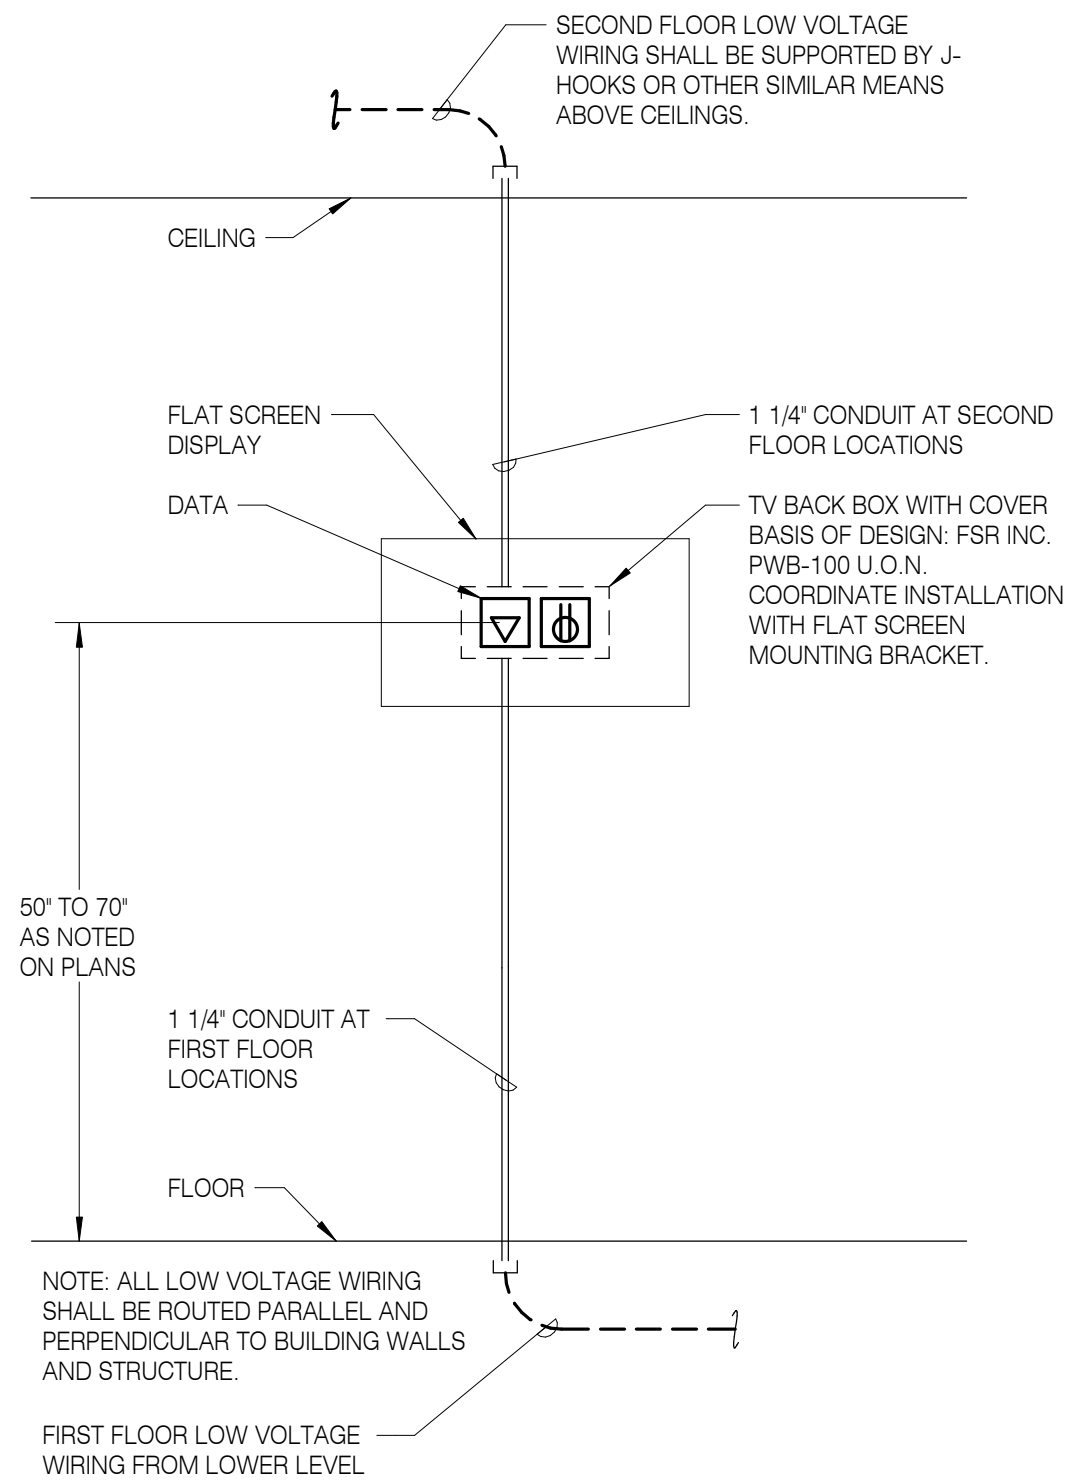

2 FLAT SCREEN INSTALLATION 2
NOT TO SCALE

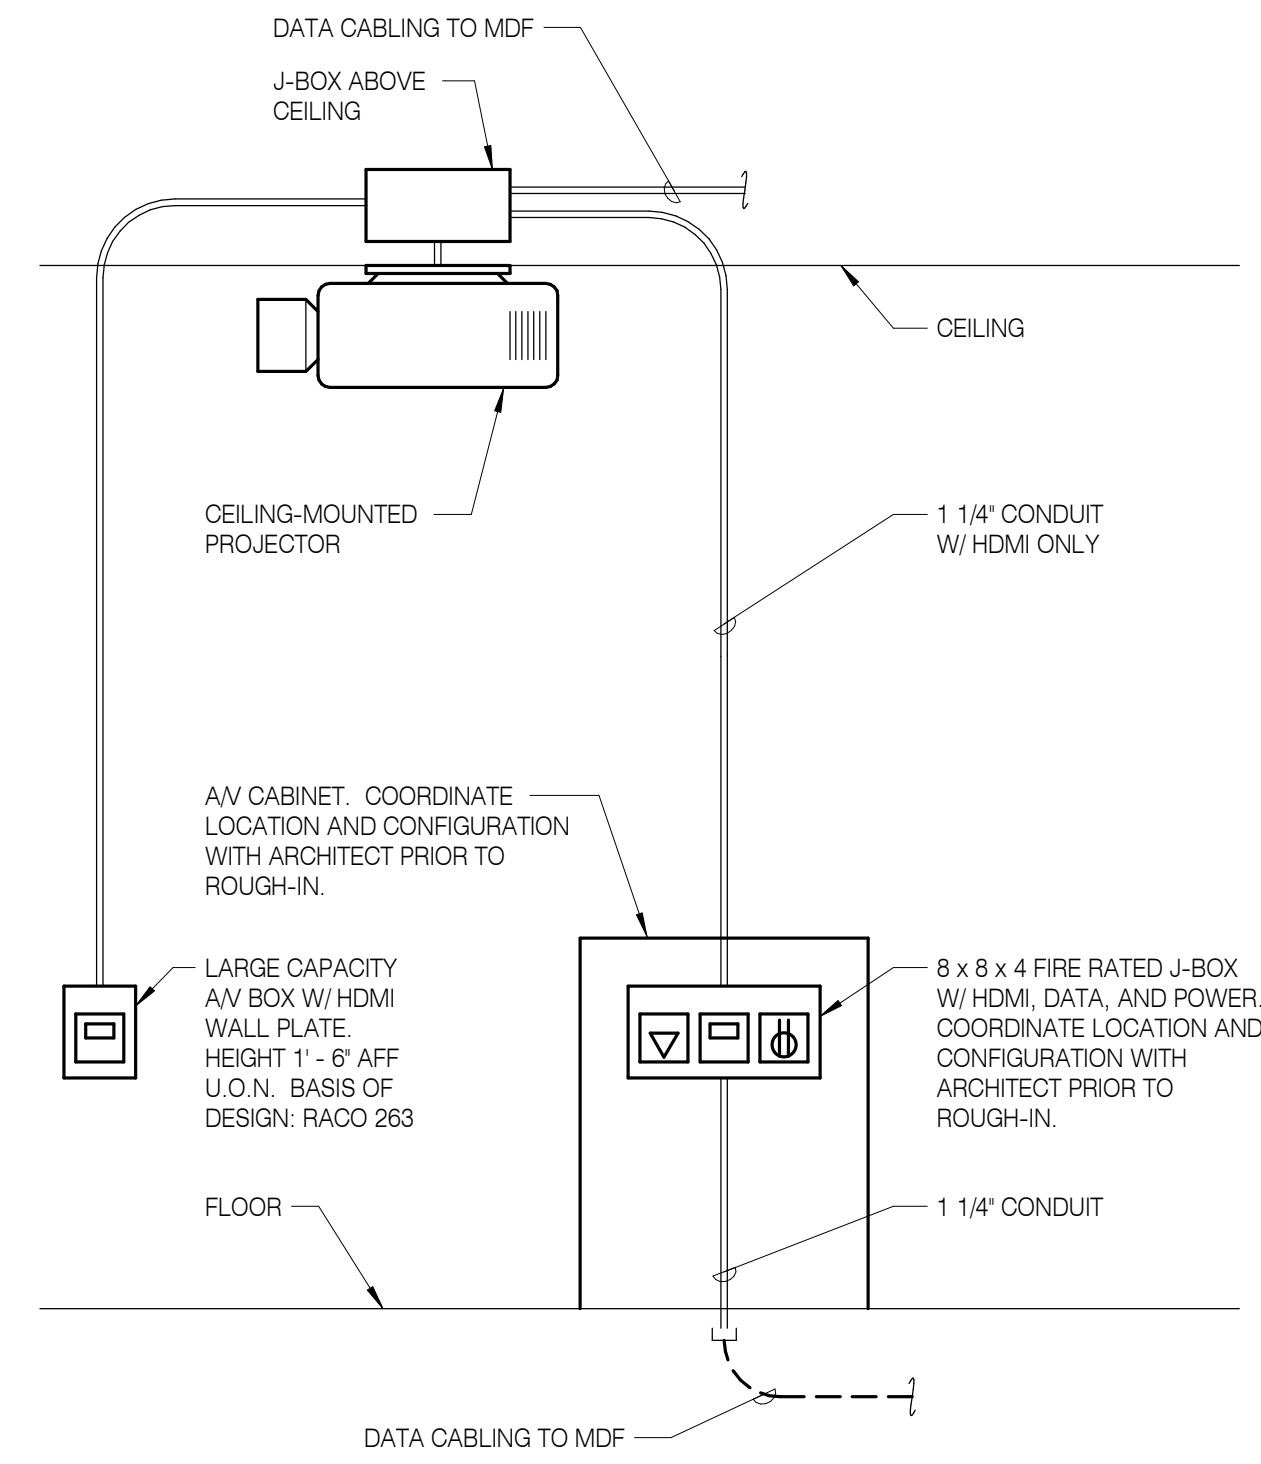

3 CONFERENCE ROOM A/V PATHWAY
NOT TO SCALE

RECORD DRAWING
NOTE: Documents have been corrected as per data supplied by Contractor and Revision / Change Order Drawings. They do not necessarily show all existing conditions and may not be completely accurate. Field verify existing / hidden conditions prior to commencement of new work.
DATE: AUGUST 20, 2020

RECORD DRAWING
20 AUGUST 2020

SW E
SYSTEMS WEST ENGINEERS
725 A Street
Springfield, OR 97477
541.342.7210
systemswestengineers.com
SWE Proj. No. U003.08

RECORD DRAWINGS
HOMES FOR GOOD OFFICE BUILDING REMODEL
100 WEST 80TH AVENUE
EUGENE, OR 97401

SHEET TITLE:
LOW VOLTAGE DETAILS

REVISIONS:

#	DESCRP.	DATE

ISSUE DATE: 08/20/2020

ADD 01

ADD 01

LUMINAIRE SCHEDULE					
TYPE	DESCRIPTION	MANUFACTURER	LAMP	FINISH	NOTES
AP	48 INCH LINEAR SUSPENDED DIRECT/INDIRECT 75/25	FLUXWERX APERTURE CIRCLES SERIES	LED 3500K 2650 LM 21W(4FT)	BLACK	MOUNTING : AIRCRAFT CABLE - MOUNT TO XX' AFF HOUSING : ANODIZED EXTRUDED MACHINED ALUMINUM LENS/REFL : ANODOLIC OPTICAL STRUCTURE WITH ACRYLIC LENSES VOLTAGE : 120V BALLAST : ELECTRONIC DRIVER DIMMING (0-10V)
AP(XX)	LINEAR SUSPENDED DIRECT/INDIRECT 75/25 (XX' INDICATED LENGTH IN FEET)	FLUXWERX APERTURE SERIES	LED 3500K 2650 LM 21W(PER 4FT)	BLACK	MOUNTING : AIRCRAFT CABLE - MOUNT TO XX' AFF HOUSING : ANODIZED EXTRUDED MACHINED ALUMINUM LENS/REFL : ANODOLIC OPTICAL STRUCTURE WITH ACRYLIC LENSES VOLTAGE : 120V BALLAST : ELECTRONIC DRIVER DIMMING (0-10V)
DA	5" DIAMETER X 5/8" LED SURFACE MOUNT DOWNLIGHT	LIGHTOLIER SLIMSURFACE ROUND	LED 3500K 80+ CRI 750 LUMENS 11.8W	WHITE	MOUNTING : SURFACE HOUSING : 18 GAUGE DIE FORMED ALUMINUM BOX, 22 GA. MTD STEEL FRAME LENS/REFL : SMOOTH SILVER REFLECTOR WITH WHITE FLANGE VOLTAGE : UNIVERSAL VOLTAGE 120V-277V BALLAST : ELECTRONIC DRIVER DIMMING (0-10V) MISC : UL LISTED WET LOCATION
DE	7 INCH DIA. LED SURFACE MOUNT LUMINAIRE WET LOCATION LISTED	SATCO S29330 SERIES	LED 2700K 90 CRI 800 LUMENS 13.5W	BRONZE	MOUNTING : SURFACE HOUSING : DIE FORMED ALUMINUM; BRONZE LENS/REFL : SMOOTH SILVER REFLECTOR WITH WHITE FLANGE VOLTAGE : UNIVERSAL VOLTAGE 120V-277V BALLAST : ELECTRONIC DRIVER DIMMING (0-10V) MISC : UL LISTED WET LOCATION
DL4	LED RECESSED DOWNLIGHT - 4" APERTURE	GOTHAM EVO4 SERIES LIGHTOLIER L4R	LED 3500K 80+ CRI 1000 LUMENS 15W	WHITE	MOUNTING : RECESSED HOUSING : 18 GAUGE DIE FORMED ALUMINUM BOX , 22 GA. MTD STEEL FRAME LENS/REFL : SELF-FLGD; SEMI-SPECULAR TRIM VOLTAGE : UNIVERSAL VOLTAGE 120V-277V BALLAST : ELECTRONIC DRIVER DIMMING (0-10V)
DL4D	LED RECESSED SHOWER DOWNLIGHT - 4" APERTURE WITH FLUSH POLYCARBONATE LENSED DEAD FRONT TRIM IP66 RATED	GOTHAM EVO4SH SERIES LIGHTOLIER L4R	LED 3500K 80+ CRI 1000 LUMENS 15W	WHITE	MOUNTING : RECESSED HOUSING : 18 GAUGE DIE FORMED ALUMINUM BOX , 22 GA. MTD STEEL FRAME LENS/REFL : SMOOTH; FLUSH LENSED TRIM VOLTAGE : UNIVERSAL VOLTAGE 120V-277V BALLAST : ELECTRONIC DRIVER DIMMING (0-10V) MISC : UL LISTED WET LOCATION
EX	LED EXIT SIGN UNIVERSAL MOUNT	LITHONIA LED LE SERIES CHLORIDE ER46L SURELITES CX	LED GREEN 1.7 W	WHITE	MOUNTING : SURFACE HOUSING : DIE CAST ALUMINUM LENS/REFL : SINGLE OR DOUBLE FACES AS INDICATED ON DRAWINGS VOLTAGE : UNIVERSAL 120V-277V BALLAST : ELECTRONIC DRIVER MISC : NICKEL-CADMIUM BATTERY BACK-UP, SELF DIAGNOSTICS CEILING MOUNT FIXTURE, UON
FA	12" X 24" RECESSED LED LOW GLARE OPTICS	AXIS DAY SERIES	LED 3500K 80+ CRI 2000 LUMENS 20W	WHITE	MOUNTING : RECESSED HOUSING : DIE FORMED STEEL LENS/REFL : ACRYLIC VOLTAGE : 120V BALLAST : ELECTRONIC DIMMING DRIVER (0-10V)
FS	PENDANT LINEAR LED SYSTEM TWO DIRECT / ONE INDIRECT ORIENTED 2.25 X 2.25 X 63 INCH ARM UNITS (D / I / D), 6 INCH MID STEMS AND 24 INCH MAIN STEEL STEM W/ MTG. BRACKET. ORIENT TO FOLLOW HEIGHTS OF STAIRS, AT 60 DEGREE INCREMENTS. BALANCE W/ COUNTERWEIGHTS.	EUREKA SWITCH	LED 3500K 80+ CRI 1834 LUMENS (EACH ARM) 20.8W (X3 ARMS)	WHITE	MOUNTING : PENDANT HOUSING : ALUMINUM W/ LED MODULES, STEEL STEM LENS/REFL : ACRYLIC VOLTAGE : 120V BALLAST : ELECTRONIC DIMMING DRIVER (0-10V)
G	16 X 16 X 6 INCH (NOMINAL) WALL MOUNTED LED SCONCE CAST ALUMINUM HOUSING, TYPE III DISTRIBUTION, COMFORT OPTICS	GARDOO PWS SERIES	LED 4000K 80+ CRI 3508 LUMENS 30.4 W	DK GRAY	MOUNTING : WALL-MOUNTED, 16" ABOVE GRADE HOUSING : CAST ALUMINUM LENS/REFL : TYPE III DISTRIBUTION, MOLDED MICRO-OPTICS VOLTAGE : 120 BALLAST : ELECTRONIC
K(WW)	3' x 5' X 1' SURFACE MT LINEAR - LED DIRECT ONLY	FINELITE HP-WS 4W4D S	LED 3500K 80+ CRI 317 LUMENS/FT 3.6W/FT	WHITE	MOUNTING : SURFACE HOUSING : EXTRUDED ALUMINUM LENS/REFL : FROST ACRYLIC VOLTAGE : 120V BALLAST : ELECTRONIC DIMMING DRIVER (0-10V) MISC :
L(XX)	2 X 4 INCH X (XX) SUSPENDED LINEAR LED LUMINAIRE - DIRECT ONLY FLUSH DIFFUSER (XX' INDICATES FIXTURE LENGTH IN FEET)	FINELITE HP-2 D SERIES CORONET LS1	LED 3500K 80+ CRI 625 LUMENS 7W/FT	WHITE	MOUNTING : AIRCRAFT CABLE - MOUNT TO XX' AFF HOUSING : DIE FORMED 22 GAUGE COLD ROLLED STEEL LENS/REFL : FROST ACRYLIC VOLTAGE : 120V BALLAST : ELECTRONIC DIMMING DRIVER (0-10V)
LB	2 X 4 X 48 INCH WALL MOUNTED LINEAR LED LUMINAIRE WITH ASYMMETRIC OPTIC - INDIRECT ONLY	FINELITE HP-2WM I SERIES CORONET LS1	LED 3500K 80+ CRI 1535 LUMENS 14.4W	WHITE	MOUNTING : SURFACE MOUNTED - WALL HOUSING : DIE FORMED 22 GAUGE COLD ROLLED STEEL LENS/REFL : FROST ACRYLIC VOLTAGE : 120V BALLAST : ELECTRONIC DIMMING DRIVER (0-10V)
LK	48" x 3" x 3" RECESSED LINEAR LED LUMINAIRE DIRECT ONLY	LEDALITE TRUGROOVE DEFINITION SERIES FOCAL POINT FSM2L	LED 3500K 80+ CRI 1500 LUMENS 14W	WHITE	MOUNTING : RECESSED - FLUSH LENS IN WOOD CLOUD HOUSING : EXTRUDED ALUMINUM LENS/REFL : FLUSH SILK VOLTAGE : 120V BALLAST : ELECTRONIC DIMMING DRIVER (0-10V)
LR2	24" x 3" x 3" SUSPENDED LINEAR LED DIRECT ONLY	FINELITE HP2-D CORONET LS1	LED 3500K 80+ CRI 668 LUMENS 7.5W	WHITE	MOUNTING : AIRCRAFT CABLE - MOUNT TO XX' AFF HOUSING : EXTRUDED ALUMINUM LENS/REFL : FLUSH ACRYLIC VOLTAGE : 120V BALLAST : ELECTRONIC DIMMING DRIVER (0-10V)

ADD 01

ADD 01

TYPE	DESCRIPTION	MANUFACTURER	LAMP	FINISH	NOTES
LW(XX)	3' x 3' SURFACE MOUNT EXTRUDED ALUMINUM LINEAR LED WITH 2 SIDED LENSING (DIRECT)	AXIS EDGE 2 ED2WD	LED 3500K 80+ CRI 500 LUMENS/FT 4W/FT	WHITE	MOUNTING : WALL MOUNT TO 7'-4" AFF TO FIXT BOTTOM HOUSING : EXTRUDED ALUMINUM LENS/REFL : EXTRUDED ACRYLIC VOLTAGE : 120V BALLAST : ELECTRONIC DIMMING DRIVER (0-10V)
PD	12" x 9" DIAMETER LED DECORATIVE PENDANT DIRECT ONLY	EUREKA STELLA 4272 SERIES	LED 3500K 80+ CRI 2360 LUMENS 28.6W	BLACK	MOUNTING : PENDANT HOUSING : EXTRUDED ALUMINUM TUBE LENS/REFL : WHITE INTERNAL FINISH VOLTAGE : 120V BALLAST : ELECTRONIC DIMMING DRIVER (0-10V)
R(XX)	3' x (XX)' RECESSED LINEAR LED LUMINAIRE WITH FLUSH LENS (XX' INDICATED LENGTH IN FEET)	FINELITE HP-2R B SERIES	LED 3500K 80+ CRI 423 LUMENS/FT 4.6W/FT	WHITE	MOUNTING : RECESSED HOUSING : ANODIZED EXTRUDED MACHINED ALUMINUM LENS/REFL : FROST ACRYLIC VOLTAGE : 120V BALLAST : ELECTRONIC DIMMING DRIVER (0-10V)
RTR	12" x 48" RECESSED LINEAR LED RETROFIT ASSEMBLY	LITHONIA BLTR SERIES	LED 3500K 80+ CRI 3000 LUMENS 23W	WHITE	MOUNTING : RECESSED, (MOUNTS IN EXISTING 1 X 4 TROFFER) HOUSING : NONE LENS/REFL : CURVED DIFFUSER, LINEAR PRISMS VOLTAGE : 120 BALLAST : ELECTRONIC
SM	192" X 2.25" X 4" INCH SURFACE MOUNT DIRECT ONLY LINEAR LED	FINELITE HP-2-SM H CORONET LS1	LED 3500K 80+ CRI 10004 LUMENS 114W	WHITE	MOUNTING : SURFACE MOUNT HOUSING : DIE FORMED 22 GAUGE COLD ROLLED STEEL LENS/REFL : FLUSH VOLTAGE : 120V BALLAST : ELECTRONIC DRIVER DIMMING (0-10V)
SW4	4" SURFACE MOUNTED ACRYLIC WRAP	LITHONIA BLWP SERIES DAYBRITE FSW METALUX AP	LED 3500K 80+ CRI 4082 LUMENS 35W	WHITE	MOUNTING : SURFACE MOUNT HOUSING : LENS/REFL : ACRYLIC VOLTAGE : 120V BALLAST : ELECTRONIC DIMMING DRIVER (0-10V)
T2	24 X 24 INCH RECESSED LINEAR LED LUMINAIRE	AXIS DAY SERIES LEDALITE 33	LED 3500K 80+ CRI 3000 LUMENS 26W	WHITE	MOUNTING : RECESSED HOUSING : DIE FORMED 22 GAUGE COLD ROLLED STEEL LENS/REFL : FROST ACRYLIC - FLAT VOLTAGE : 120V BALLAST : ELECTRONIC DIMMING DRIVER (0-10V)
T4	24 X 48 INCH RECESSED LINEAR LED LUMINAIRE	AXIS DAY SERIES LEDALITE 33	LED 3500K 80+ CRI 3200 LUMENS 26W	WHITE	MOUNTING : RECESSED HOUSING : DIE FORMED 22 GAUGE COLD ROLLED STEEL LENS/REFL : FROST ACRYLIC - FLAT VOLTAGE : 120V BALLAST : ELECTRONIC DIMMING DRIVER (0-10V)
V2	24" SURFACE MOUNTED LINEAR LED LUMINAIRE	PRUDENTIAL BOLT PRIMUS ALX3	LED 3500K 80+ CRI 640 LUMENS/FT 23W	WHITE	MOUNTING : SURFACE HOUSING : DIE FORMED 22 GAUGE COLD ROLLED STEEL LENS/REFL : ACRYLIC VOLTAGE : 120V BALLAST : ELECTRONIC

RECORD DRAWING
NOTE: Documents have been corrected as per data supplied by Contractor and Revision / Change Order Drawings. They do not necessarily show all existing conditions and may not be completely accurate. Field verify existing / hidden conditions prior to commencement of new work.
DATE: AUGUST 20, 2020

PIVOT
ARCHITECTURE
RECORD DRAWING
20 AUGUST 2020

SW E
SYSTEMS WEST ENGINEERS
725 A Street
Springfield, OR 97477
541.342.7210
systemswestengineers.com
SWE Proj. No. U003.08

RECORD DRAWINGS
HOMES FOR GOOD OFFICE BUILDING
REMODEL
100 WEST 10TH AVENUE
EUGENE, OR 97401

SHEET TITLE:
LUMINAIRE SCHEDULE

REVISIONS:
DESCRP. DATE
1 ADD 01 05.17.19

ISSUE DATE: 08/20/2020

E601

PANEL SCHEDULE PANEL: B2. TYPE: BOLT ON AMPS: 225. VOLTS: 120/208. LOCATION: BASEMENT HALL 014. MOUNTING: NOTES: EXISTING RELOCATED PANEL SQUARE D. (N) INDICATES A NEW BREAKER SERVING NEW LOAD. (E) INDICATES AN EXISTING BREAKER SERVING AN EXISTING LOAD. (EN) INDICATES AN EXISTING BREAKER SERVING A NEW LOAD. (RP) INDICATES REPLACE AN EXISTING BREAKER WITH BREAKER SIZE SHOWN OR SPACE, BREAKER SHALL MATCH EXISTING PANEL MANUFACTURER.

PANEL SCHEDULE PANEL: D. TYPE: BOLT ON AMPS: 225. VOLTS: 120/208. LOCATION: 2ND FLR ELECTRICAL 226. MOUNTING: NOTES: EXISTING PANEL - SQUARE D. (N) INDICATES A NEW BREAKER SERVING NEW LOAD. (E) INDICATES AN EXISTING BREAKER SERVING AN EXISTING LOAD. (EN) INDICATES AN EXISTING BREAKER SERVING A NEW LOAD. (RP) INDICATES REPLACE AN EXISTING BREAKER WITH BREAKER SIZE SHOWN OR SPACE, BREAKER SHALL MATCH EXISTING PANEL MANUFACTURER.

PANEL SCHEDULE PANEL: C. TYPE: BOLT ON AMPS: 250. VOLTS: 120/208. LOCATION: 2ND FLOOR ELEC/JAN 223. MOUNTING: SURFACE. NOTES: NEW PANEL - REPLACES EXISTING PANEL C (100 MB). (RL) INDICATES A RELOCATED LOAD FROM EXISTING PANEL C. (N) INDICATES NEW LOAD.

PANEL SCHEDULE PANEL: D1. TYPE: BOLT ON AMPS: 100. VOLTS: 120/208. LOCATION: 2ND FLR ELECTRICAL 226. MOUNTING: NOTES: EXISTING PANEL - SQUARE D. (N) INDICATES A NEW BREAKER SERVING NEW LOAD. (E) INDICATES AN EXISTING BREAKER SERVING AN EXISTING LOAD. (EN) INDICATES AN EXISTING BREAKER SERVING A NEW LOAD. (RP) INDICATES REPLACE AN EXISTING BREAKER WITH BREAKER SIZE SHOWN OR SPACE, BREAKER SHALL MATCH EXISTING PANEL MANUFACTURER.

PR 05

PR 06

ADD 01

PR 05

ADD 01

RECORD DRAWING NOTE: Documents have been corrected as per data supplied by Contractor and Revision / Change Order Drawings. They do not necessarily show all existing conditions and may not be completely accurate. Field verify existing / hidden conditions prior to commencement of new work. DATE: AUGUST 20, 2020

SHEET TITLE: SCHEDULES

REVISIONS: # DESCRP. DATE 1 ADD 01 05.17.19 8 PR 05 09.16.19 11 PR 06 12.03.19

PANEL SCHEDULE
PANEL: E1
VOLTS: 120/208
LOCATION: BASEMENT SERVER ROOM 022
MOUNTING:
NOTES: EXISTING PANEL - SQUARE D
LOAD CLASS table: LIGHTING, OUTLETS, MOTOR LOADS, RESISTANCE LOADS, SUBFEED, MISC. LOADS, SUBFEED BREAKER
TOTAL VOLT-AMPS: 0, MAXIMUM PHASE AMPS: 0.0

PANEL SCHEDULE
PANEL: ELL
VOLTS: 120/208
LOCATION: BASEMENT SERVER ROOM 022
MOUNTING:
NOTES: EXISTING PANEL - SQUARE D
LOAD CLASS table: LIGHTING, OUTLETS, MOTOR LOADS, RESISTANCE LOADS, SUBFEED, MISC. LOADS, SUBFEED BREAKER
TOTAL VOLT-AMPS: 0, MAXIMUM PHASE AMPS: 0.0

PANEL SCHEDULE
PANEL: F
VOLTS: 120/208
LOCATION: BASEMENT MECHANICAL 006
MOUNTING: SURFACE
NOTES: EXISTING PANEL SQUARE D
LOAD CLASS table: LIGHTING, OUTLETS, MOTOR LOADS, RESISTANCE LOADS, SUBFEED, MISC. LOADS, SUBFEED BREAKER
TOTAL VOLT-AMPS: 12,744, MAXIMUM PHASE AMPS: 48.4

PANEL SCHEDULE
PANEL: K1
VOLTS: 120/208
LOCATION: BASEMENT MDF 027
MOUNTING: SURFACE
NOTES: NEW PANEL - 54 SPACE - PROVIDE INDIVIDUAL POWER MONITORING.
LOAD CLASS table: LIGHTING, OUTLETS, MOTOR LOADS, RESISTANCE LOADS, SUBFEED, MISC. LOADS, SUBFEED BREAKER
TOTAL VOLT-AMPS: 0, MAXIMUM PHASE AMPS: 0.0



RECORD DRAWING 20 AUGUST 2020



SYSTEMS WEST ENGINEERS 725 A Street Springfield, OR 97477 541.342.7210 systemswestengineers.com SWE Proj. No. U003.08

RECORD DRAWING
NOTE: Documents have been corrected as per data supplied by Contractor and Revision / Change Order Drawings. They do not necessarily show all existing conditions and may not be completely accurate. Field verify existing / hidden conditions prior to commencement of new work. DATE: AUGUST 20, 2020

RECORD DRAWINGS

HOMES FOR GOOD OFFICE BUILDING REMODEL

100 WEST 10TH AVENUE EUGENE, OR 97401

SHEET TITLE: SCHEDULES

REVISIONS: # DESCRP. DATE

ISSUE DATE: 08/20/2020

PANEL SCHEDULE

PANEL: L1
 TYPE: BOLT ON AMPS: 250
 VOLTS: 120/208
 LOCATION: FIRST FLOOR ELEC/JAN RM 108-8
 MOUNTING: SURFACE
 PHASE: 3 WIRE: 4
 MAIN: MLO

LOAD CLASS	Conn. VA	Demand Factor	Demand Load VA
LIGHTING	5406	125%	6758
OUTLETS	1897	*	1897
MOTOR LOADS	0	**	0
RESISTANCE LOADS	0	100%	0
SUBFEED	0	100%	0
MISC. LOADS	0	100%	0
SUBFEED BREAKER	0		0

TOTAL VOLT-AMPS		Connected	Demand
MAXIMUM PHASE AMPS		7.303	8.655
		25.0	29.9

NOTES: EXISTING PANEL - SQUARE D POWER LINK
 (N) INDICATES A NEW BREAKER SERVING NEW LOAD.
 (E) INDICATES AN EXISTING BREAKER SERVING AN EXISTING LOAD.
 (EN) INDICATES AN EXISTING BREAKER SERVING A NEW LOAD
 (RP) INDICATES REPLACE AN EXISTING BREAKER WITH BREAKER SIZE SHOWN, BREAKER SHALL MATCH EXISTING PANEL MANUFACTURER.

BREAKER A	P	DESCRIPTION	WATTS	CIR. NO.	PHASE	CIR. NO.	WATTS	DESCRIPTION	BREAKER P	A
20	1	(EN) LTG BASEMENT SOUTH	1185	1	A	2	500	(EN) EXIT SIGNS	1	20
20	1	(EN) LTG BASEMENT NORTH	945	3	B	4		SPARE	1	20
20	1	(EN) LTG FIRST FLOOR SOUTH	1431	5	C	6		(E) LTG BSMNT LUNCH ROOM LL200	1	20
20	1	(EN) LTG FIRST FLOOR NORTH	1183	7	A	8		SPARE	1	20
20	1	(EN) LTG 1ST FLR EXT SOFFIT NORTH,	162	9	B	10		SPARE	1	20
20	1	SPARE		11	C	12		SPARE	1	20
20	1	(E) LTG - CONFERENCE COLD CATHODE		13	A	14		SPARE	1	20
20	1	(E) LTG - FOYER		15	B	16		(E) LTG 1ST/2ND FLR EXIT/STAIT/CORR	1	20
20	1	SPARE		17	C	18		(E) LTG EXTERIOR SOFFIT	1	20
20	1	(E) LTG S CORRIDOR		19	A	20		SPARE	1	20
20	1	(E) LTG SW OFC/RESTROOM		21	B	22		SPARE	1	20
20	1	(E) LTG - LOBBY UP LIGHT AND,		23	C	24		(E) LTG SOUTH TRACK LIGHT	1	20
20	1	(E) LTG - LOBBY UP LIGHT AND DOWN		25	A	26		SPARE	1	20
40	1	(RP) LTG INVERTER	1897	27	B	28		(E) LTG EAST TRACK LIGHT	1	20
20	1	(E) LTG - BRANDING WALL		29	C	30		(E) LTG DATA ROOM PATHWAY	1	20
20	1	(E) LTG - NWEGRESS		31	A	32		SPACE		
20	1	(E) LTG - POLE LIGHTS		33	B	34		SPACE		
20	1	(E) LTG - PLANTER LIGHTS		35	C	36		SPACE		
20	1	(E) LTG - POLE LIGHTS		37	A	38		SPACE		
20	1	(E) LTG - SIGN		39	B	40		SPACE		
20	1	SPACE		41	C	42		SPACE		

PHASE TOTALS	Connected VA	A	B	C	
	2868	1047	1142	1431	* 10kVA at 100%, remainder at 50%
	3585	1309	1428	1789	** 100% plus 25% of the largest Motor
	23.9	8.7	9.5	11.9	
	29.9	10.9	11.9	14.9	

ADD 01

PANEL SCHEDULE

PANEL: L2
 TYPE: BOLT ON AMPS: 250
 VOLTS: 120/208
 LOCATION: 2ND FLR ELEC/JAN RM 223
 MOUNTING:
 PHASE: 3 WIRE: 3
 MAIN: MLO

LOAD CLASS	Conn. VA	Demand Factor	Demand Load VA
LIGHTING	2689	125%	3361
OUTLETS	0	*	0
MOTOR LOADS	0	**	0
RESISTANCE LOADS	0	100%	0
SUBFEED	0	100%	0
MISC. LOADS	0	100%	0
SUBFEED BREAKER	0		0

TOTAL VOLT-AMPS		Connected	Demand
MAXIMUM PHASE AMPS		2.689	3.361
		9.5	11.9

NOTES: EXISTING PANEL - SQUARE D POWER LINK
 (N) INDICATES A NEW BREAKER SERVING NEW LOAD.
 (E) INDICATES AN EXISTING BREAKER SERVING AN EXISTING LOAD.
 (EN) INDICATES AN EXISTING BREAKER SERVING A NEW LOAD
 (RP) INDICATES REPLACE AN EXISTING BREAKER WITH BREAKER SIZE SHOWN, BREAKER SHALL MATCH EXISTING PANEL MANUFACTURER.

BREAKER A	P	DESCRIPTION	WATTS	CIR. NO.	PHASE	CIR. NO.	WATTS	DESCRIPTION	BREAKER P	A
20	1	(E) LTG ELEC ROOM		1	A	2	894	(N) LTG 2ND FLOOR SOUTH	1	20
20	1	(E) LTG EXTERIOR S		3	B	4	1142	(N) LTG 2ND FLOOR NORTH	1	20
20	1	(E) LTG SOFFIT WEST		5	C	6	500	(N) EXIT SIGNS 2ND FLOOR	1	20
20	1	(E) LTG CORRIDOR		7	A	8	153	(N) LTG EXTERIOR SOUTH WALL	1	20
20	1	(E) LTG RICHARDS		9	B	10		SPACE		
20	1	(E) LTG RICHARDS (OFF)		11	C	12		SPACE		
20	1	(E) LTG TRUS JOIST		13	A	14		SPACE		
20	1	(E) LTG TRUS JOIST (OFF)		15	B	16		SPACE		
20	1	(E) LTG LARSON STE207		17	C	18		SPACE		
20	1	(E) LTG OFFICE STE200		19	A	20		SPACE		
20	1	(E) LTG OPEN OFFICE STE200		21	B	22		SPACE		
		SPACE		23	C	24		SPACE		
		SPACE		25	A	26		SPACE		
		SPACE		27	B	28		SPACE		
		SPACE		29	C	30		SPACE		
		SPACE		31	A	32		SPACE		
		SPACE		33	B	34		SPACE		
		SPACE		35	C	36		SPACE		
		SPACE		37	A	38		SPACE		
		SPACE		39	B	40		SPACE		
		SPACE		41	C	42		SPACE		

PHASE TOTALS	Connected VA	A	B	C	
	1047	1047	1142	500	* 10kVA at 100%, remainder at 50%
	1309	1309	1428	625	** 100% plus 25% of the largest Motor
	8.7	8.7	9.5	4.2	
	10.9	10.9	11.9	5.2	

ADD 01


RECORD DRAWING NOTE: Documents have been corrected as per data supplied by Contractor and Revision / Change Order Drawings. They do not necessarily show all existing conditions and may not be completely accurate. Field verify existing / hidden conditions prior to commencement of new work. DATE: AUGUST 20, 2020

RECORD DRAWINGS HOMES FOR GOOD OFFICE BUILDING REMODEL 100 WEST 10TH AVENUE EUGENE, OR 97401


SHEET TITLE: SCHEDULES

Table with 3 columns: #, DESCRP., DATE. Row 1: 1, ADD 01, 05.17.19

ISSUE DATE: 08/20/2020

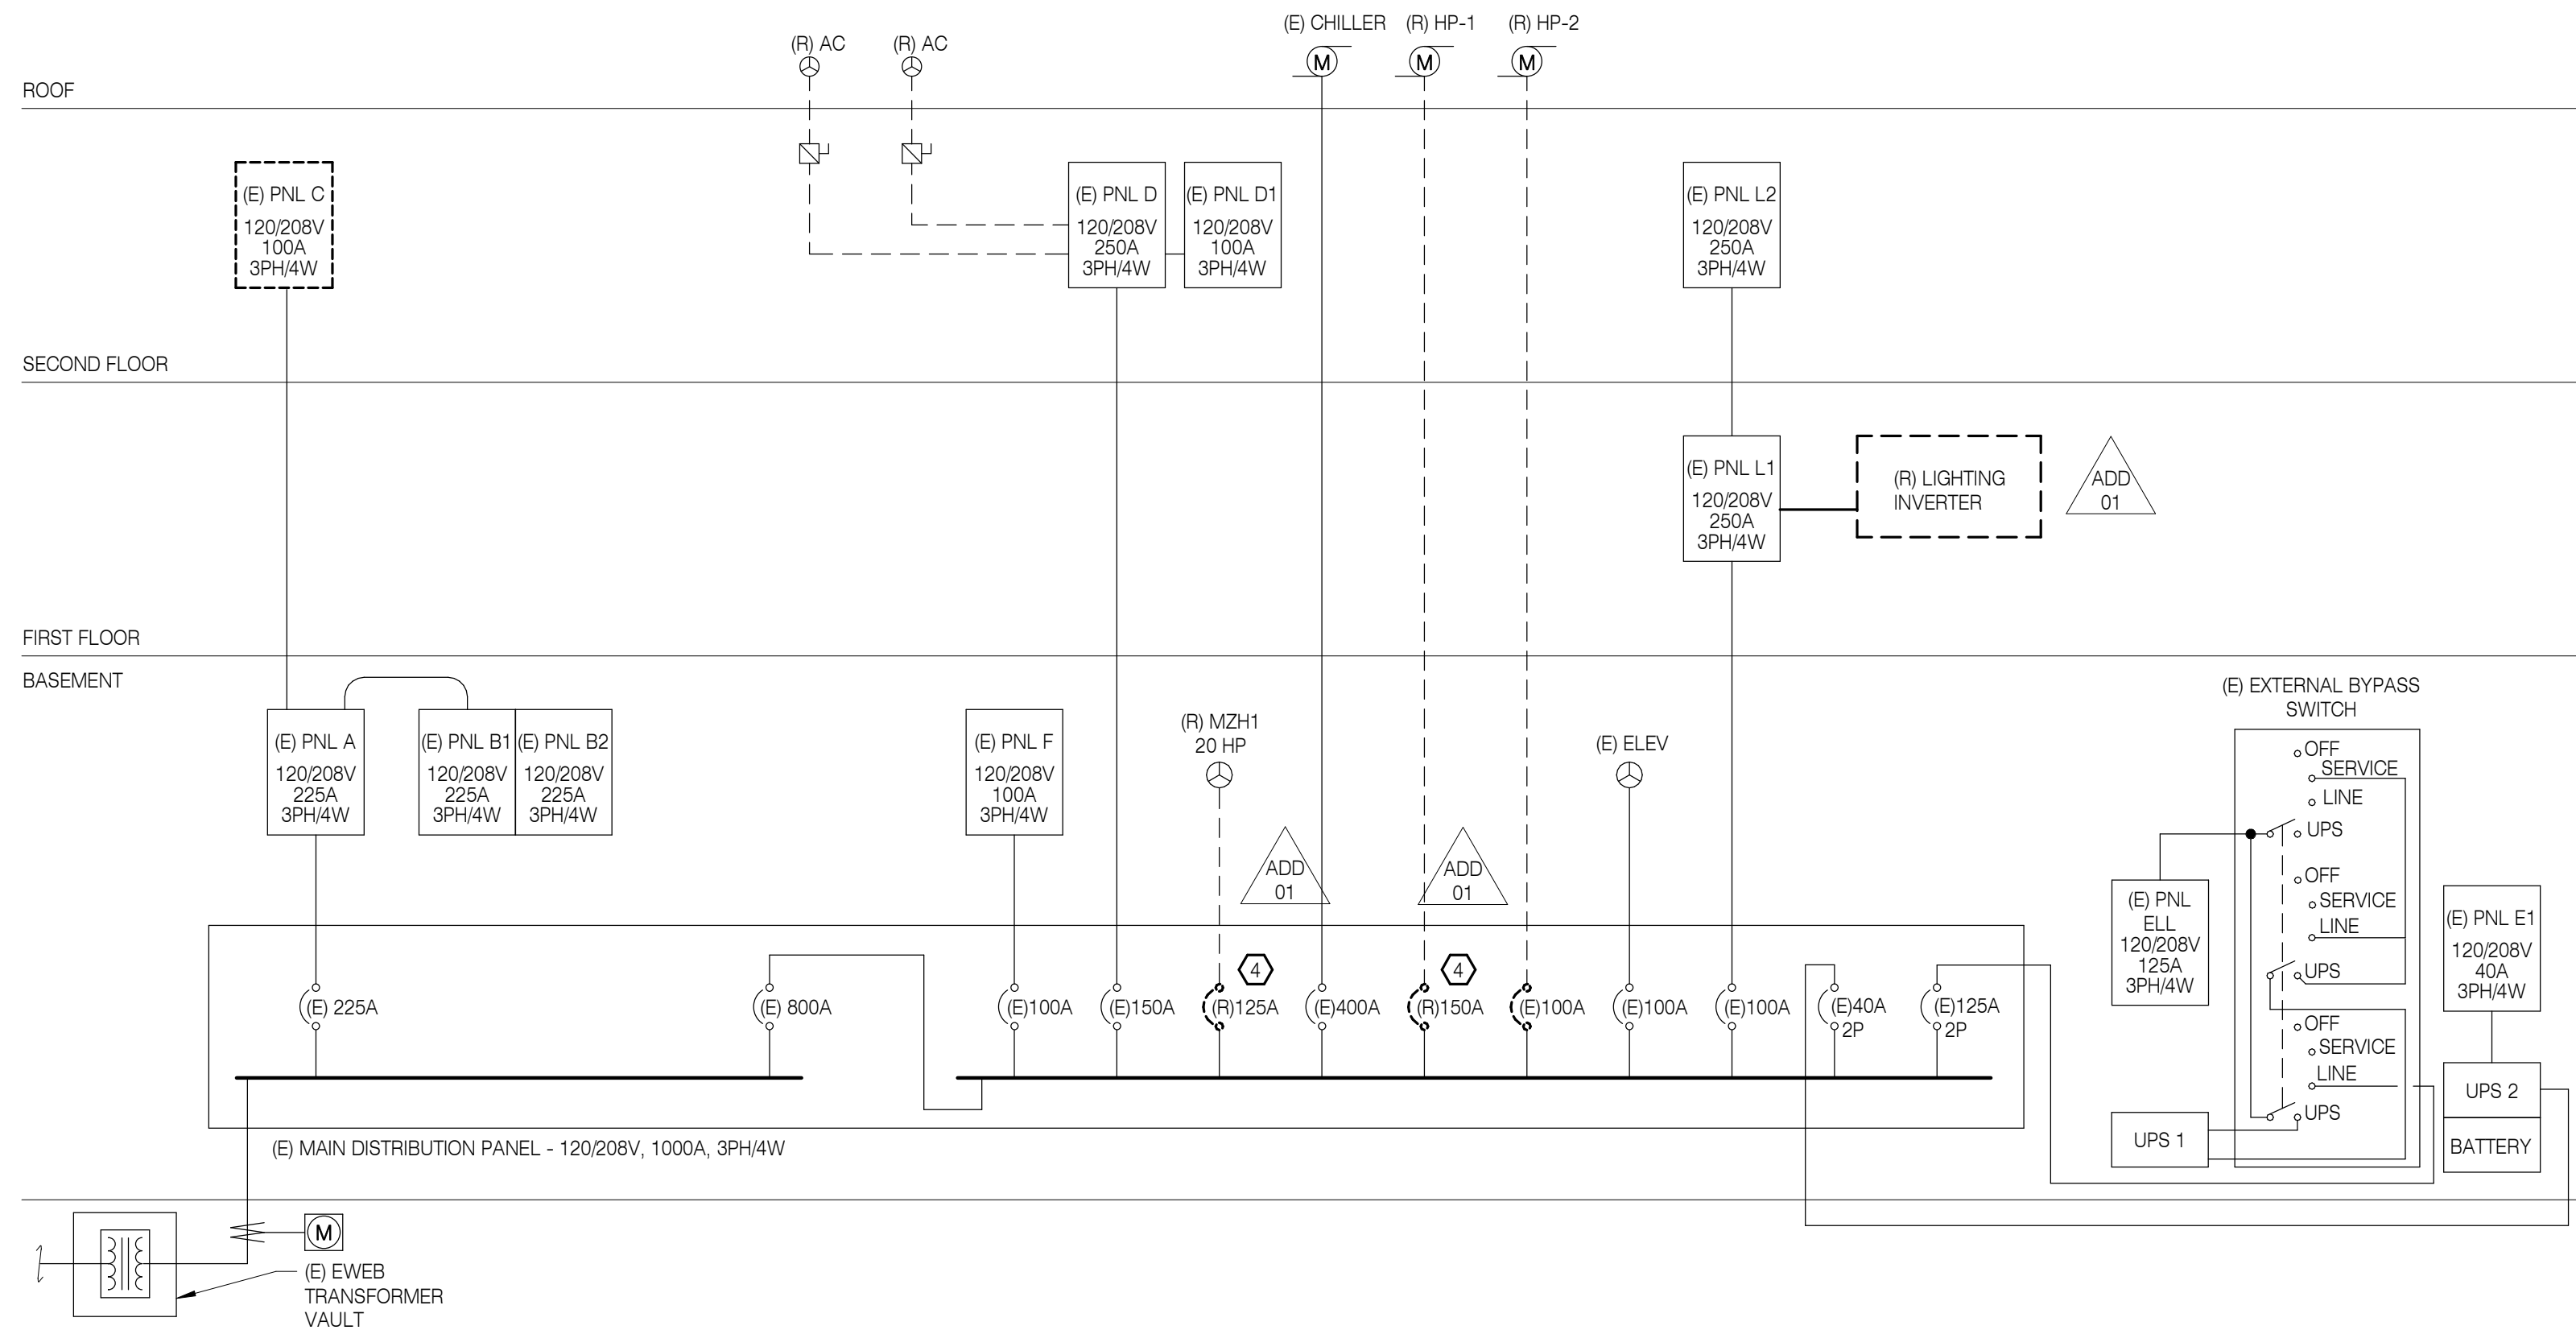

1 ONE-LINE DIAGRAM - DEMOLITION
NOT TO SCALE

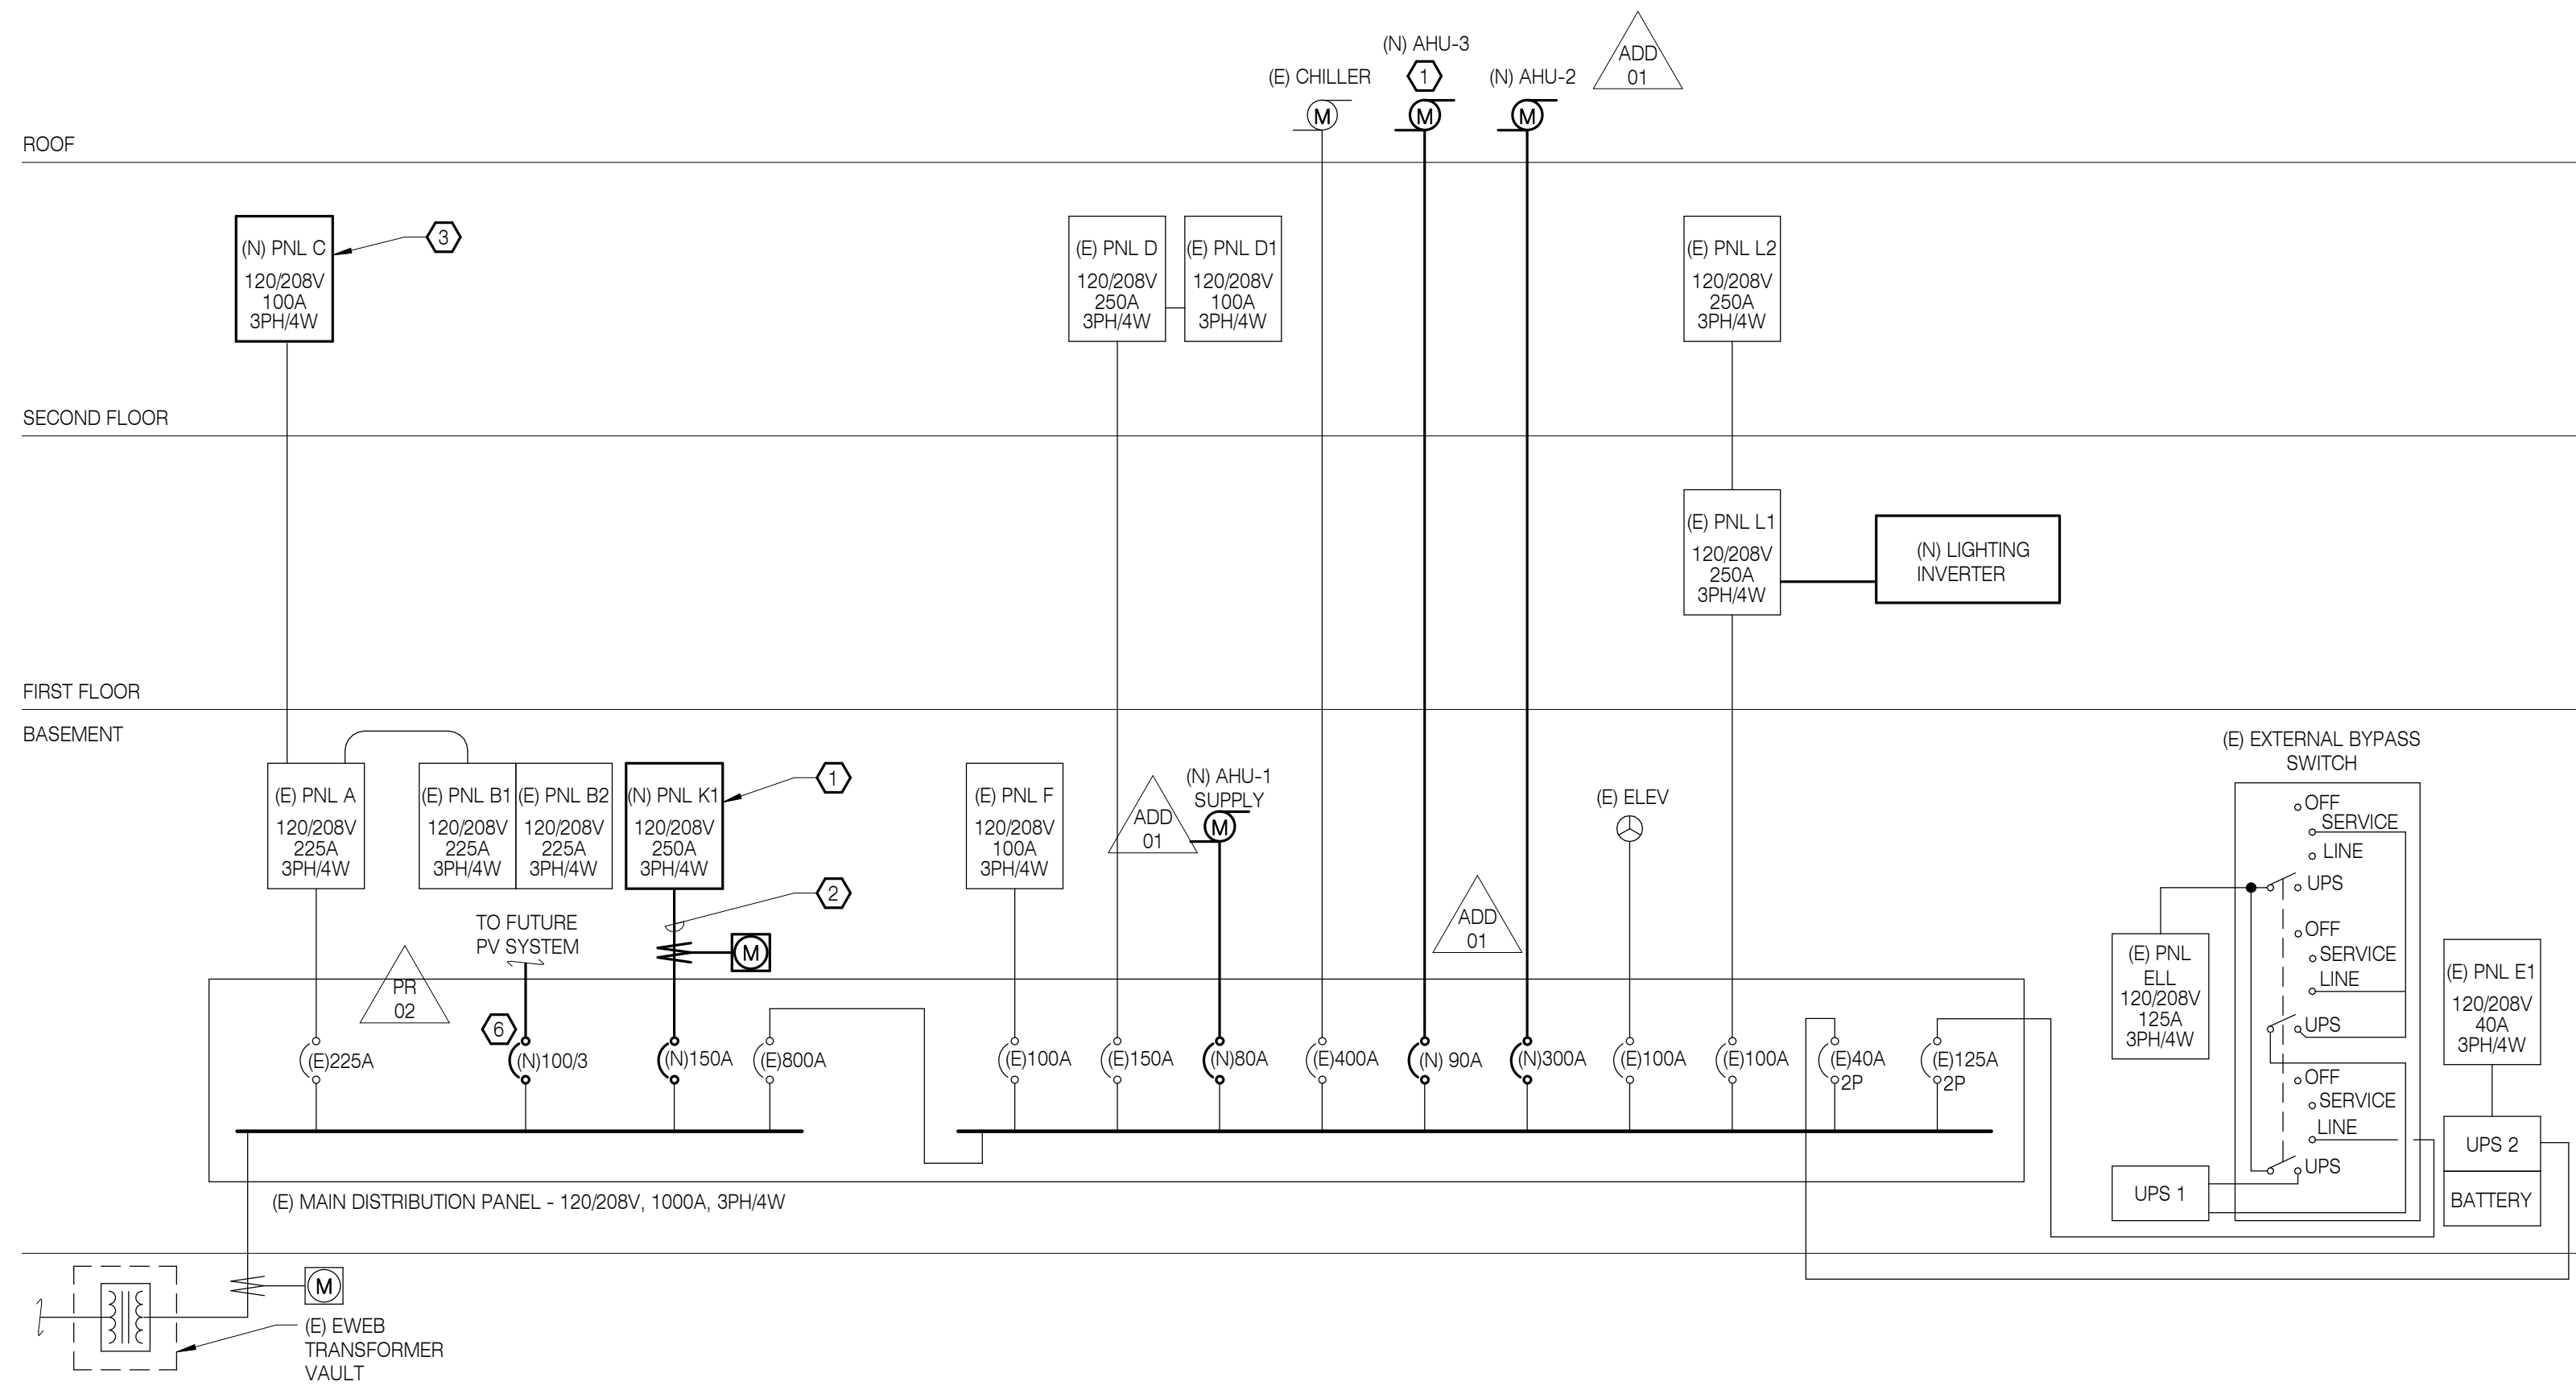

2 ONE-LINE DIAGRAM - NEW
NOT TO SCALE

- SHEET NOTES:**
- SEE MECHANICAL EQUIPMENT CONNECTION SCHEDULE FOR CONNECTION REQUIREMENTS FOR MECHANICAL EQUIPMENT ADDED TO MDP.
- REFERENCE NOTES:**
- PROVIDE NEW 42-SPACE PANEL UTILIZING SPARE SPACE IN DISTRIBUTION SECTION. EXTEND EXISTING CIRCUITS SERVING KAISER TENANT SPACE IDENTIFIED ON PANEL SCHEDULES TO NEW PANEL.
 - PROVIDE BRANCH FEEDER (4) #1/0, (1) #6 GND IN 2" C.
 - PROVIDE NEW 42-SPACE PANEL REPLACING EXISTING 30-SPACE PANEL. SERVE NEW PANEL BY EXISTING FEEDER AND 100A BREAKER IN PANEL 'A'.
 - RETURN CIRCUIT BREAKER TO OWNER.
 - UNIT TO BE CONNECTED FOR TEMPORARY USE DURING CONSTRUCTION. UNIT TO BE REMOVED UPON COMPLETION OF PROJECT. COORDINATE WITH MECHANICAL.
 - PROVIDE 100 AMP, 3-POLE SPARE CIRCUIT BREAKER TO MATCH EXISTING SQ D EQUIPMENT FOR PV SYSTEM.

PIVOT
ARCHITECTURE

RECORD DRAWING
20 AUGUST 2020

SW
E
SYSTEMS WEST
ENGINEERS
725 A Street
Springfield, OR 97477
541.342.7210
systemswestengineers.com
SWE Proj. No. U003.08

RECORD DRAWING
NOTE: Documents have been corrected as per data supplied by Contractor and Revision / Change Order Drawings. They do not necessarily show all existing conditions and may not be completely accurate. Field verify existing / hidden conditions prior to commencement of new work.
DATE: AUGUST 20, 2020

RECORD DRAWINGS
HOMES FOR GOOD OFFICE BUILDING
REMODEL
100 WEST 30TH AVENUE
EUGENE, OR 97401

SHEET TITLE:
ONE-LINE DIAGRAMS

REVISIONS:

#	DESCRP.	DATE
1	ADD 01	05.17.19
3	PR 02	07.24.19

ISSUE DATE: 08/20/2020

E611

MECHANICAL LEGEND

PIPING

SYMBOL	ABBREV.	DESCRIPTION	SYMBOL	ABBREV.	DESCRIPTION
FIRE PROTECTION PIPING:					
	F	FIRE SPRINKLER SUPPLY			PIPING UP
					PIPING DOWN
		SLOPE OF PIPE IN DECIMALS OF FEET			CAPPED PIPE
PLUMBING PIPING:					
	CW	POTABLE COLD WATER			PIPE REDUCING FITTING: CONCENTRIC, ECCENTRIC
	HW	POTABLE HOT WATER			DIRECTION OF FLOW
	HWR	POTABLE HOT WATER RETURN			UNION
	TW	POTABLE TEMPERED HOT WATER			PUMP
	NP	NON-POTABLE COLD WATER		DV	DRAIN VALVE
	W	SANITARY WASTE		BV	BALL VALVE
	V	VENT		BFV	BUTTERFLY VALVE
	D	DRAIN		CHV	CHECK VALVE
FUEL PIPING:					
	G(*)	NATURAL GAS (*=SUPPLY PRESSURE)		AV	AUTOMATIC CONTROL VALVE: 2-WAY
	AV	AUTOMATIC CONTROL VALVE: 3-WAY		SV	SOLENOID VALVE
HYDRONIC PIPING:					
	CWS	CHILLED WATER SUPPLY		PRV	PRESSURE REGULATING VALVE
	CWR	CHILLED WATER RETURN			FLEXIBLE PIPE CONNECTION
	HS	HEATING WATER SUPPLY			WYE STRAINER
	HR	HEATING WATER RETURN		RV	RELIEF VALVE
	CD	CONDENSATE DRAIN		SRV	SAFETY RELIEF VALVE (HYDRONIC)
REFRIGERANT PIPING:					
	RL	REFRIGERANT LIQUID		CFR	CONSOLIDATED FITTING RETURN
	RS	REFRIGERANT SUCTION		CFS	CONSOLIDATED FITTING SUPPLY
	RHG	REFRIGERANT HOT GAS		ES	WATER FLOW SWITCH
	MAV	MANUAL AIR VENT		AAV	AUTOMATIC AIR VENT
		THERMOMETER			PRESSURE GAUGE
		TEST PLUG		F	FLOW INDICATOR
	FMS	FLOW MEASURING STATION		FMS	FLOW MEASURING STATION
	FD	FLOOR DRAIN		FMS	FLOW MEASURING STATION
	RP	REDUCED PRESSURE BACKFLOW PREVENTER			

DUCTWORK

SYMBOL	DESCRIPTION	SYMBOL	DESCRIPTION
	SA RECTANGULAR SUPPLY AIR DUCT UP		RA RECTANGULAR RETURN AIR DUCT UP
	EA RECTANGULAR EXHAUST AIR UP		OSA RECTANGULAR OUTSIDE AIR UP
	SA RECTANGULAR SUPPLY AIR DUCT UP		RA RECTANGULAR RETURN AIR DN
	EA RECTANGULAR EXHAUST AIR UP		OSA RECTANGULAR EXHAUST AIR or OUTSIDE AIR DN
	RD RECTANGULAR EXHAUST AIR or OUTSIDE AIR DN		RD ROUND DUCTWORK UP
	RD ROUND DUCTWORK DOWN		TV TURN VANE ELBOW
	SE STANDARD RADIUS ELBOW		FD FLEXIBLE DUCT CONNECTION
	DS DUCT SIZE: WIDTH x DEPTH		SD-1 DIFFUSER TYPE SIZE - BLOW PATTERN (4-WAY IF NONE SHOWN) AIR VOLUME IN CUBIC FEET per MINUTE (CFM)
	RG-1 GRILLE TYPE SIZE AIR VOLUME IN CUBIC FEET per MINUTE (CFM)		RG-2 GRILLE TYPE SIZE AIR VOLUME IN CUBIC FEET per MINUTE (CFM)
	EG-1 GRILLE TYPE SIZE AIR VOLUME IN CUBIC FEET per MINUTE (CFM)		EG-2 GRILLE TYPE SIZE AIR VOLUME IN CUBIC FEET per MINUTE (CFM)
	SD-2 SLOT DIFFUSER TYPE LENGTH - # OF SLOTS - INLET SIZE AIR VOLUME IN CUBIC FEET per MINUTE (CFM)		ILW INTERNALLY LINED OR DOUBLE WALL DUCTWORK
	MDV MANUAL VOLUME DAMPER		SDS DUCT SMOKE DETECTOR
	DHD DUCT HEAT DETECTOR		F D FIRE DAMPER
	CFS COMBINATION FIRE/SMOKE DAMPER: HORIZONTAL BLADE		V B VERTICAL BLADE
	ACD AUTOMATIC CONTROL DAMPER		RDC RECTANGULAR DUCT ANGLED CHANGE IN ELEVATION
	RDC ROUND DUCT ANGLED CHANGE IN ELEVATION		CT CONCENTRIC TRANSITION
	ECT ECCENTRIC TRANSITION		MTV MITERED TEE WITH TURNING VANES
	MEB MITERED ELBOW WITH BRANCH FITTING		45 LB 45 DEGREE LATERAL BRANCH, ROUND
	45 EB 45 DEGREE ENTRY BRANCH, ROUND OR RECTANGULAR		CB 45 DEGREE ENTRY BRANCH, ROUND OR RECTANGULAR

GENERAL

SYMBOL	ABBREVIATION	DESCRIPTION
(E)		EXISTING
∅ OR dia		DIAMETER
		NEW TO EXISTING POINT OF CONNECTION
		NOTE REFERENCE MARKER
		PLAN OR DETAIL REFERENCE MARKER
		SECTION REFERENCE MARKER W/VIEW DIRECTION
		EQUIPMENT MARKER
		ROOM NUMBER
		NEW WORK SHOWN BOLD
		EXISTING SHOWN LIGHT
		EXISTING TO BE REMOVED
		AREA NOT IN SCOPE OF WORK

CONTROLS

SYMBOL	DESCRIPTION	SYMBOL	DESCRIPTION
	PROCESS PIPING SIGNAL		AUTOMATIC CONTROL DAMPER
	ELECTRICAL SIGNAL		FLOW SWITCH
	SPACE SENSOR		EMERGENCY STOP SWITCH
	SPACE HUMIDITY		BAS INPUT/OUTPUT POINT
	SPACE CARBON DIOXIDE SENSOR		ALARM
	SPACE CARBON MONOXIDE SENSOR		MOTOR STARTER (W/EQUIPMENT INDICATED UNDERLINE)
	TEMPERATURE MEASUREMENT		EQUIPMENT CONTROL PANEL (W/EQUIP. INDICATED UNDERLINED)
	PRESSURE MEASUREMENT		EQUIPMENT CONTROL PANEL (W/EQUIP. INDICATED UNDERLINED)
	HUMIDITY MEASUREMENT		EQUIPMENT CONTROL PANEL (W/EQUIP. INDICATED UNDERLINED)
	FLOW MEASUREMENT		EQUIPMENT CONTROL PANEL (W/EQUIP. INDICATED UNDERLINED)
	ELECTRICAL CURRENT/POWER		EQUIPMENT CONTROL PANEL (W/EQUIP. INDICATED UNDERLINED)
	GAS CONNECTION		EQUIPMENT CONTROL PANEL (W/EQUIP. INDICATED UNDERLINED)
	RELAY OR SWITCH		EQUIPMENT CONTROL PANEL (W/EQUIP. INDICATED UNDERLINED)
	ACTUATOR - ELECTRIC		EQUIPMENT CONTROL PANEL (W/EQUIP. INDICATED UNDERLINED)

GENERAL NOTES

1. THE CLINIC PORTION OF THE FACILITY WILL REMAIN IN OPERATION DURING CONSTRUCTION. COORDINATE ALL SHUTDOWNS AND CONSTRUCTION ACTIVITY WITH FACILITIES STAFF.
2. SIZE AND LOCATION OF ALL PIPING AND OTHER MECHANICAL EQUIPMENT IS APPROXIMATE. CONTRACTOR SHALL SITE VERIFY THE LOCATION OF EXISTING PIPING AND EQUIPMENT AND CONSTRUCT WORK FROM FIELD DIMENSIONS. CONTRACTOR SHALL MAKE ADJUSTMENTS NECESSARY TO ACCOMMODATE MINOR DEVIATIONS AT NO COST TO OWNER.
3. FINE (LIGHT) LINE WORK INDICATES EXISTING PIPING AND OTHER MECHANICAL EQUIPMENT. BOLD (HEAVY) LINE WORK INDICATES NEW PIPING AND OTHER MECHANICAL EQUIPMENT.
4. IT IS RESPONSIBILITY OF THE CONTRACTOR TO PROVIDE CUTTING AND PATCHING TO ALLOW THE INSTALLATION OF MATERIALS AND EQUIPMENT AS SPECIFIED AND SHOWN ON DRAWINGS.

ABBREVIATIONS

ACH	AIR CHANGES PER HOUR	IN	INCHES
AFF	ABOVE FINISHED FLOOR	IN WC	INCHES WATER COLUMN
AFS	AUTOMATIC FIRE SPRINKLER	IPLV	INTEGRATED PART LOAD VALUE
AL	ALUMINUM	IW	INDIRECT WASTE
ALT	ALTERNATE	LAT	LEAVING AIR TEMPERATURE
APD	AIR PRESSURE DROP	LBS	POUNDS
BAS	BUILDING AUTOMATION SYSTEM	LWT	LEAVING WATER TEMPERATURE
BHP	BRAKE HORSEPOWER	Ma	MILLIAMPERE
BOD	BOTTOM OF DUCT	MAX	MAXIMUM
BTUH	BRITISH THERMAL UNITS PER HOUR	MBH	THOUSAND BTUs per HOUR
CFH	CUBIC FEET per HOUR	MCA	MINIMUM CIRCUIT AMPS
CFM	CUBIC FEET per MINUTE	MFGR	MANUFACTURER
CMU	CONCRETE MASONRY UNIT	MIN	MINIMUM
CONC	CONCRETE	MOP	MAX. OVERCURRENT PROTECTION
CONT	CONTINUATION	NO	NOISE CRITERIA
DB	DRY BULB	NC	NORMALLY CLOSED
Dba	DECIBELS ACOUSTIC	NIC	NOT IN CONTRACT
DN	DOWN	NO	NORMALLY OPEN
DP	DIFFERENTIAL PRESSURE	NPLV	NON-STANDARD PART LOAD VALUE
EAT	ENTERING AIR TEMPERATURE	NPSH	NET POSITIVE SUCTION HEAD
EER	ENERGY EFFICIENCY RATIO	OFCI	OWNER FURNISHED/ CONTRACTOR INSTALLED
EFF	EFFICIENCY	PD	PRESSURE DROP
ESP	EXTERNAL STATIC PRESSURE	PH	PHASE
EWT	ENTERING WATER TEMPERATURE	PPH	POUNDS per HOUR
FLA	FULL LOAD AMPS	PSI	POUNDS per SQUARE INCH GAUGE
FPM	FEET PER MINUTE	REQD	REQUIRED
FT	FEET	RF	RETURN FAN
FT WC	FEET WATER COLUMN	RH	RELATIVE HUMIDITY
FUT	FUTURE	RPM	REVOLUTIONS per MINUTE
GPH	GALLONS PER HOUR	SEER	SEASONAL ENERGY EFFICIENCY RATIO
GPM	GALLONS PER MINUTE	SF	SUPPLY FAN
GYP BD	GYPSONUM WALL BOARD	SS	STAINLESS STEEL
HP	HORSEPOWER	STL	STEEL
HSPF	HEATING SEASONAL PERFORMANCE FACTOR	TSP	TOTAL STATIC PRESSURE
HVAC	HEATING, VENTILATING, & AIR CONDITIONING	TYP	TYPICAL
HZ	HERTZ (CYCLES PER SECOND)	VFD	VARIABLE FREQUENCY DRIVE
IAQ	INDOOR AIR QUALITY	WB	WET BULB
IE	INVERT ELEVATION	WC	WATER COLUMN
		WG	WATER GAUGE


SHEET INDEX - MECHANICAL

M001	LEGEND, GENERAL NOTES, & MECHANICAL SHEET INDEX
M101	MECHANICAL DEMOLITION - LOWER LEVEL
M102	MECHANICAL DEMOLITION - FIRST FLOOR
M103	MECHANICAL DEMOLITION - SECOND FLOOR
M104	MECHANICAL DEMOLITION - ROOF PLAN
M121	AIR DISTRIBUTION - LOWER LEVEL
M122	AIR DISTRIBUTION - FIRST FLOOR
M123	AIR DISTRIBUTION - SECOND FLOOR
M124	AIR DISTRIBUTION - ROOF PLAN
M131	MECHANICAL PIPING - LOWER LEVEL
M132	MECHANICAL PIPING - FIRST FLOOR
M133	MECHANICAL PIPING - SECOND FLOOR
M401	AIR DISTRIBUTION - ENLARGED MECHANICAL ROOM
M402	MECHANICAL PIPING - ENLARGED MECHANICAL ROOM
M521	DETAILS
M531	DETAILS
M601	SCHEDULES
M611	DIAGRAMS
M701	ZONE MAP - LOWER LEVEL
M702	ZONE MAP - FIRST FLOOR
M703	ZONE MAP - SECOND FLOOR

RECORD DRAWING

NOTE: Documents have been corrected as per data supplied by Contractor and Revision / Change Order Drawings. They do not necessarily show all existing conditions and may not be completely accurate. Field verify existing / hidden conditions prior to commencement of new work.

DATE: AUGUST 20, 2020

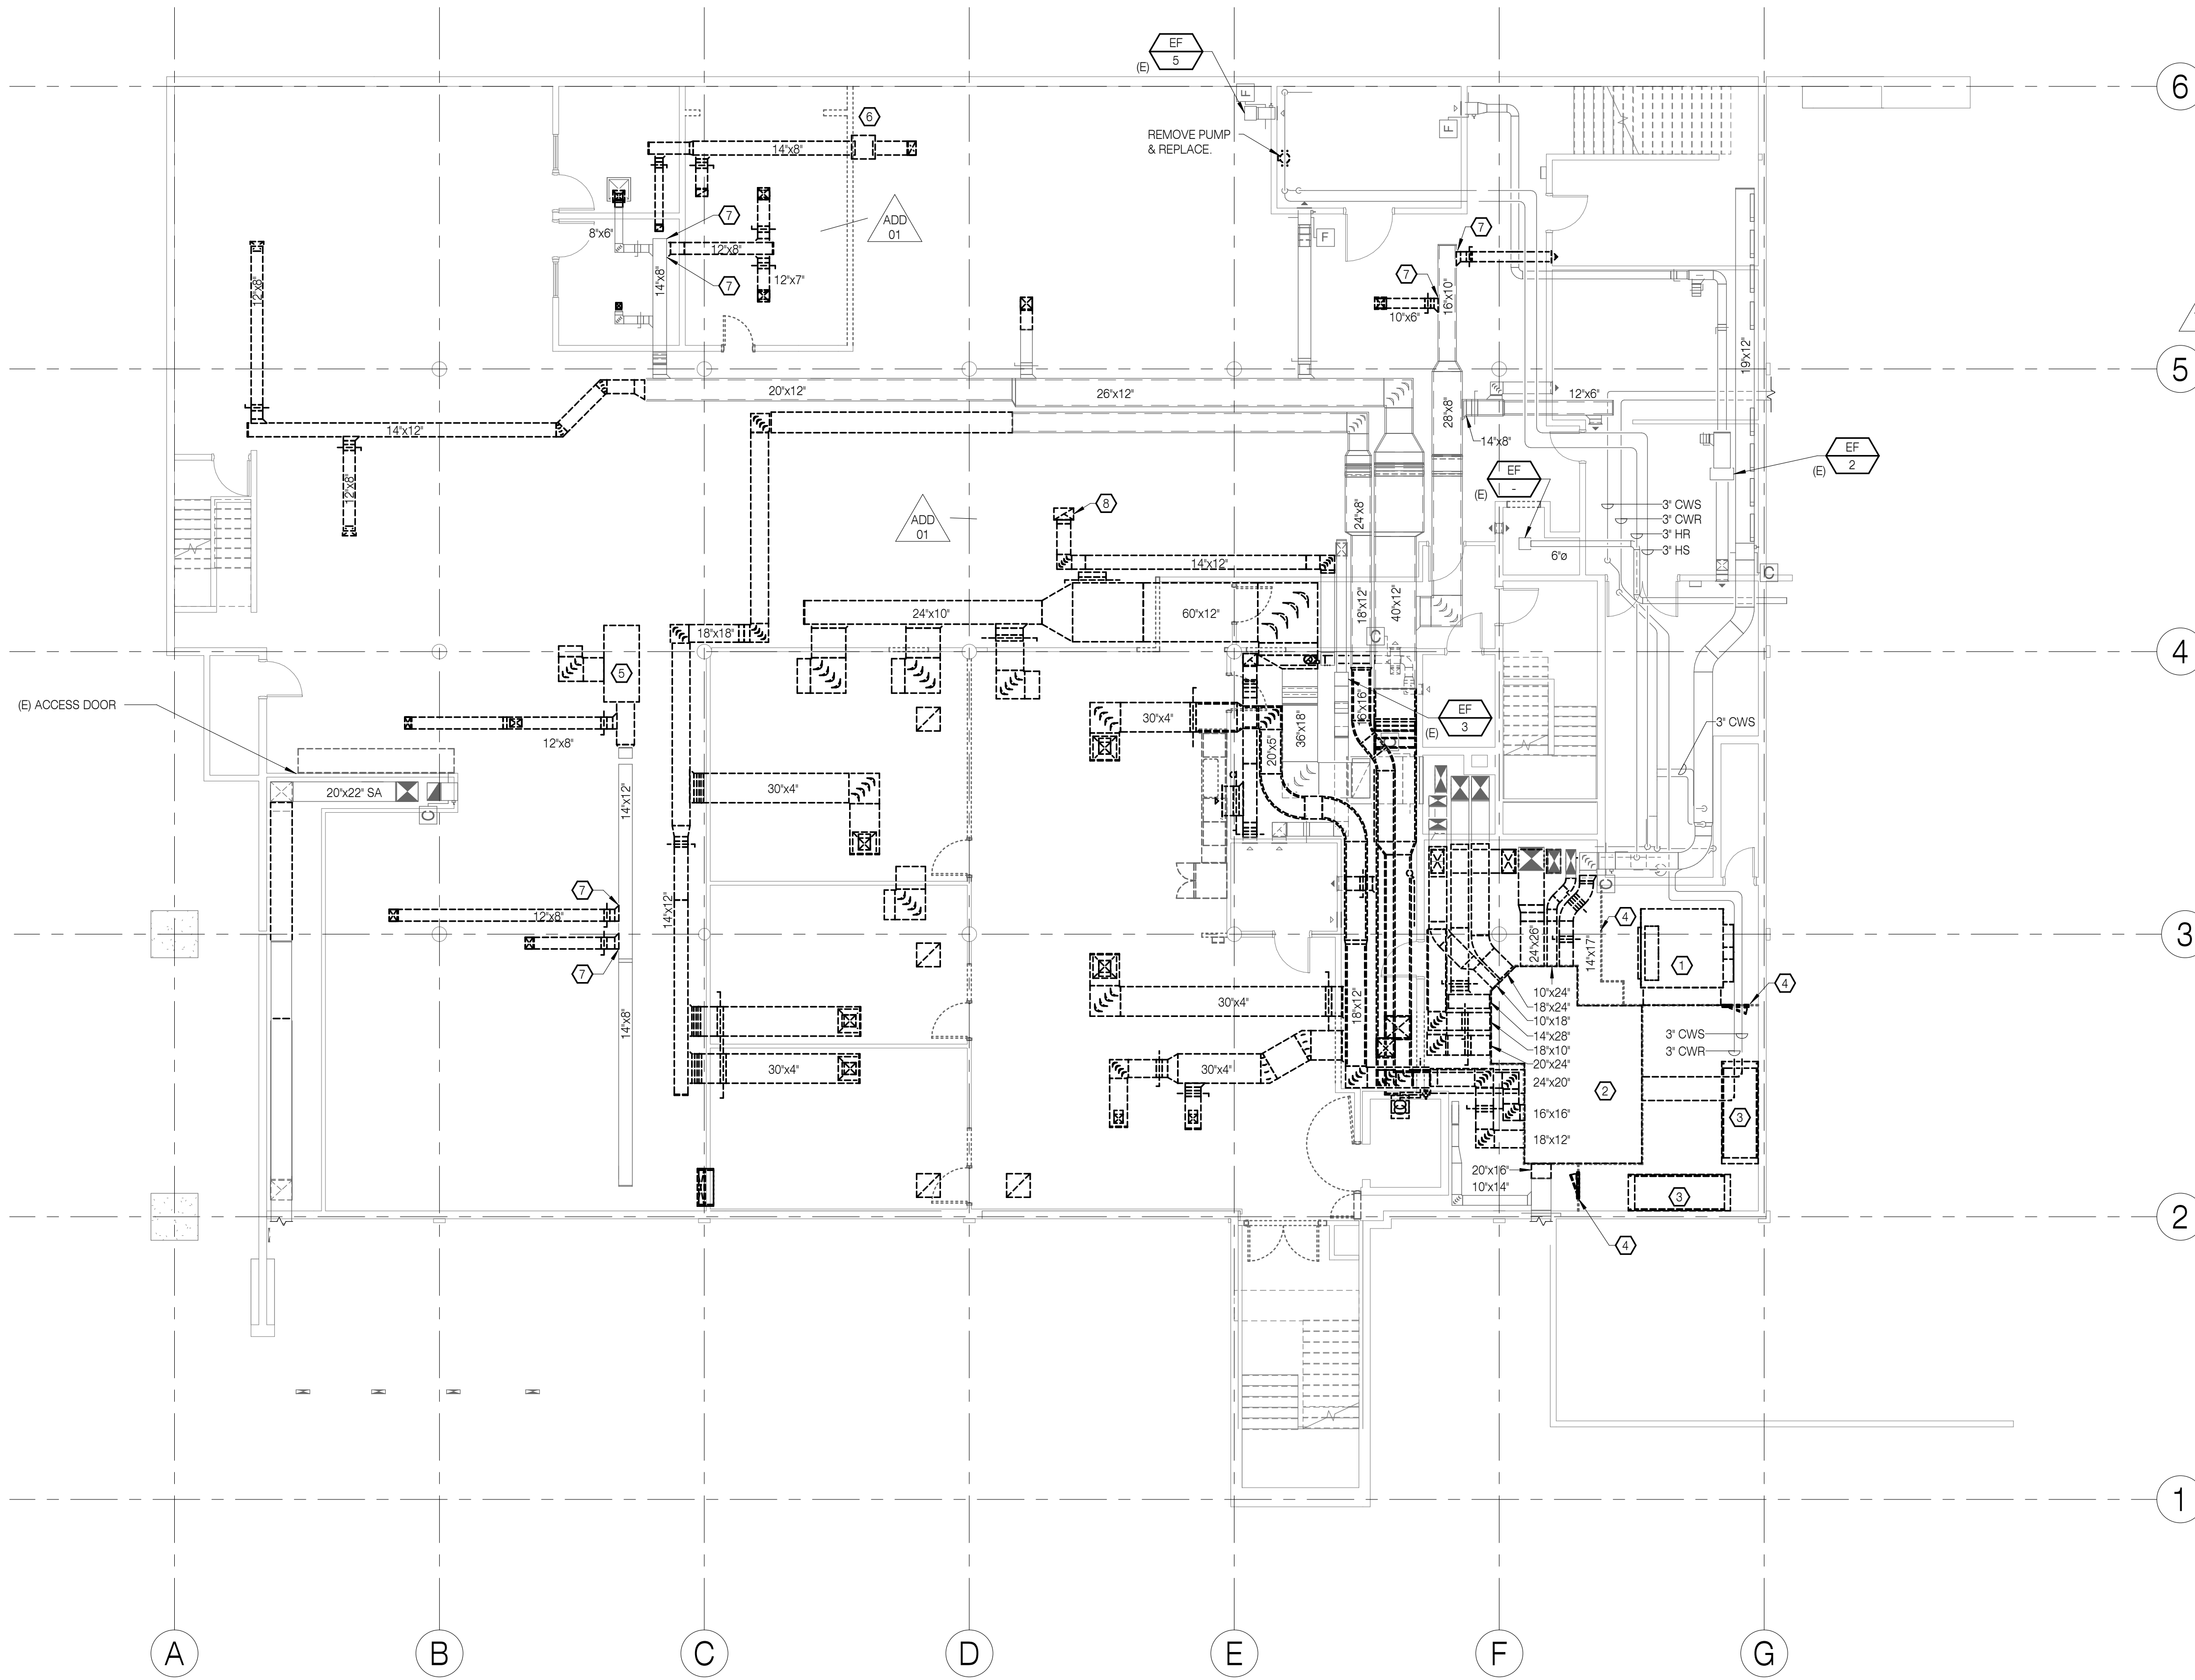

SHEET NOTES:

1. REMOVAL OF EQUIPMENT, PIPING, & VALVES INCLUDES ASSOCIATED HANGERS, SUPPORTS, AND APPURTENANCES.
2. SALVAGE DEMOLISHED DUCTWORK WERE APPLICABLE FOR RE-USE. SEE NEW AIR DISTRIBUTION PLANS FOR APPLICABLE LOCATIONS.


REFERENCE NOTES:

- ① REMOVE MULTIZONE SUPPLY FAN. REMOVE ASSOCIATED CONTROLS.
- ② REMOVE MULTIZONE HEATING COIL AND COOLING COIL. REMOVE ASSOCIATED PIPING.
- ③ REMOVE PREVIOUSLY DECOMMISSIONED 40 TON CHILLER.
- ④ REMOVE EXISTING SHEET METAL PARTITIONS AND DOORS FROM MECHANICAL ROOM.
- ⑤ REMOVE AC UNIT. REMOVE ASSOCIATED CONTROLS.
- ⑥ REMOVE RETURN FAN. REMOVE ASSOCIATED CONTROLS.
- ⑦ CAP AND SEAL AIRTIGHT DUCTWORK TO REMAIN.
- ⑧ REMOVE EXISTING EXHAUST DUCTWORK BACK TO EXISTING FIRE DAMPER LOCATED IN FIRST FLOOR SLAB AND TEMPORARILY CAP. NEW EXHAUST DUCTWORK WILL RE-CONNECT TO EXISTING EXHAUST RISER. FOR NEW DUCTWORK SEE 1/M121. RELOCATE FIRE DAMPER ACCESS TO FIRST FLOOR SIDE OF DAMPER. SEE 1/M122 FOR NEW FIRE DAMPER ACCESS LOCATION.


RECORD DRAWING
 NOTE: Documents have been corrected as per data supplied by Contractor and Revision / Change Order Drawings. They do not necessarily show all existing conditions and may not be completely accurate. Field verify existing / hidden conditions prior to commencement of new work.
 DATE: AUGUST 20, 2020

REVISIONS:

#	DESCRP.	DATE
1	ADD 01	05.17.19

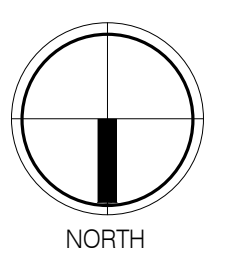

1 MECHANICAL DEMOLITON - LOWER LEVEL
 1/8" = 1'-0"

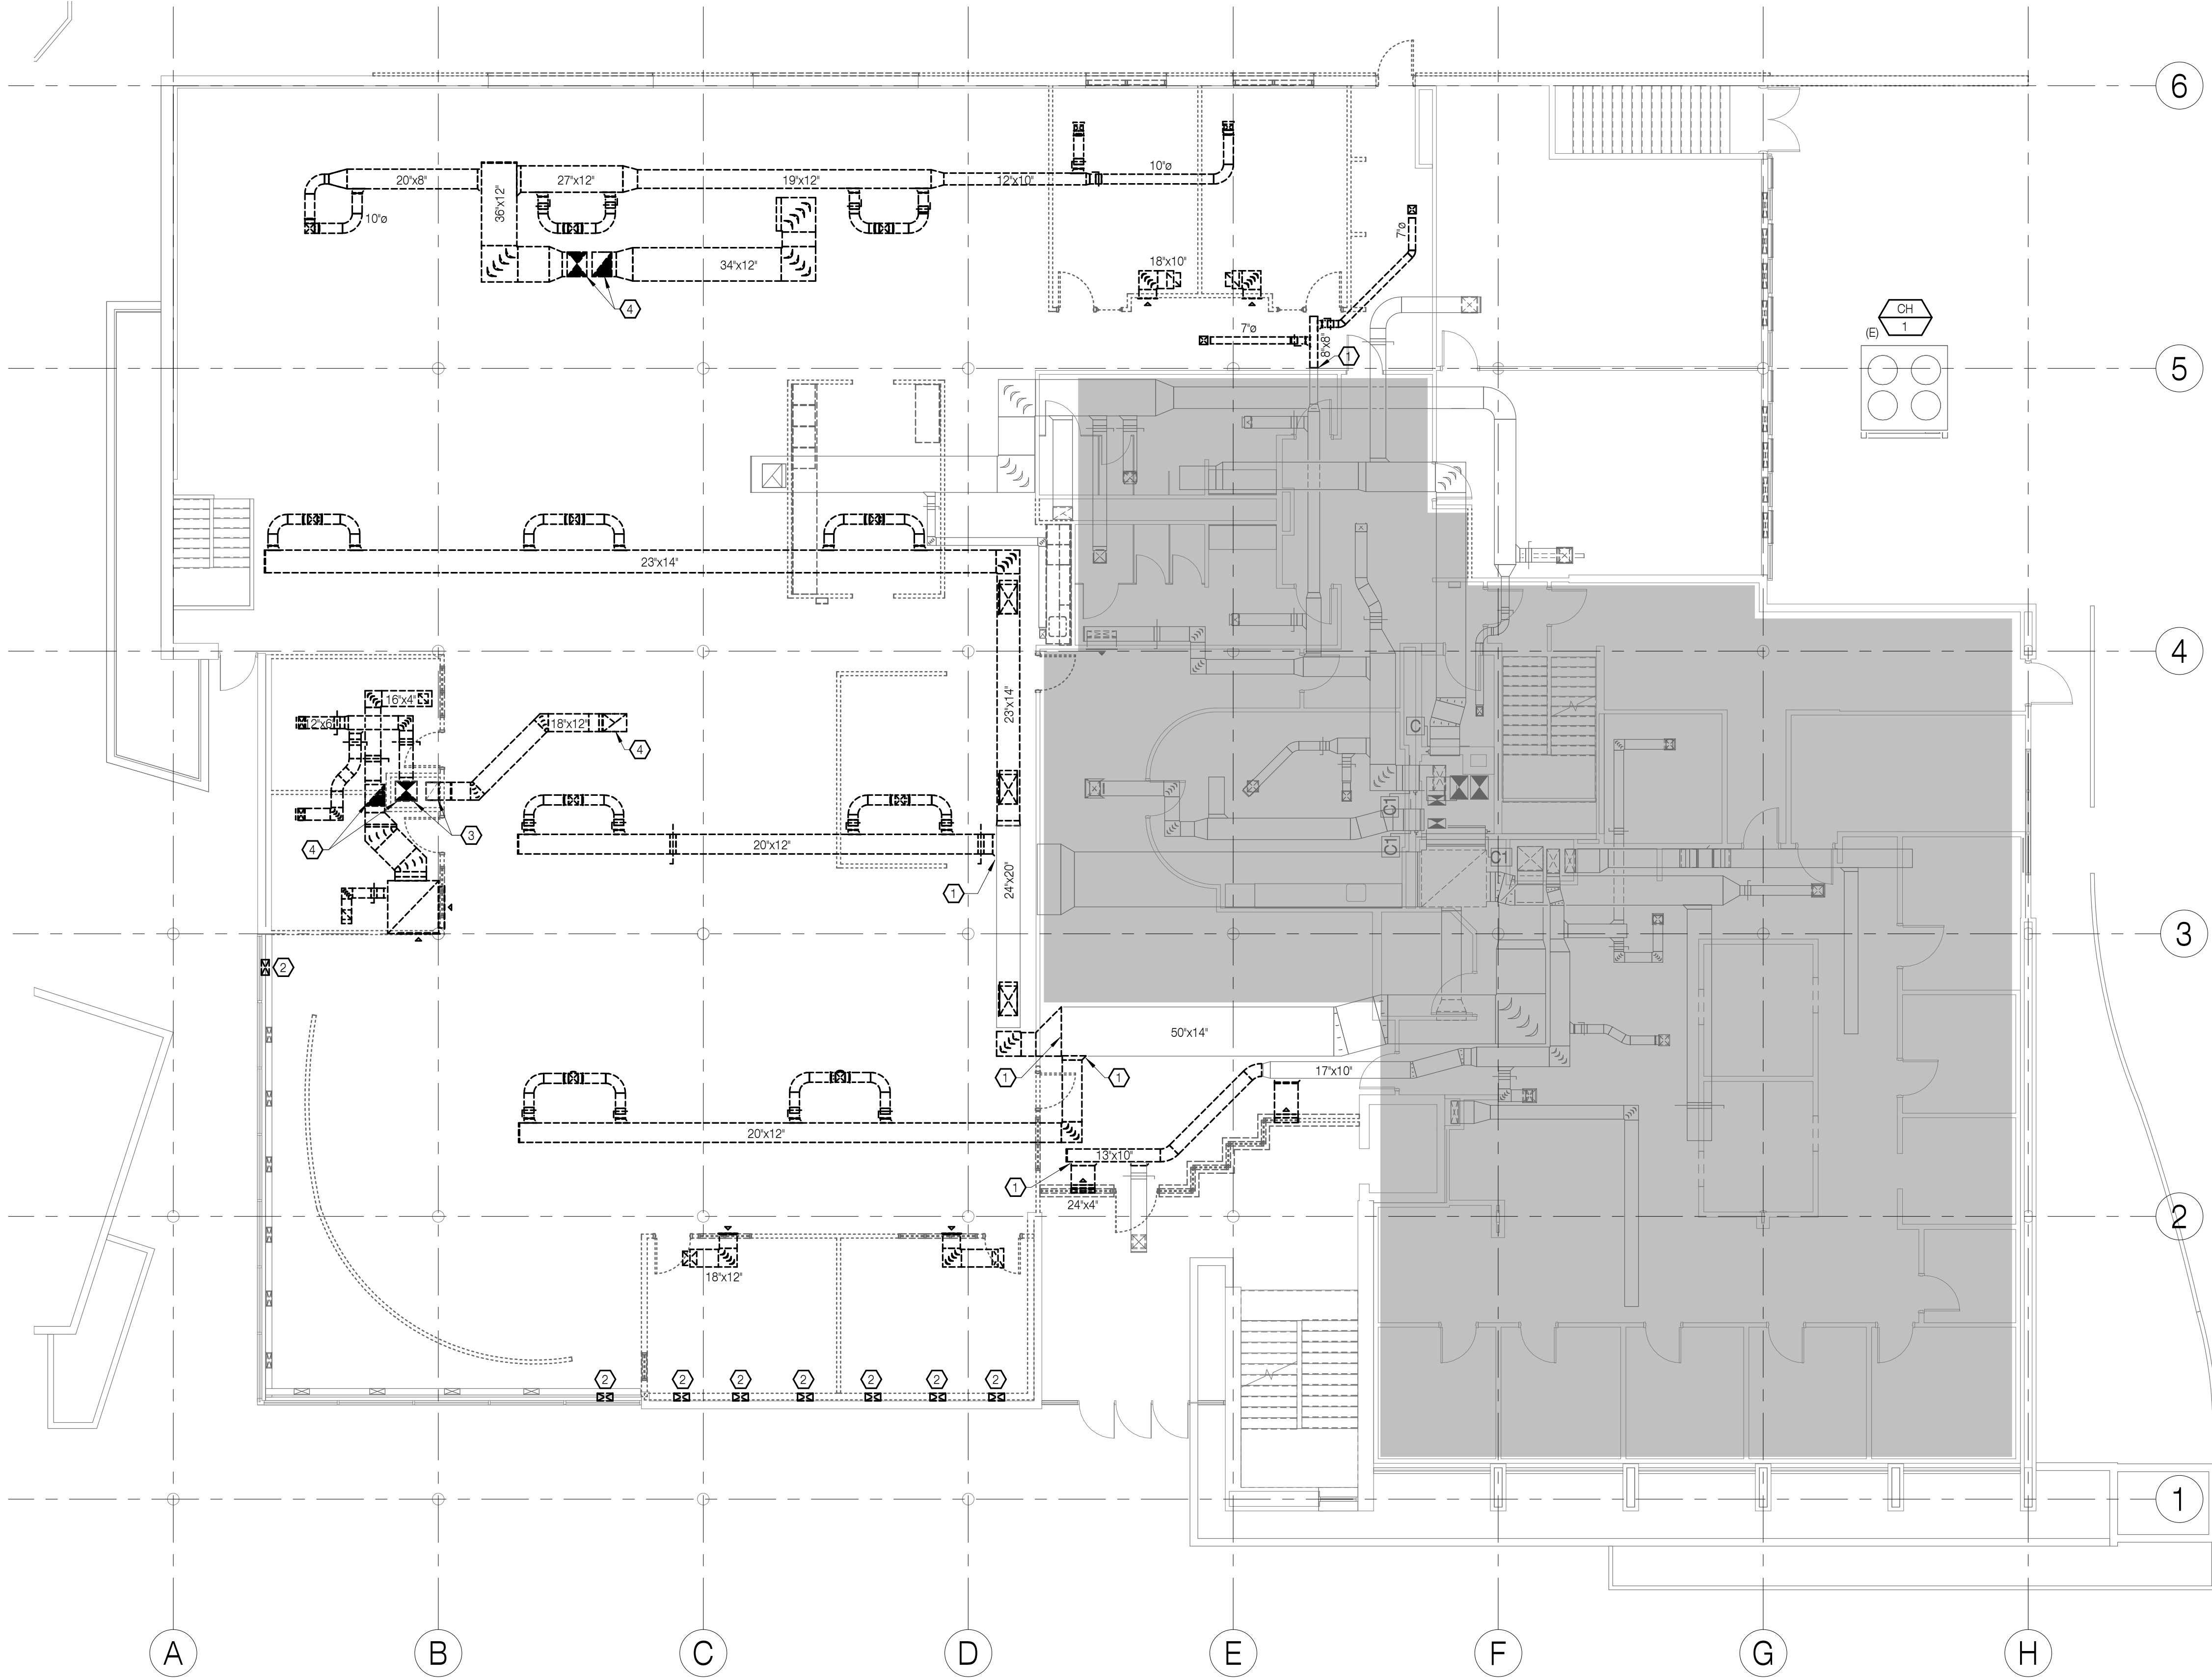

SHEET NOTES:


1. REMOVAL OF EQUIPMENT, PIPING, & VALVES INCLUDES ASSOCIATED HANGERS, SUPPORTS, AND APPURTENANCES.
2. SALVAGE DEMOLISHED DUCTWORK WHERE APPLICABLE FOR RE-USE. SEE NEW AIR DISTRIBUTION PLANS FOR APPLICABLE LOCATIONS.


REFERENCE NOTES:

- 1 CAP/PATCH AND SEAL AIRTIGHT DUCTWORK TO REMAIN.
- 2 REMOVE GRILLE
- 3 DISCONNECT EXISTING DUCTWORK AT TOP OF CHASE. DUCTWORK DOWN THROUGH CHASE TO REMAIN FOR RECONNECTION. SEE 1/M121 & 1/M122 FOR NEW CONNECTIONS.
- 4 REMOVE DUCTWORK UP THROUGH ROOF.

RECORD DRAWING
 NOTE: Documents have been corrected as per data supplied by Contractor and Revision / Change Order Drawings. They do not necessarily show all existing conditions and may not be completely accurate. Field verify existing / hidden conditions prior to commencement of new work.
 DATE: AUGUST 20, 2020

1 MECHANICAL DEMOLITON - FIRST FLOOR
 1/8" = 1'-0"

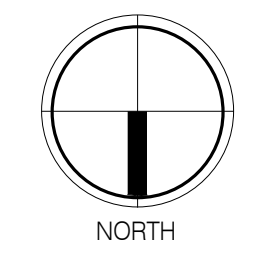

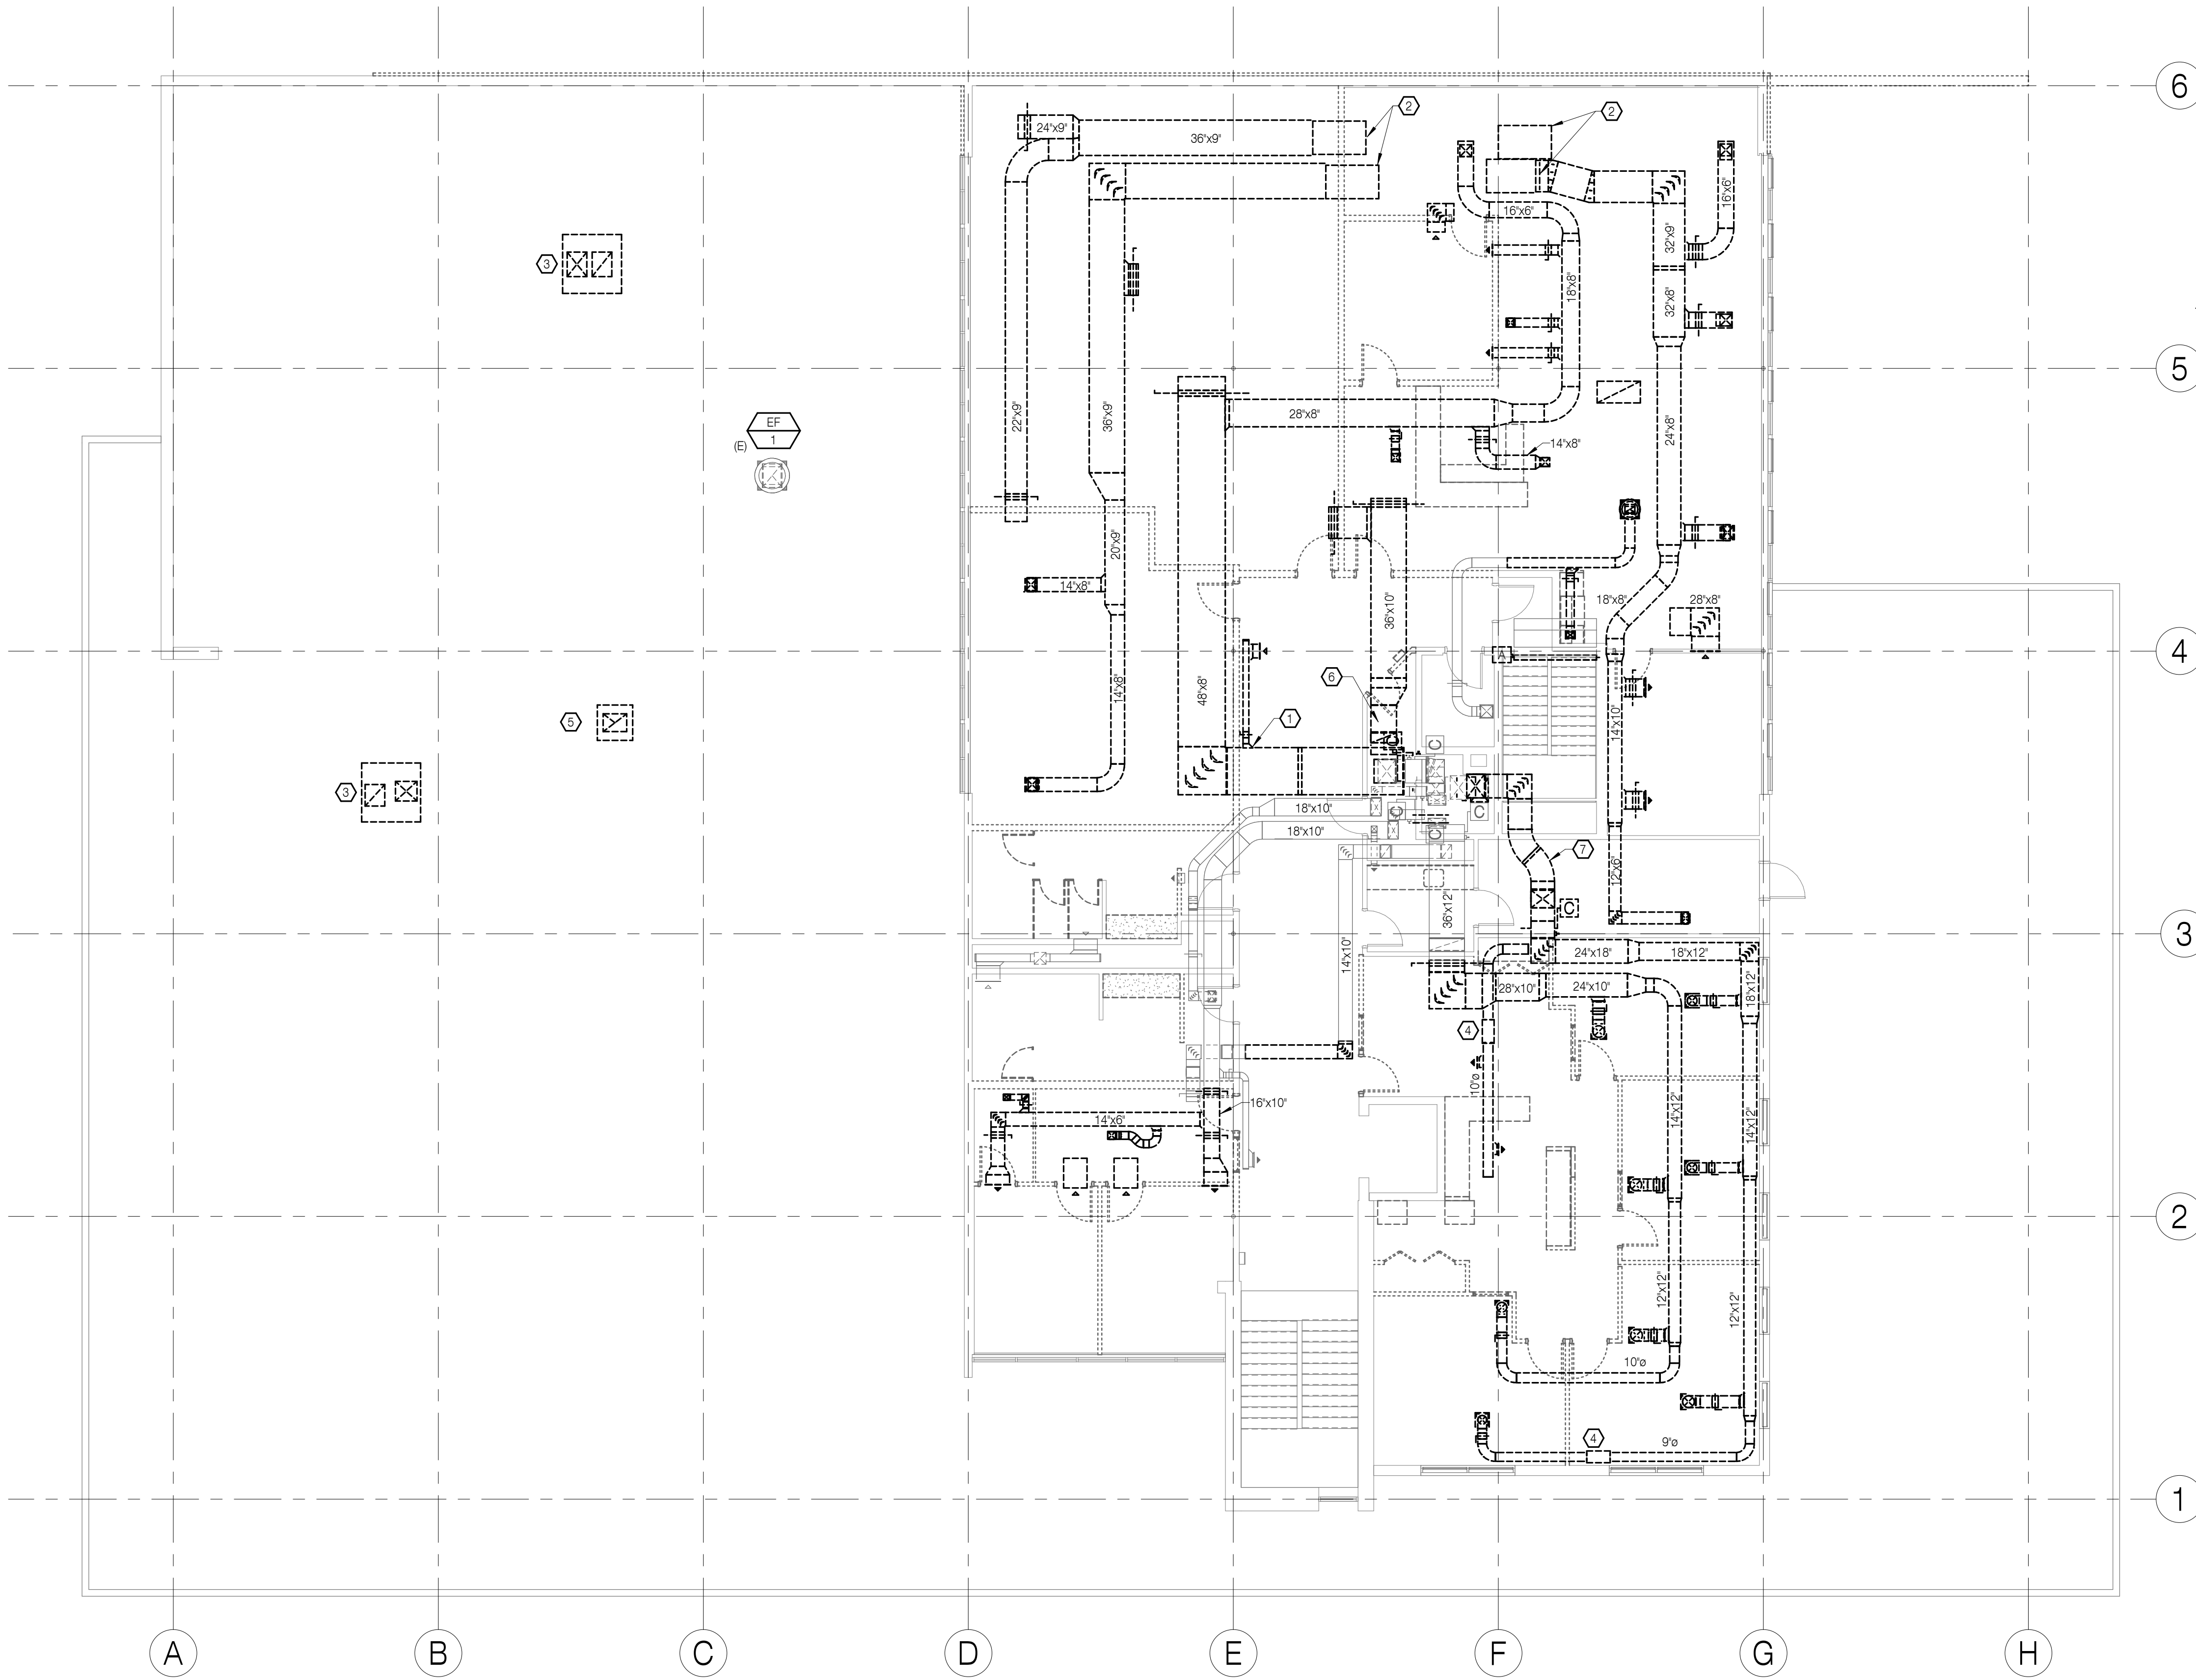

SHEET NOTES:

1. REMOVAL OF EQUIPMENT, PIPING, & VALVES INCLUDES ASSOCIATED HANGERS, SUPPORTS, AND APPURTENANCES.
2. SALVAGE DEMOLISHED DUCTWORK WHERE APPLICABLE FOR RE-USE. SEE NEW AIR DISTRIBUTION PLANS FOR APPLICABLE LOCATIONS.

REFERENCE NOTES:

- 1 CAP/PATCH AND SEAL AIRTIGHT DUCTWORK TO REMAIN.
- 2 REMOVE SOUND TRAPS. REMOVE DUCTWORK UP THROUGH ROOF.
- 3 REMOVE HEAT PUMP UNIT. REMOVE ASSOCIATED CONTROLS, CONTROL WIRING, AND CURB.
- 4 REMOVE ELECTRIC DUCT HEATER.
- 5 REMOVE OSA INLET AND CURB.
- 6 REMOVE EXISTING DUCTWORK BACK THROUGH EXISTING MECHANICAL SHAFT. REMOVE EXISTING COMBO DAMPER. OPENING WILL BE ENLARGED AND RE-USED FOR NEW RETURN DUCTWORK.
- 7 EXISTING SUPPLY DUCTWORK LOCATED IN MECHANICAL PENTHOUSE.


ADD 01

RECORD DRAWING

NOTE: Documents have been corrected as per data supplied by Contractor and Revision / Change Order Drawings. They do not necessarily show all existing conditions and may not be completely accurate. Field verify existing / hidden conditions prior to commencement of new work.
 DATE: AUGUST 20, 2020

REVISIONS:

#	DESCRP.	DATE
1	ADD 01	05.17.19

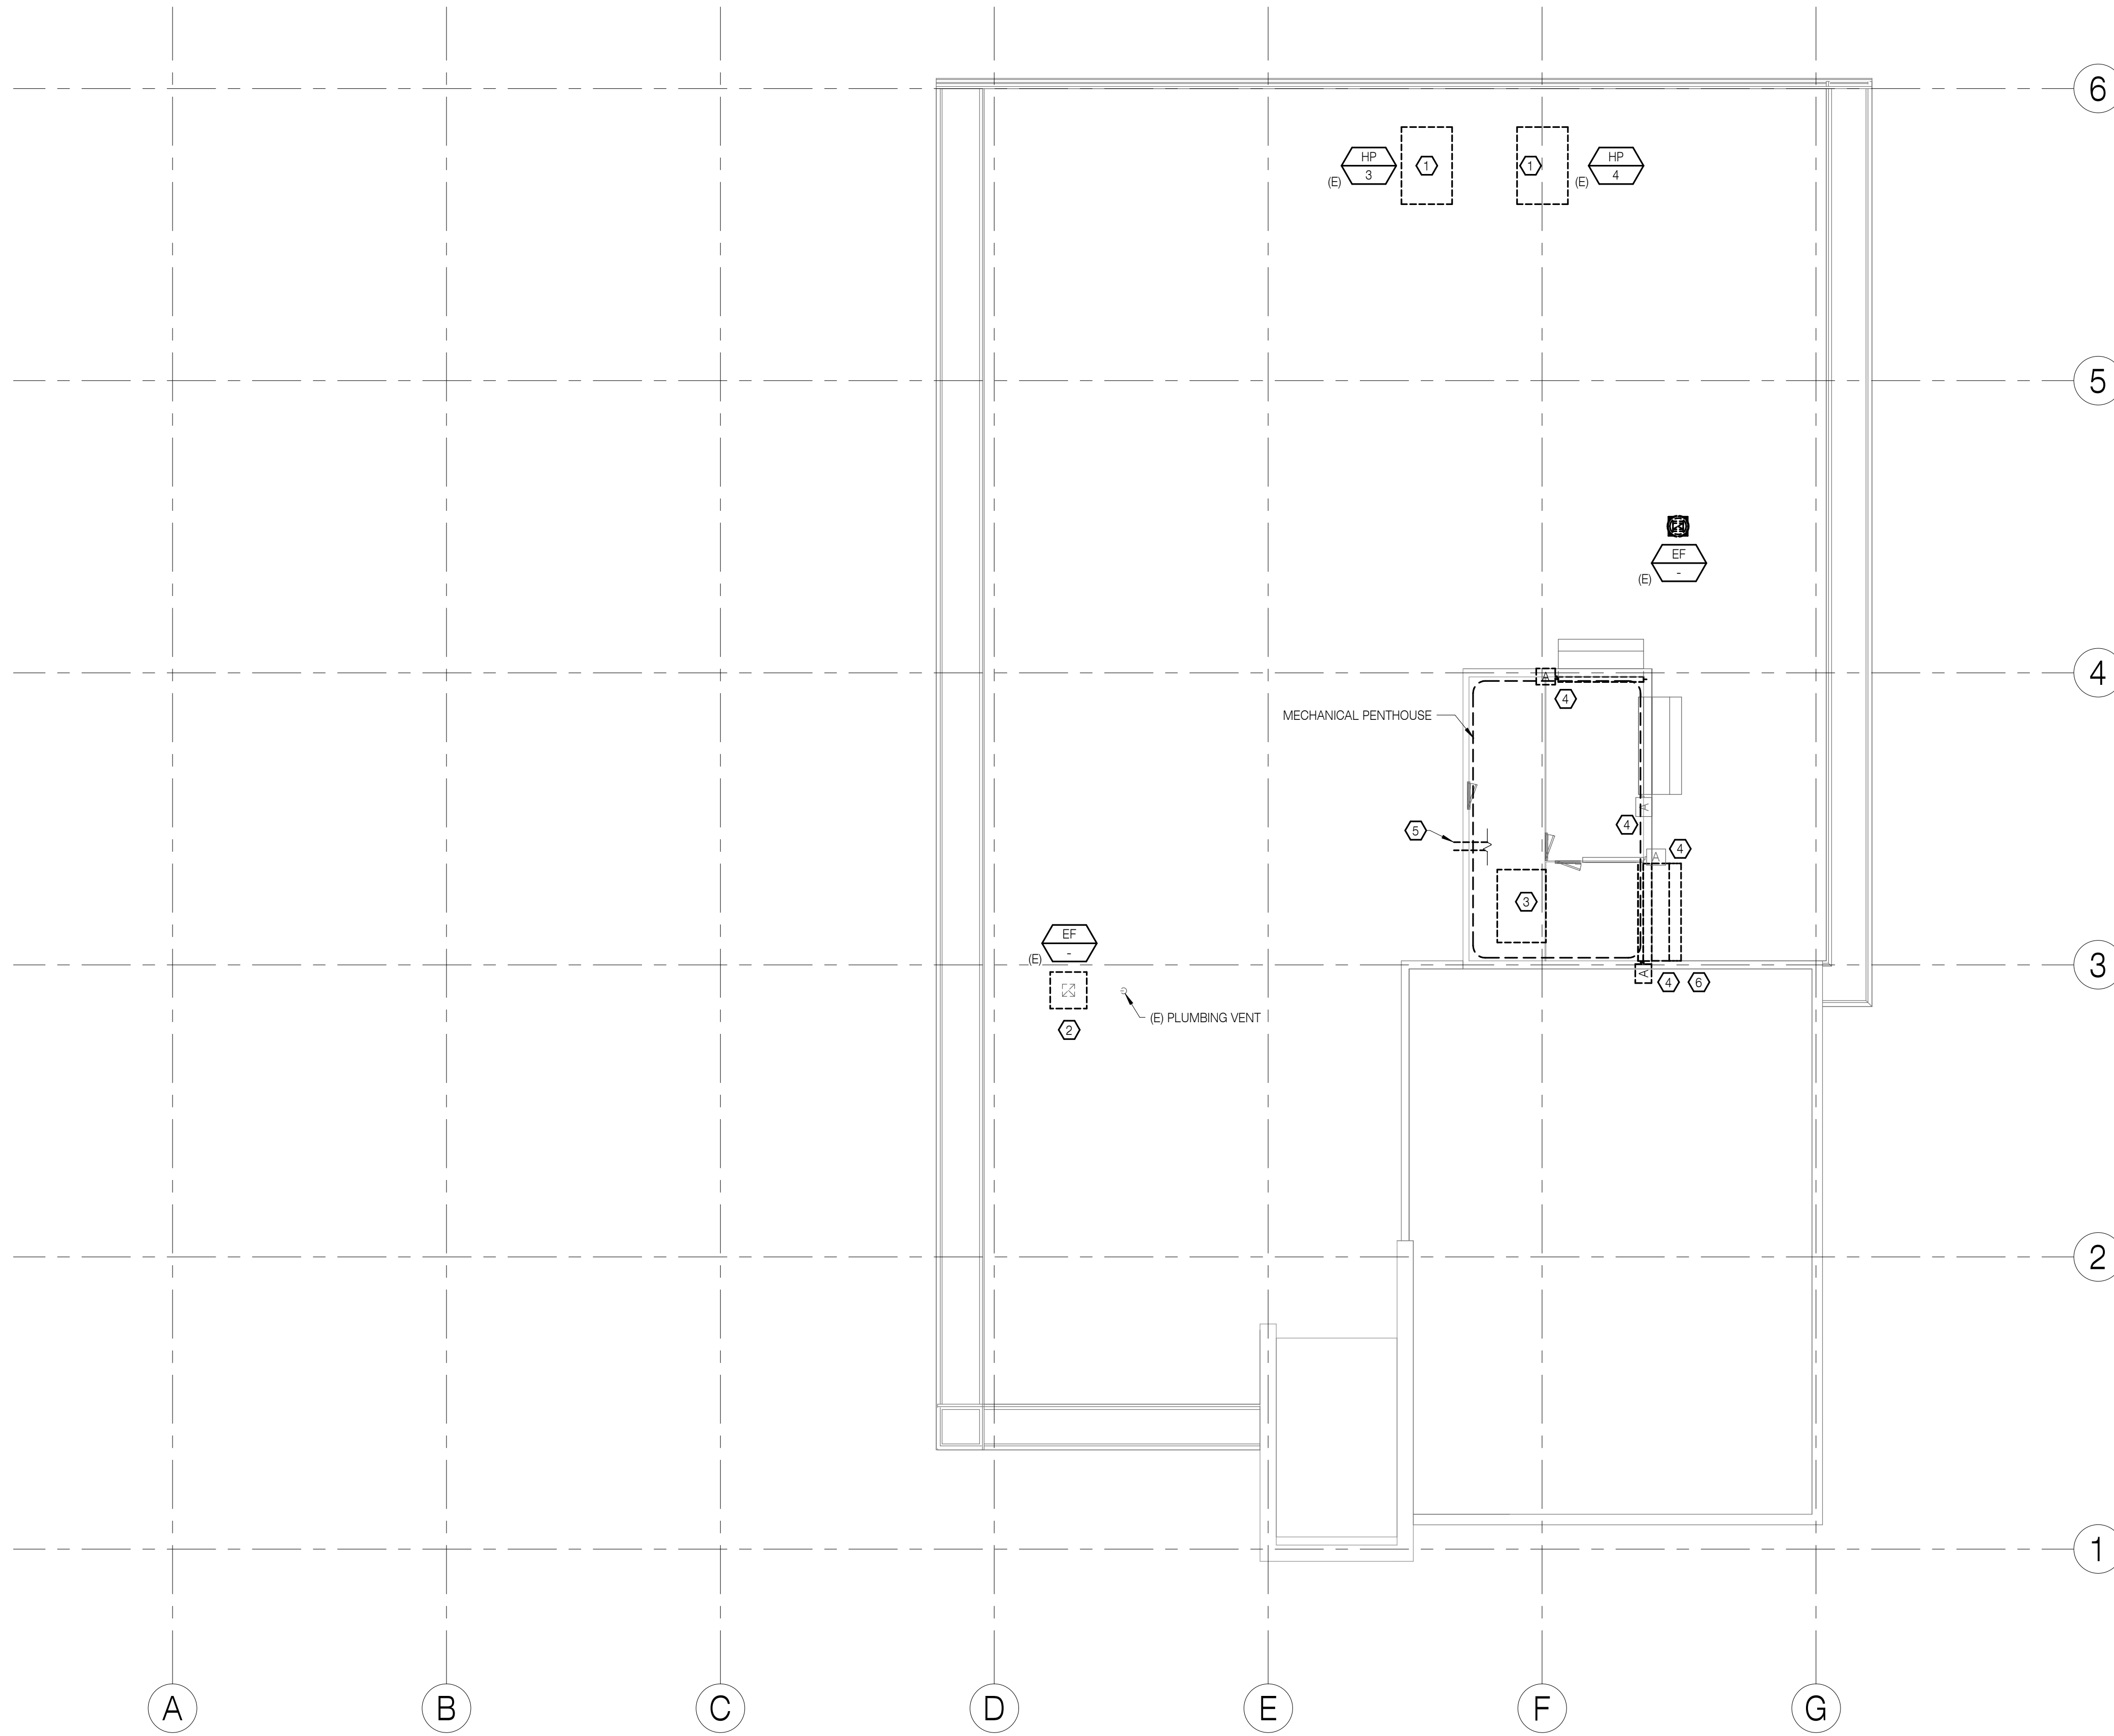


SHEET NOTES:

1. REMOVAL OF EQUIPMENT, PIPING, & VALVES INCLUDES ASSOCIATED HANGERS, SUPPORTS, AND APPURTENANCES.
2. SALVAGE DEMOLISHED DUCTWORK WHERE APPLICABLE FOR RE-USE. SEE NEW AIR DISTRIBUTION PLANS FOR APPLICABLE LOCATIONS.

REFERENCE NOTES:

- ① REMOVE HEAT PUMP. REMOVE ASSOCIATED CONTROLS, CONTROL WIRING AND CURB.
- ② REMOVE EXHAUST FAN. REMOVE ASSOCIATED CONTROLS, CONTROL WIRING, AND CURB. TEMPORARILY CAP EXISTING DUCTWORK FOR RECONNECTION TO NEW FAN. SEE 1/M124 FOR MORE DETAIL.
- ③ REMOVE RETURN FAN FROM TOP OF MECHANICAL SHAFT. REMOVE ASSOCIATED CONTROL AND CONTROL WIRING. REMOVE EXTERIOR RELIEF LOUVER FOR REMOVAL OF FAN. SALVAGE LOUVER FOR RE-INSTALLATION AFTER NEW RETURN FANS INSTALLED.
- ④ REMOVE EXISTING OUTSIDE AIR, RETURN AND RELIEF DAMPER ACTUATORS.
- ⑤ REMOVE ABANDONED CONDENSER WATER PIPING BACK TO WITHIN EXISTING MECHANICAL SHAFT. SEQUENCE REMOVAL TIMING TO FACILITATE INSTALLATION OF AHU-3 TEMPORARY CLINIC HVAC AND NEW WORK. CAP PIPE TO REMAIN IN SHAFT.
- ⑥ TEMPORARILY REMOVE EXISTING RELIEF DAMPER AND WEATHER HOOD FOR REMOVAL OF EXISTING FAN AND INSTALLATION OF NEW RETURN FAN.

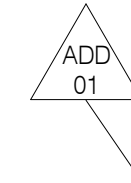


RECORD DRAWING

NOTE: Documents have been corrected as per data supplied by Contractor and Revision / Change Order Drawings. They do not necessarily show all existing conditions and may not be completely accurate. Field verify existing / hidden conditions prior to commencement of new work.
DATE: AUGUST 20, 2020

REVISIONS:

#	DESCRP.	DATE
1	ADD 01	05.17.19

1 MECHANICAL DEMOLITION - ROOF PLAN
1/8" = 1'-0"

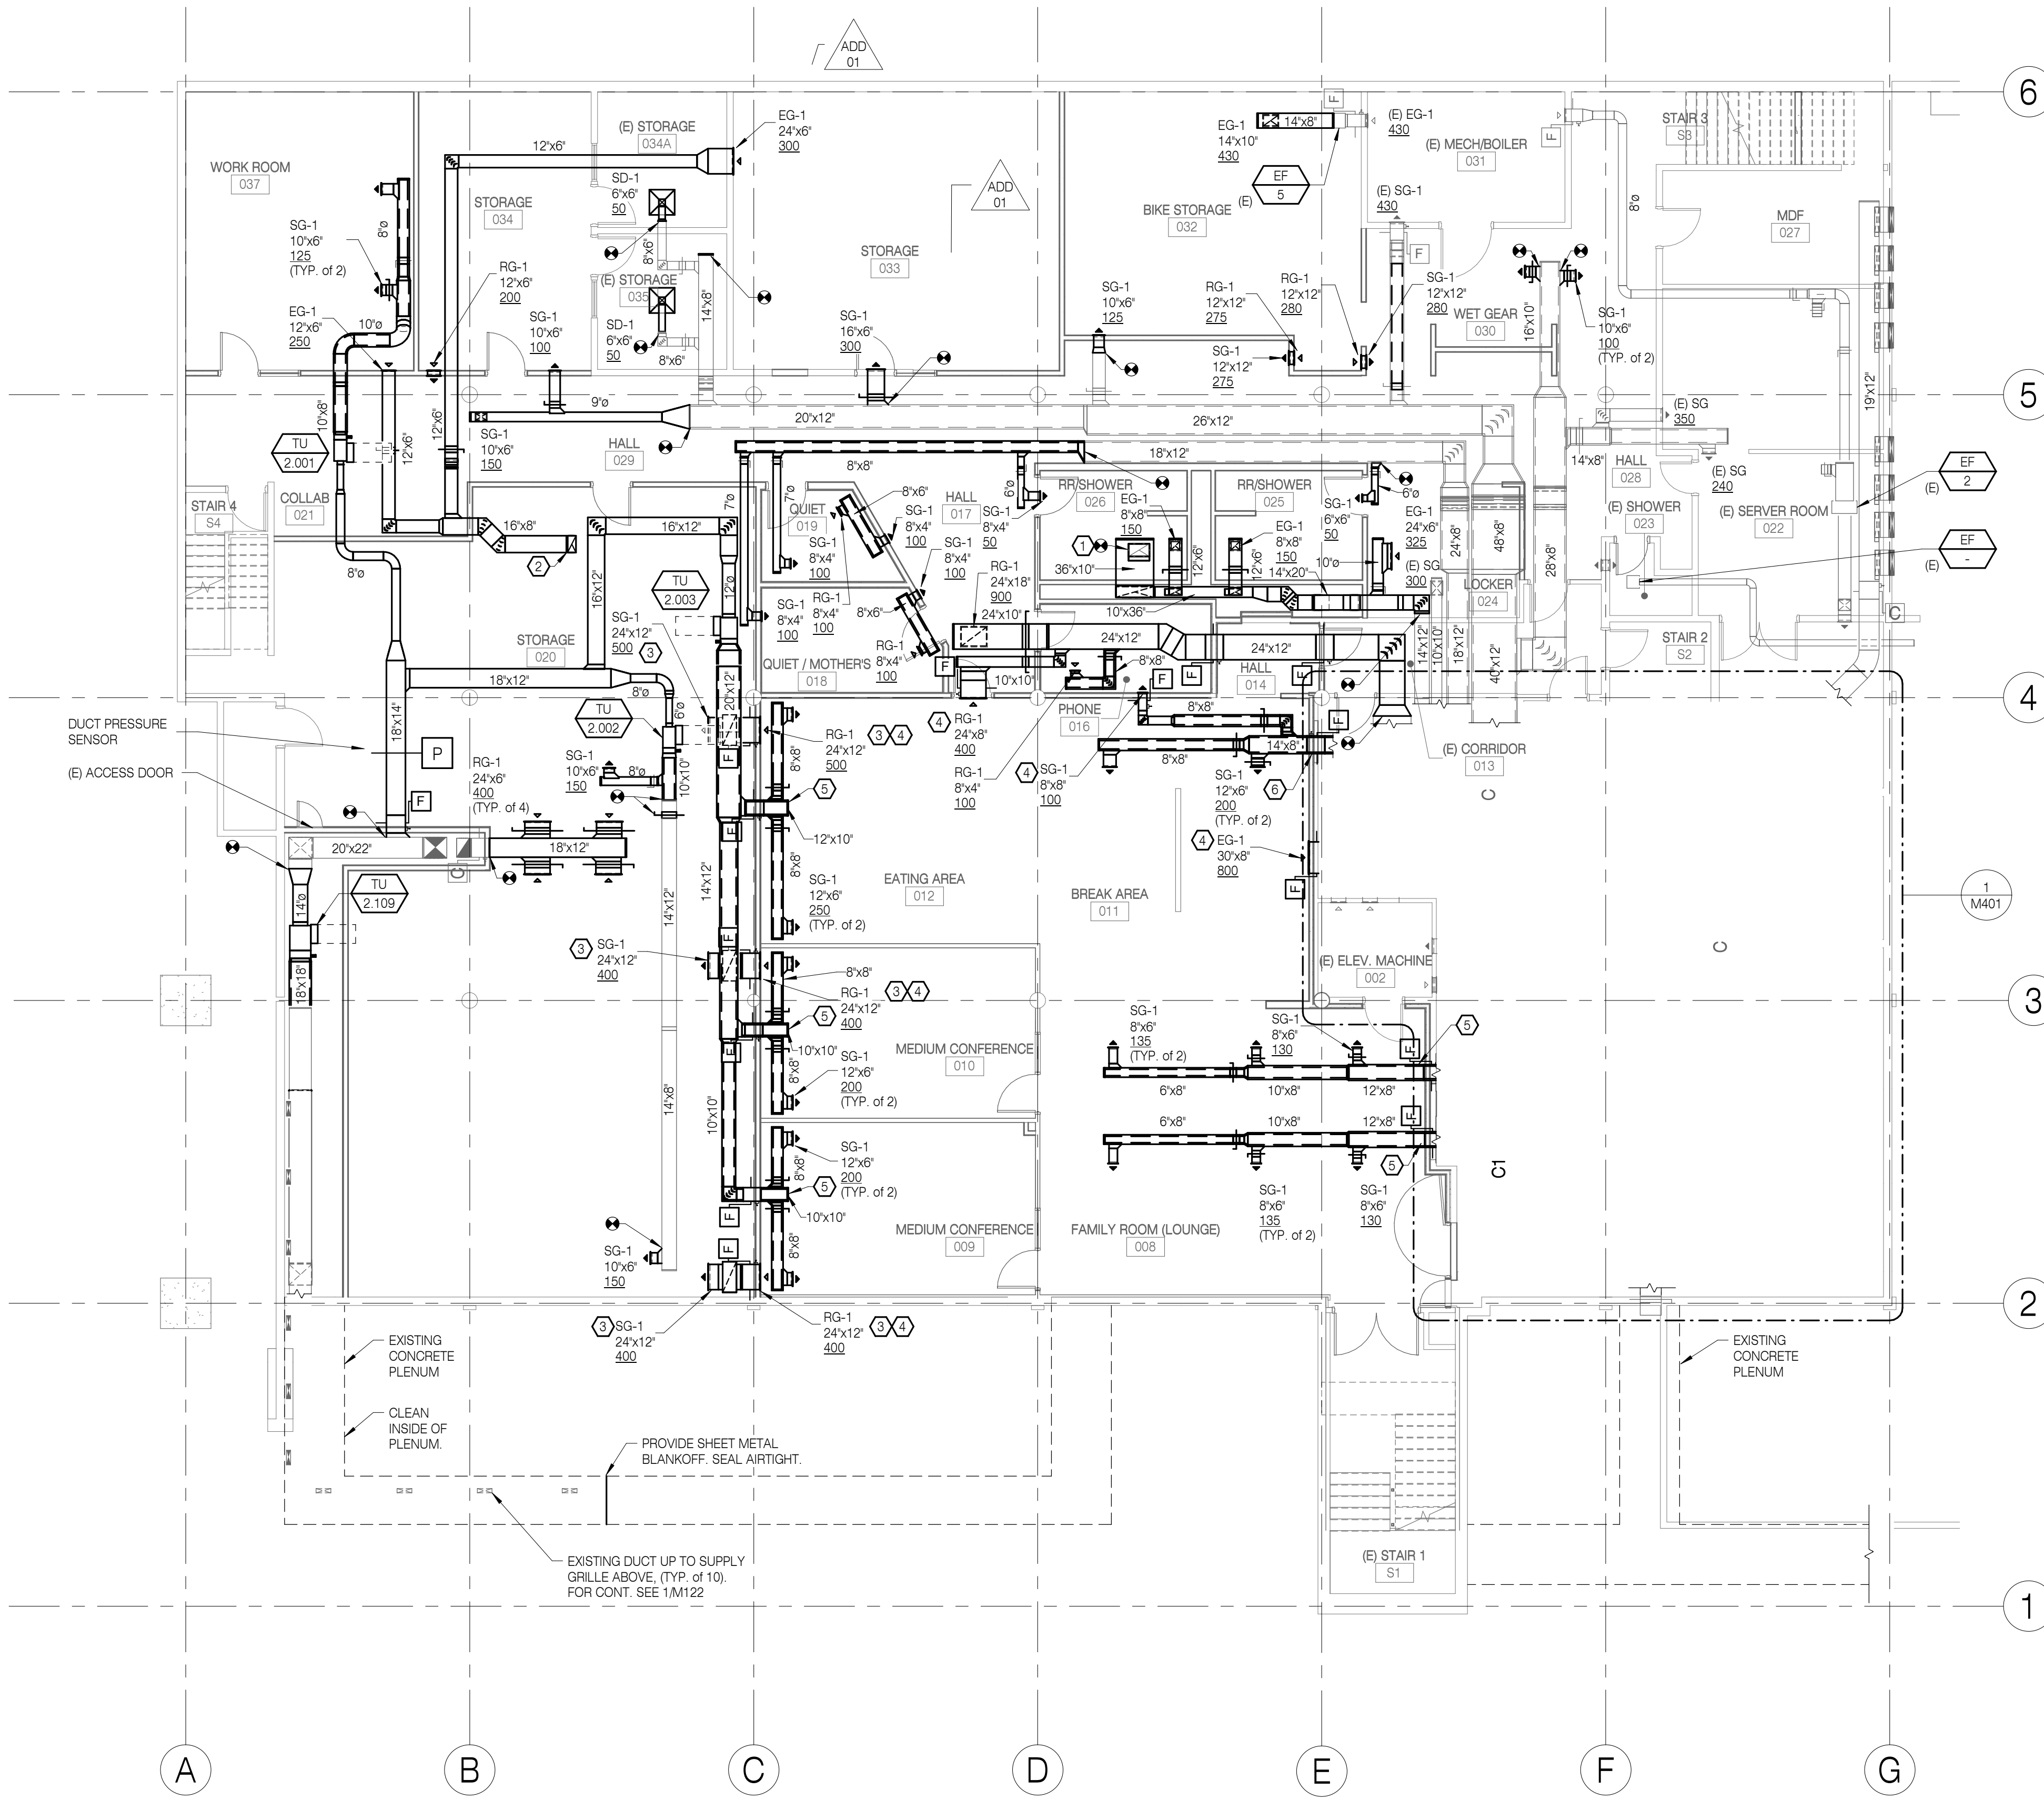

SHEET NOTES:

1. FOR DIFFUSER, GRILLE, AND REGISTER CONNECTION DETAILS SEE 1/M521.
2. FOR ROUND DUCT CONSTRUCTION DETAILS SEE 2/M521.
3. FOR RECTANGULAR DUCT CONSTRUCTION DETAILS SEE 3/M521.
4. FOR TERMINAL UNIT DETAILS SEE 4/M521.
5. FOR SPACE SENSORS AND HVAC ZONING SEE 1/M701.
6. RE-USE EXISTING DUCTWORK WERE APPLICABLE.

REFERENCE NOTES:

- 1 20"x12" EA UP TO FLOOR ABOVE. FOR CONT. SEE 1/M122.
- 2 16"x8" EA UP TO FLOOR ABOVE. FOR CONT. SEE 1/M122.
- 3 PROVIDE TRANSFER DUCT ASSEMBLY CONTAINING THE FOLLOWING: LOW WALL RETURN GRILLE WITH BOTTOM APPROXIMATELY 12" A.F.F., FIRE DAMPER, 26"x10" LINED VERTICAL DUCT, AND SUPPLY GRILLE LOCATED AS HIGH AS POSSIBLE IN STORAGE ROOM. LOCATE VERTICAL DUCT TIGHT TO WEST WALL.
- 4 FIRE DAMPER ACCESS THROUGH GRILLE.
- 5 PROVIDE FIRE DAMPER ACCESS ON BOTTOM SIDE OF DUCT BRANCH.
- 6 FIRE DAMPER ACCESS LOCATED IN MECHANICAL ROOM. FOR CONT. SEE 1/M401.

RECORD DRAWING

NOTE: Documents have been corrected as per data supplied by Contractor and Revision / Change Order Drawings. They do not necessarily show all existing conditions and may not be completely accurate. Field verify existing / hidden conditions prior to commencement of new work.
DATE: AUGUST 20, 2020



SYSTEMS WEST ENGINEERS
725 A Street
Springfield, OR 97477
541.342.7210
systemswestengineers.com
SWE Proj. No. U003.08


RECORD DRAWINGS
HOMES FOR GOOD OFFICE BUILDING
REMODEL
100 WEST 10TH AVENUE
EUGENE, OR 97401

SHEET TITLE:
AIR DISTRIBUTION - LOWER LEVEL


REVISIONS:

#	DESCRP.	DATE
1	ADD 01	05.17.19

ISSUE DATE: 08/20/2020

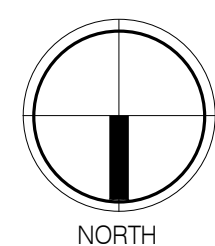

1 AIR DISTRIBUTION - LOWER LEVEL
1/8" = 1'-0"

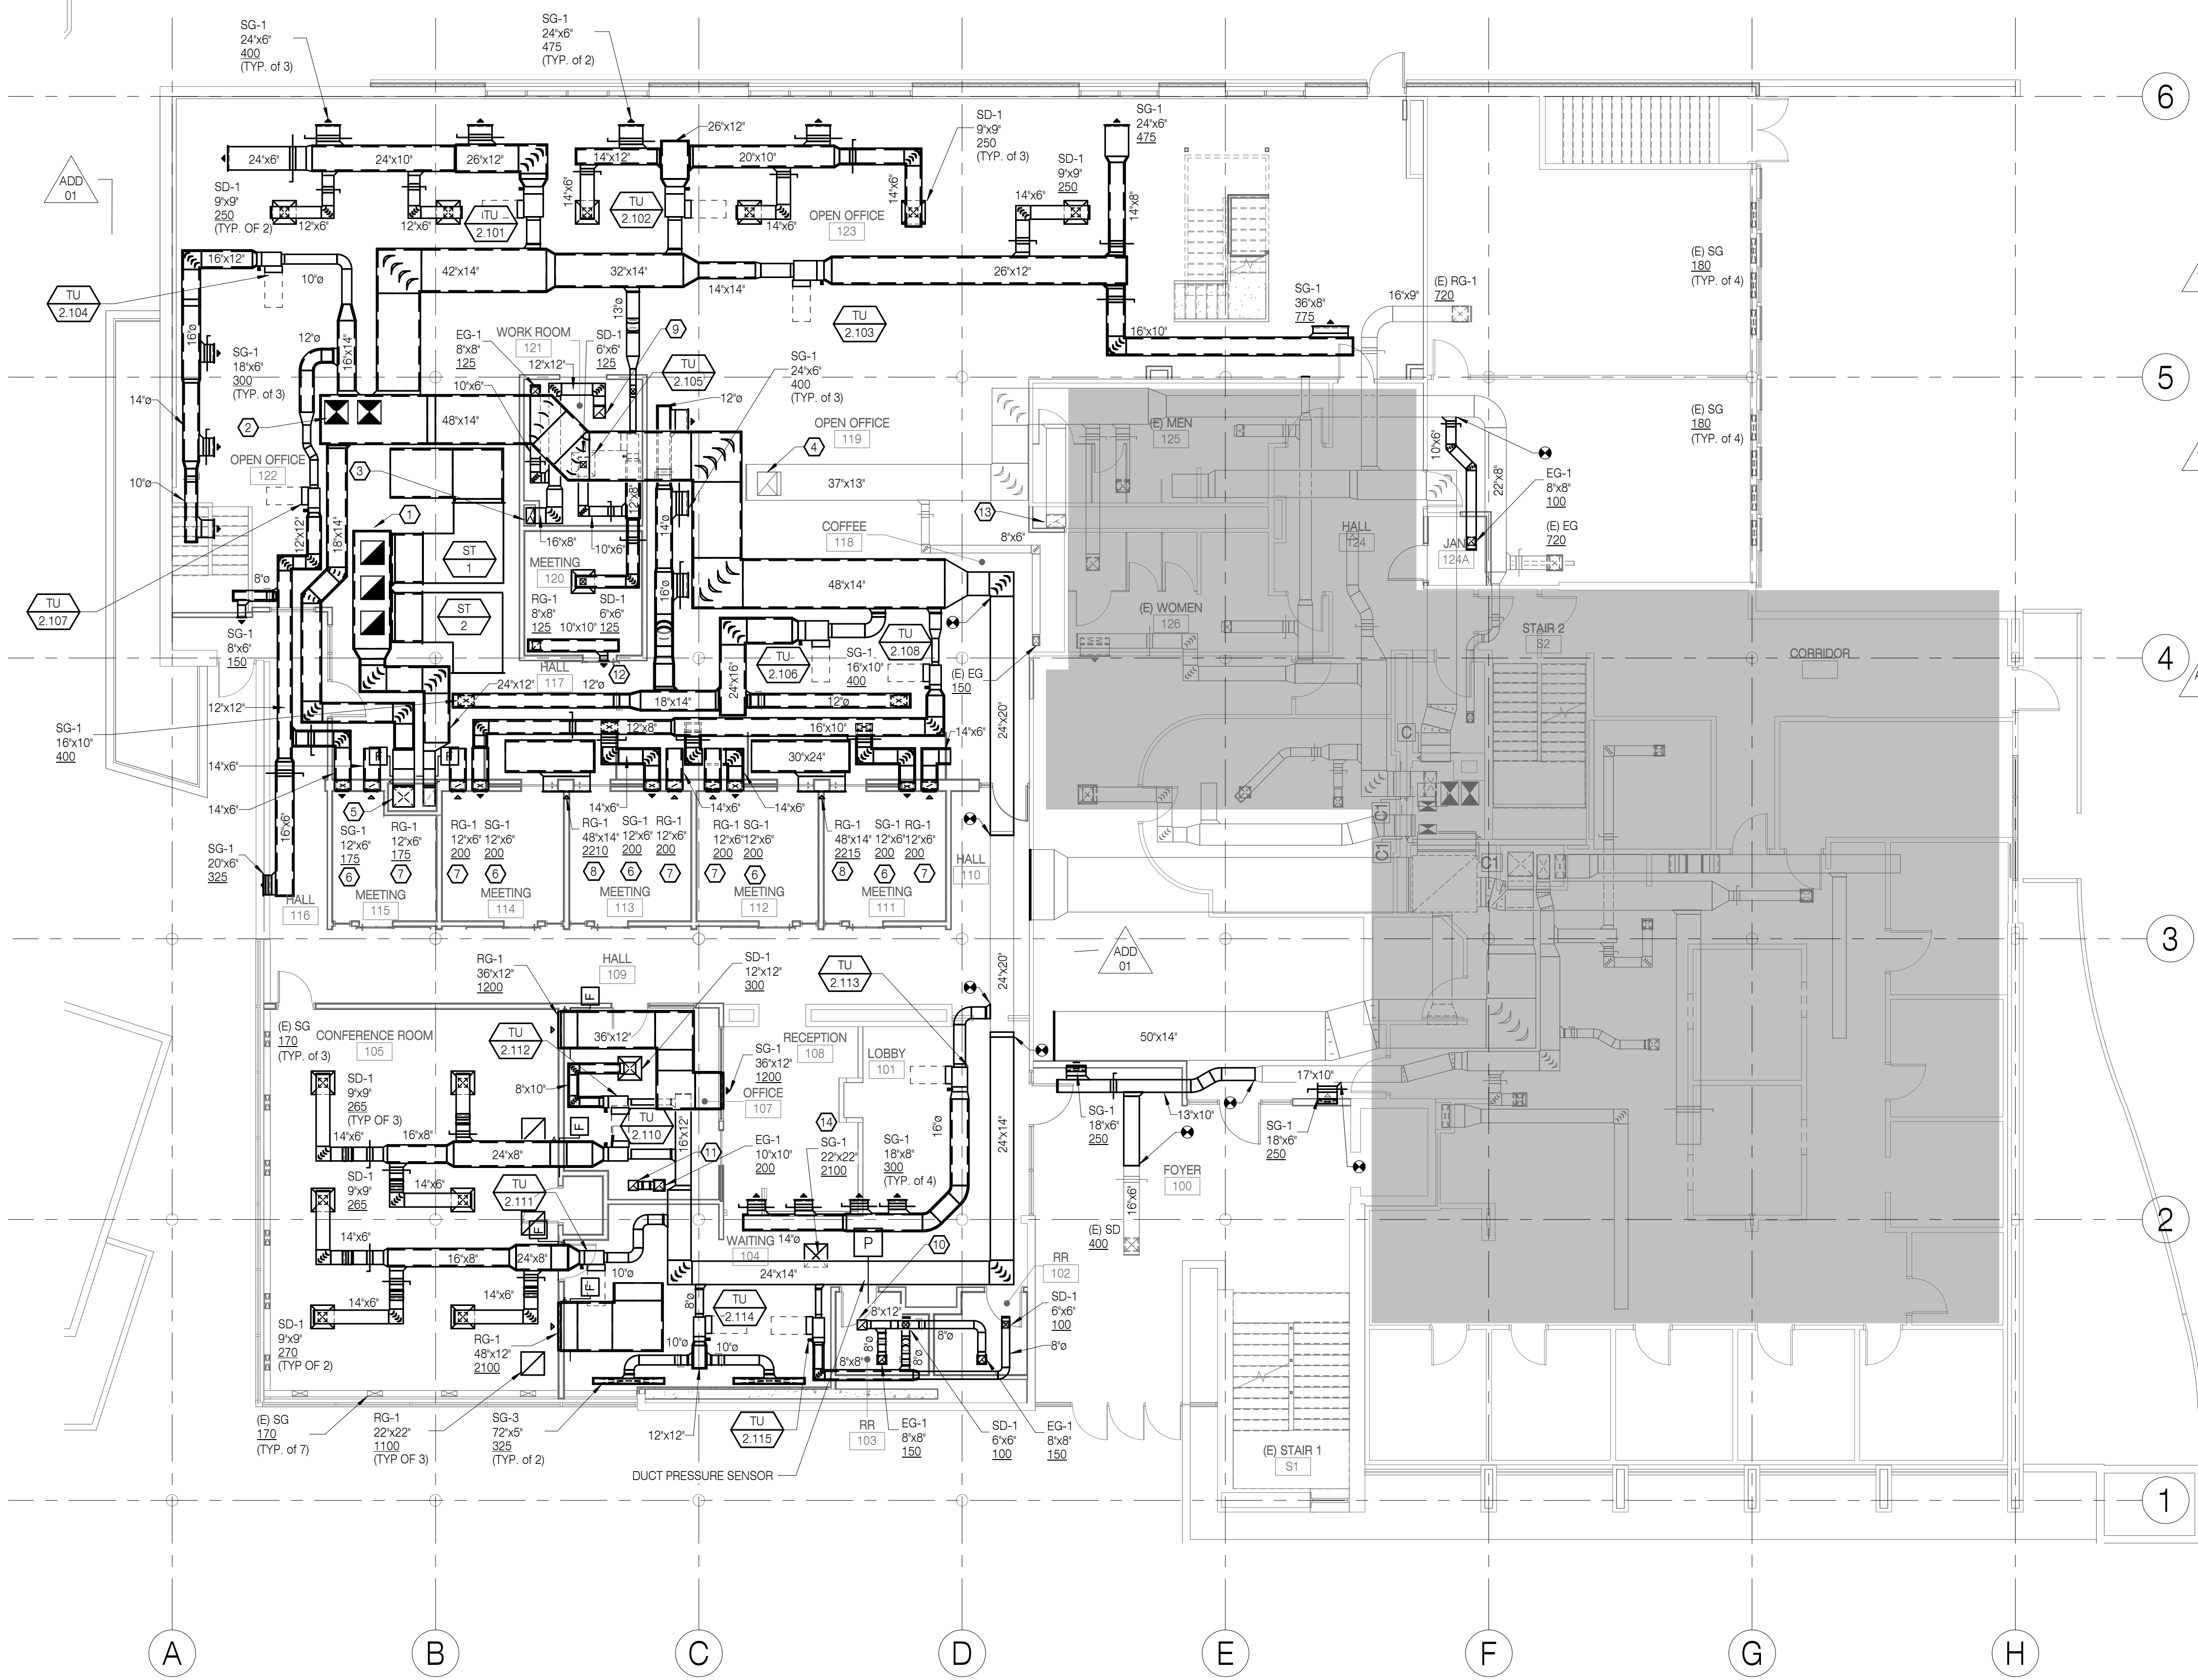

1 AIR DISTRIBUTION - FIRST FLOOR
1/8" = 1'-0"

- SHEET NOTES:**
- FOR DIFFUSER, GRILLE, AND REGISTER CONNECTION DETAILS SEE 1/M521.
 - FOR ROUND DUCT CONSTRUCTION DETAILS SEE 2/M521.
 - FOR RECTANGULAR DUCT CONSTRUCTION DETAILS SEE 3/M521.
 - FOR TERMINAL UNIT DETAILS SEE 4/M521.
 - FOR SPACE SENSORS AND HVAC ZONING SEE 1/M702.
 - RE-USE EXISTING DUCTWORK WERE APPLICABLE.
- REFERENCE NOTES:**
- PROVIDE 36"x24"x120" LINED RETURN AIR PLENUM. PROVIDE THREE 24"x24" RETURN AIR DUCTS UP THROUGH ROOF TO AHU-2 ABOVE.
 - PROVIDE 48"x24"x108" LINED SUPPLY AIR PLENUM. PROVIDE TWO 24"x24" SUPPLY AIR DUCTS UP THROUGH ROOF TO AHU-2 ABOVE.
 - 16"x8" EA DN. TO FLOOR BELOW. FOR CONT. SEE 1/M121.
 - 24"x20" UP TO (E) EG-1 ON ROOF ABOVE.
 - (E) 22"x20" SA & (E) 12"x18" RA DN. TO FLOOR BELOW. FOR CONT. SEE 1/M121. PROVIDE NEW CONNECTIONS TO EXISTING DUCTWORK AT TOP OF CHASE.
 - BOTTOM OF SUPPLY GRILLE APPROXIMATELY 7'-8" A.F.F. COORDINATE FINAL ELEVATION WITH ARCHITECT.
 - BOTTOM OF RETURN GRILLE APPROXIMATELY 0'-6" A.F.F. COORDINATE ELEVATION WITH ARCHITECT.
 - BOTTOM OF RETURN GRILLE APPROXIMATELY 9'-6" A.F.F. COORDINATE FINAL ELEVATION WITH ARCHITECT.
 - 12"x12" EA UP TO EG-10 ON ROOF ABOVE. FOR CONT. SEE 1/M123.
 - 12"x12" EA UP TO EG-6 ON ROOF ABOVE. FOR CONT. SEE 1/M123.
 - 10"x10" EA UP TO EG-7 ON ROOF ABOVE. FOR CONT. SEE 1/M123.
 - 8"x8" SG-1, 125 CFM.
 - PROVIDE NEW DUCT ACCESS DOOR FOR EXISTING FIRE DAMPER LOCATED IN FIRST FLOOR SLAB. SEE ARCHITECTURAL FOR NEW ACCESS DOOR LOCATION IN EAST WALL OF PLUMBING CHASE.
 - PROVIDE SUPPLY GRILLE IN CEILING TO ALLOW RETURN AIR FROM LARGE CONFERENCE ROOM TO TRANSFER THROUGH CEILING IN WAITING AREA.

RECORD DRAWING
NOTE: Documents have been corrected as per data supplied by Contractor and Revision / Change Order Drawings. They do not necessarily show all existing conditions and may not be completely accurate. Field verify existing / hidden conditions prior to commencement of new work.
DATE: AUGUST 20, 2020

SHEET TITLE:
AIR DISTRIBUTION - FIRST FLOOR

REVISIONS:

#	DESCRP.	DATE
1	ADD 01	05.17.19



SHEET NOTES:

- FOR DIFFUSER, GRILLE, AND REGISTER CONNECTION DETAILS SEE 1/M521.
- FOR ROUND DUCT CONSTRUCTION DETAILS SEE 2/M521.
- FOR RECTANGULAR DUCT CONSTRUCTION DETAILS SEE 3/M521.
- FOR TERMINAL UNIT DETAILS SEE 4/M521.
- FOR SPACE SENSORS AND HVAC ZONING SEE 1/M703.
- RE-USE EXISTING DUCTWORK WERE APPLICABLE.

REFERENCE NOTES:

- MAIN RETURN FOR ZONES 1.201 THROUGH 1.204.
- MAIN RETURN FOR ZONE 1.207.
- MAIN RETURN FOR ZONE 1.208.
- PROVIDE RATED ENCLOSURE AROUND DUCTWORK ABOVE STAIR S2-1.
- SUPPLY DUCTWORK CONT. THROUGH MECHANICAL PENTHOUSE. FOR CONT. SEE 1/M124.
- PROVIDE TRANSFER DUCT ASSEMBLY CONTAINING THE FOLLOWING: LOW WALL RETURN GRILLE WITH BOTTOM OF GRILLE APPROXIMATELY 6" A.F.F., 20"x14" LINED VERTICAL DUCT, AND SUPPLY GRILLE ON HALLWAY SIDE LOCATED NEAR ROOF STRUCTURE.
- PROVIDE RETURN GRILLE IN BOTTOM OF SOFFIT TO ALLOW RETURN AIR TO TRANSFER THROUGH TRANSFER ASSEMBLY ABOVE COFFEE NOOK.
- 20"x8" LINED DUCT OPEN ABOVE CEILING. PROVIDE RETURN GRILLE IN CEILING FOR RETURN AIR PATHWAY.
- 10"x10" EA UP TO EE-3 ON ROOF ABOVE. FOR CONT. SEE 1/M124.
- TWO (E) 24"x18" SA DUCTS UP FROM BASEMENT. AT THE BOTTOM OF THE SECOND FLOOR PROVIDE NEW 40"x24" SA DUCT AND PROVIDE NEW TO EXISTING CONNECTION TO THE TWO EXISTING 24"x18" SA DUCTS. NEW 40"x24" SA DUCT CONTINUES UP THROUGH 12"x36" SA TAKEOFF ABOVE STAIRWAY. AFTER TAKEOFF PROVIDE 20"x14" SA UP TO MECHANICAL PENTHOUSE ABOVE. FOR CONT. SEE 1/M124.
- (E) 18"x10" SA ON TOP. PROVIDE NEW 24"x30" LINED RA ON BOTTOM. PROVIDE COMBO DAMPER AT MECHANICAL SHAFT WALL.
- PROVIDE 36"x26"x106" LINED RA PLENUM. AT BOTTOM PROVIDE OPPOSED BLADE DAMPER ON 24"x30" RA DUCT BETWEEN PLENUM CONNECTION COMBO DAMPER. AT THE TOP PROVIDE BALANCING DAMPER ON EACH RETURN GRILLE CONNECTION.


RECORD DRAWING
 NOTE: Documents have been corrected as per data supplied by Contractor and Revision / Change Order Drawings. They do not necessarily show all existing conditions and may not be completely accurate. Field verify existing / hidden conditions prior to commencement of new work.
 DATE: AUGUST 20, 2020

SHEET TITLE:
AIR DISTRIBUTION - SECOND FLOOR


REVISIONS:

#	DESCRP.	DATE
1	ADD 01	05.17.19
6	RFT 14	08.14.19

ISSUE DATE: 08/20/2020

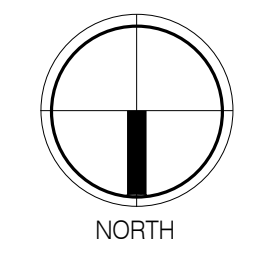

1 AIR DISTRIBUTION - SECOND FLOOR
 1/8" = 1'-0"

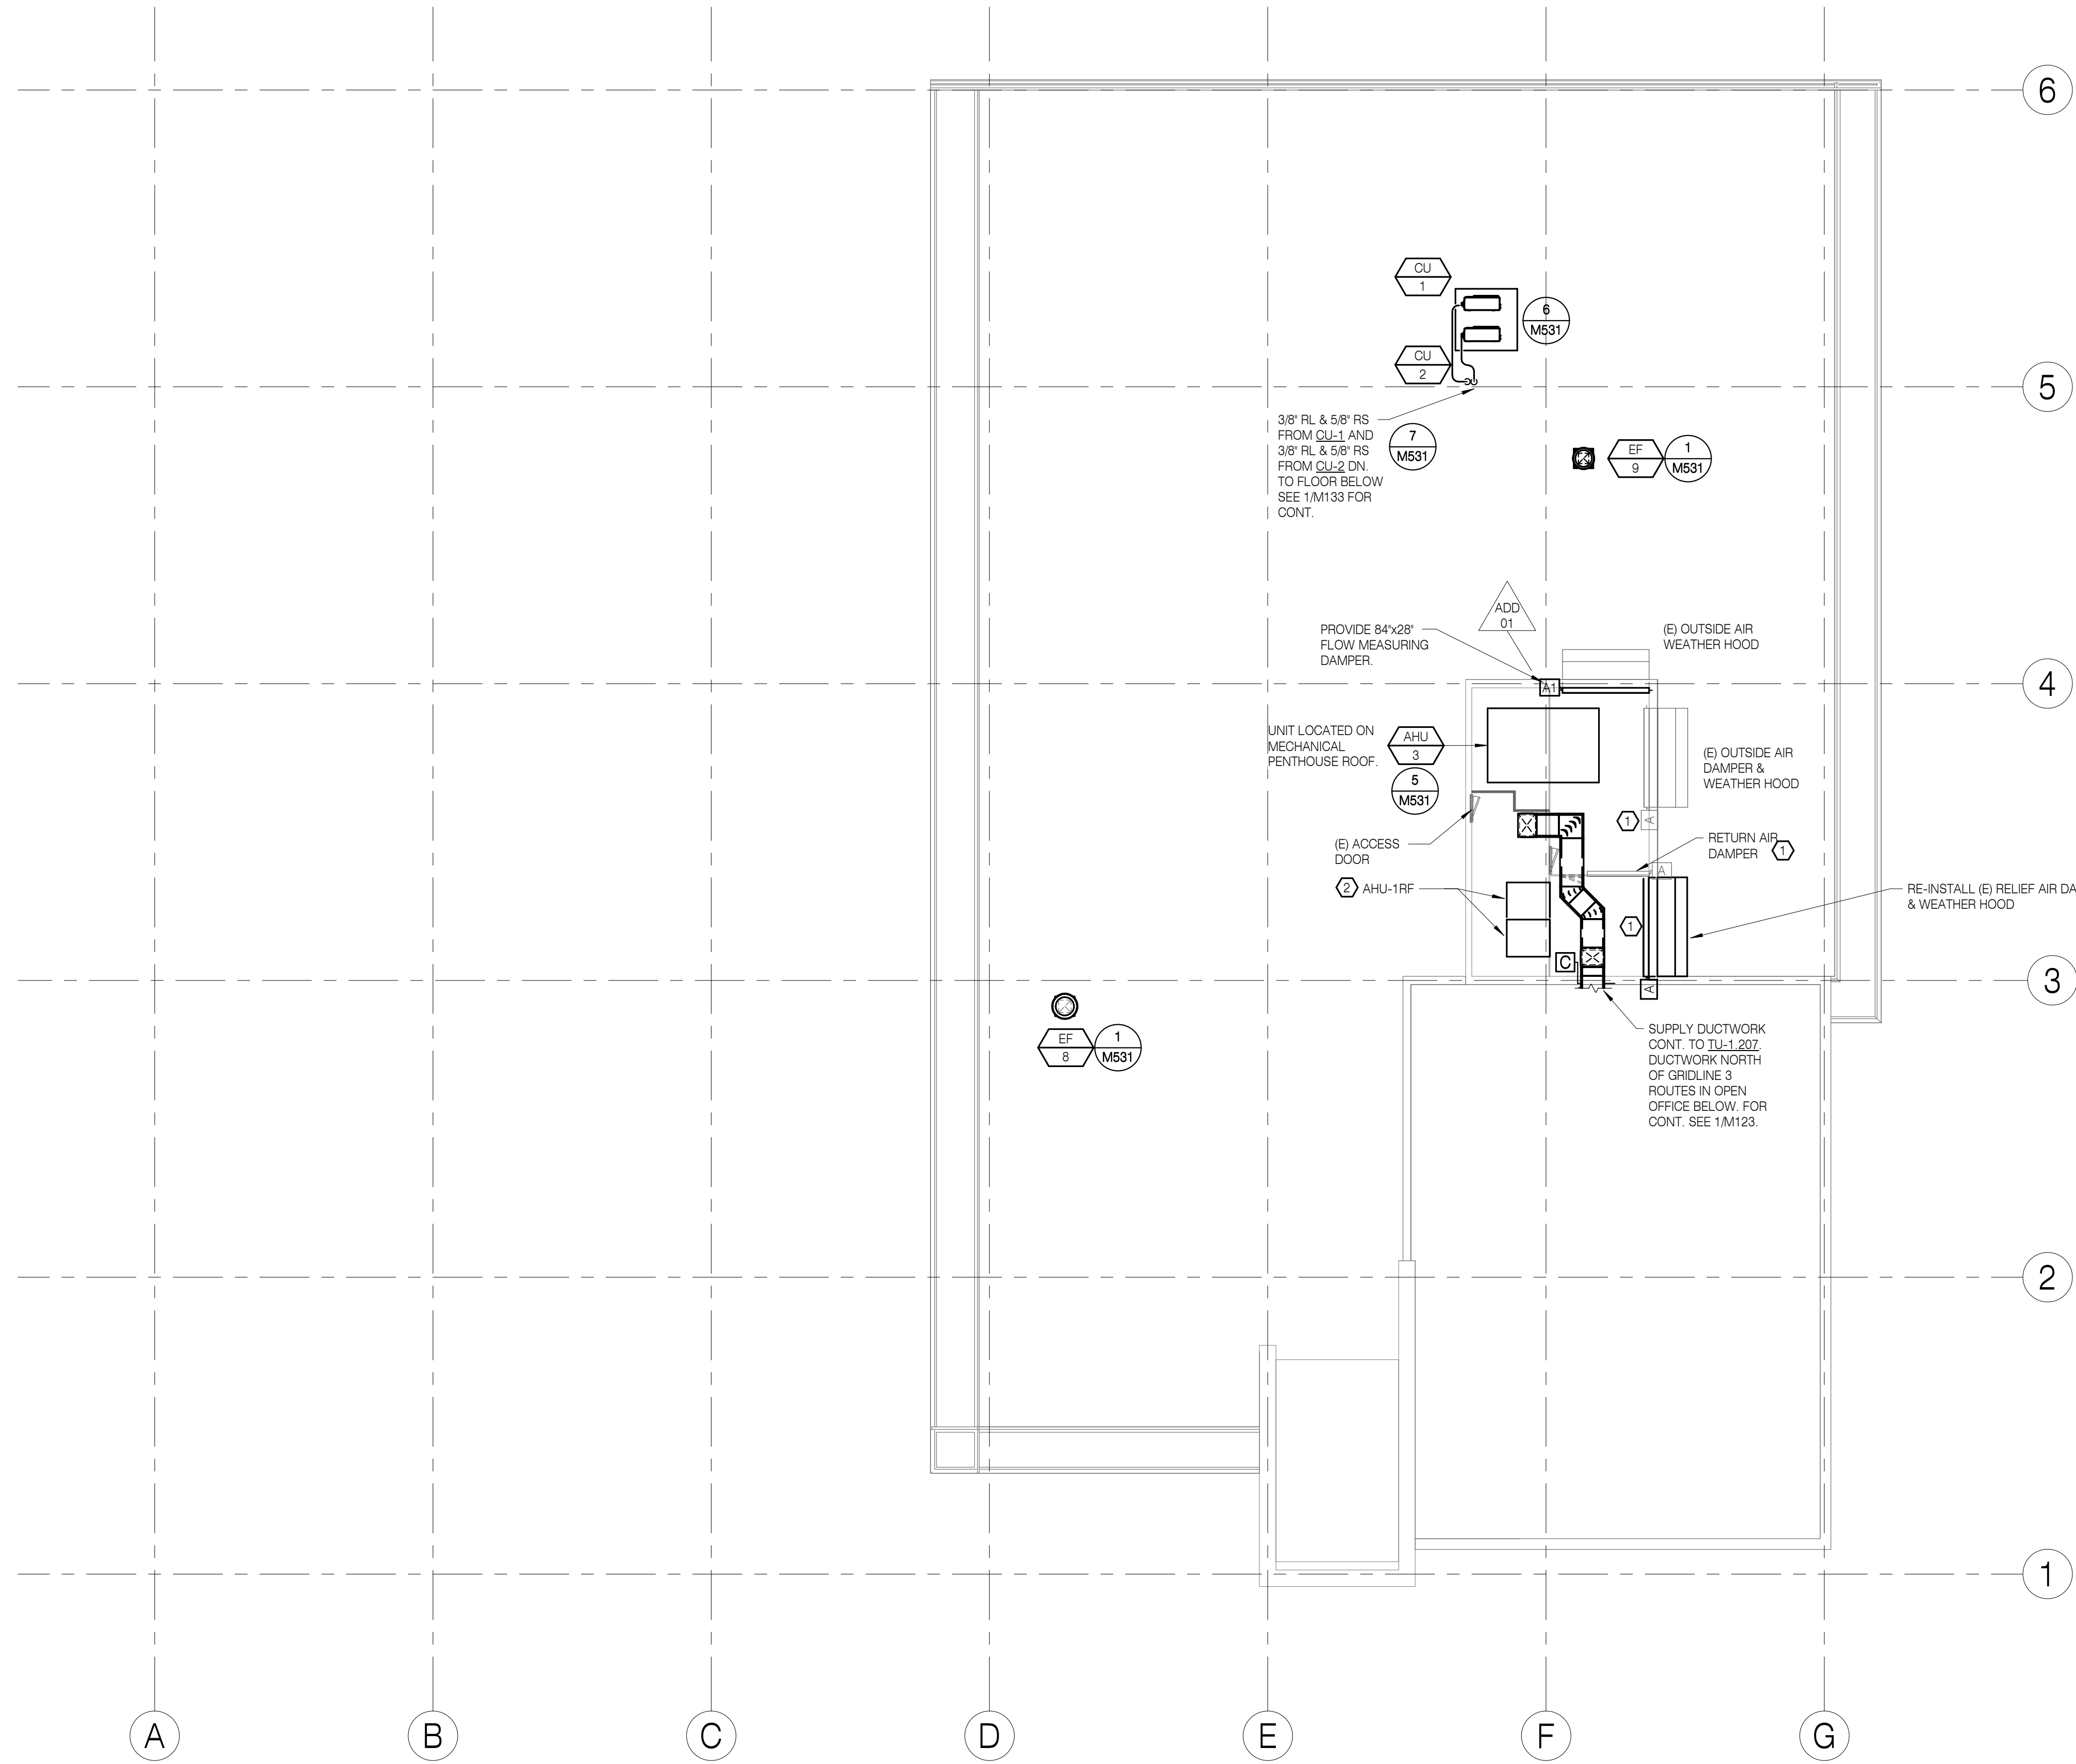

SHEET NOTES:

- 1. FOR RECTANGULAR DUCT CONSTRUCTION DETAILS SEE 3/M521.

REFERENCE NOTES:

- ① PROVIDE REPLACEMENT ACTUATORS ON EXISTING DAMPERS.
- ② CONSTRUCT PLENUM WALLS AND SUPPORT STRUCTURE FOR REPLACEMENT RETURN FAN ARRAY.



1 AIR DISTRIBUTION - ROOF PLAN
1/8" = 1'-0"

RECORD DRAWING
NOTE: Documents have been corrected as per data supplied by Contractor and Revision / Change Order Drawings. They do not necessarily show all existing conditions and may not be completely accurate. Field verify existing / hidden conditions prior to commencement of new work.
DATE: AUGUST 20, 2020

RECORD DRAWING
20 AUGUST 2020

SW E
SYSTEMS WEST ENGINEERS
725 A Street
Springfield, OR 97477
541.342.7210
systemswestengineers.com
SWE Proj. No. U003.08

RECORD DRAWINGS
HOMES FOR GOOD OFFICE BUILDING
REMODEL
100 WEST 30TH AVENUE
EUGENE, OR 97401


SHEET TITLE:
AIR DISTRIBUTION - ROOF PLAN

REVISIONS:

#	DESCRP.	DATE
1	ADD 01	05.17.19

ISSUE DATE: 08/20/2020

M124

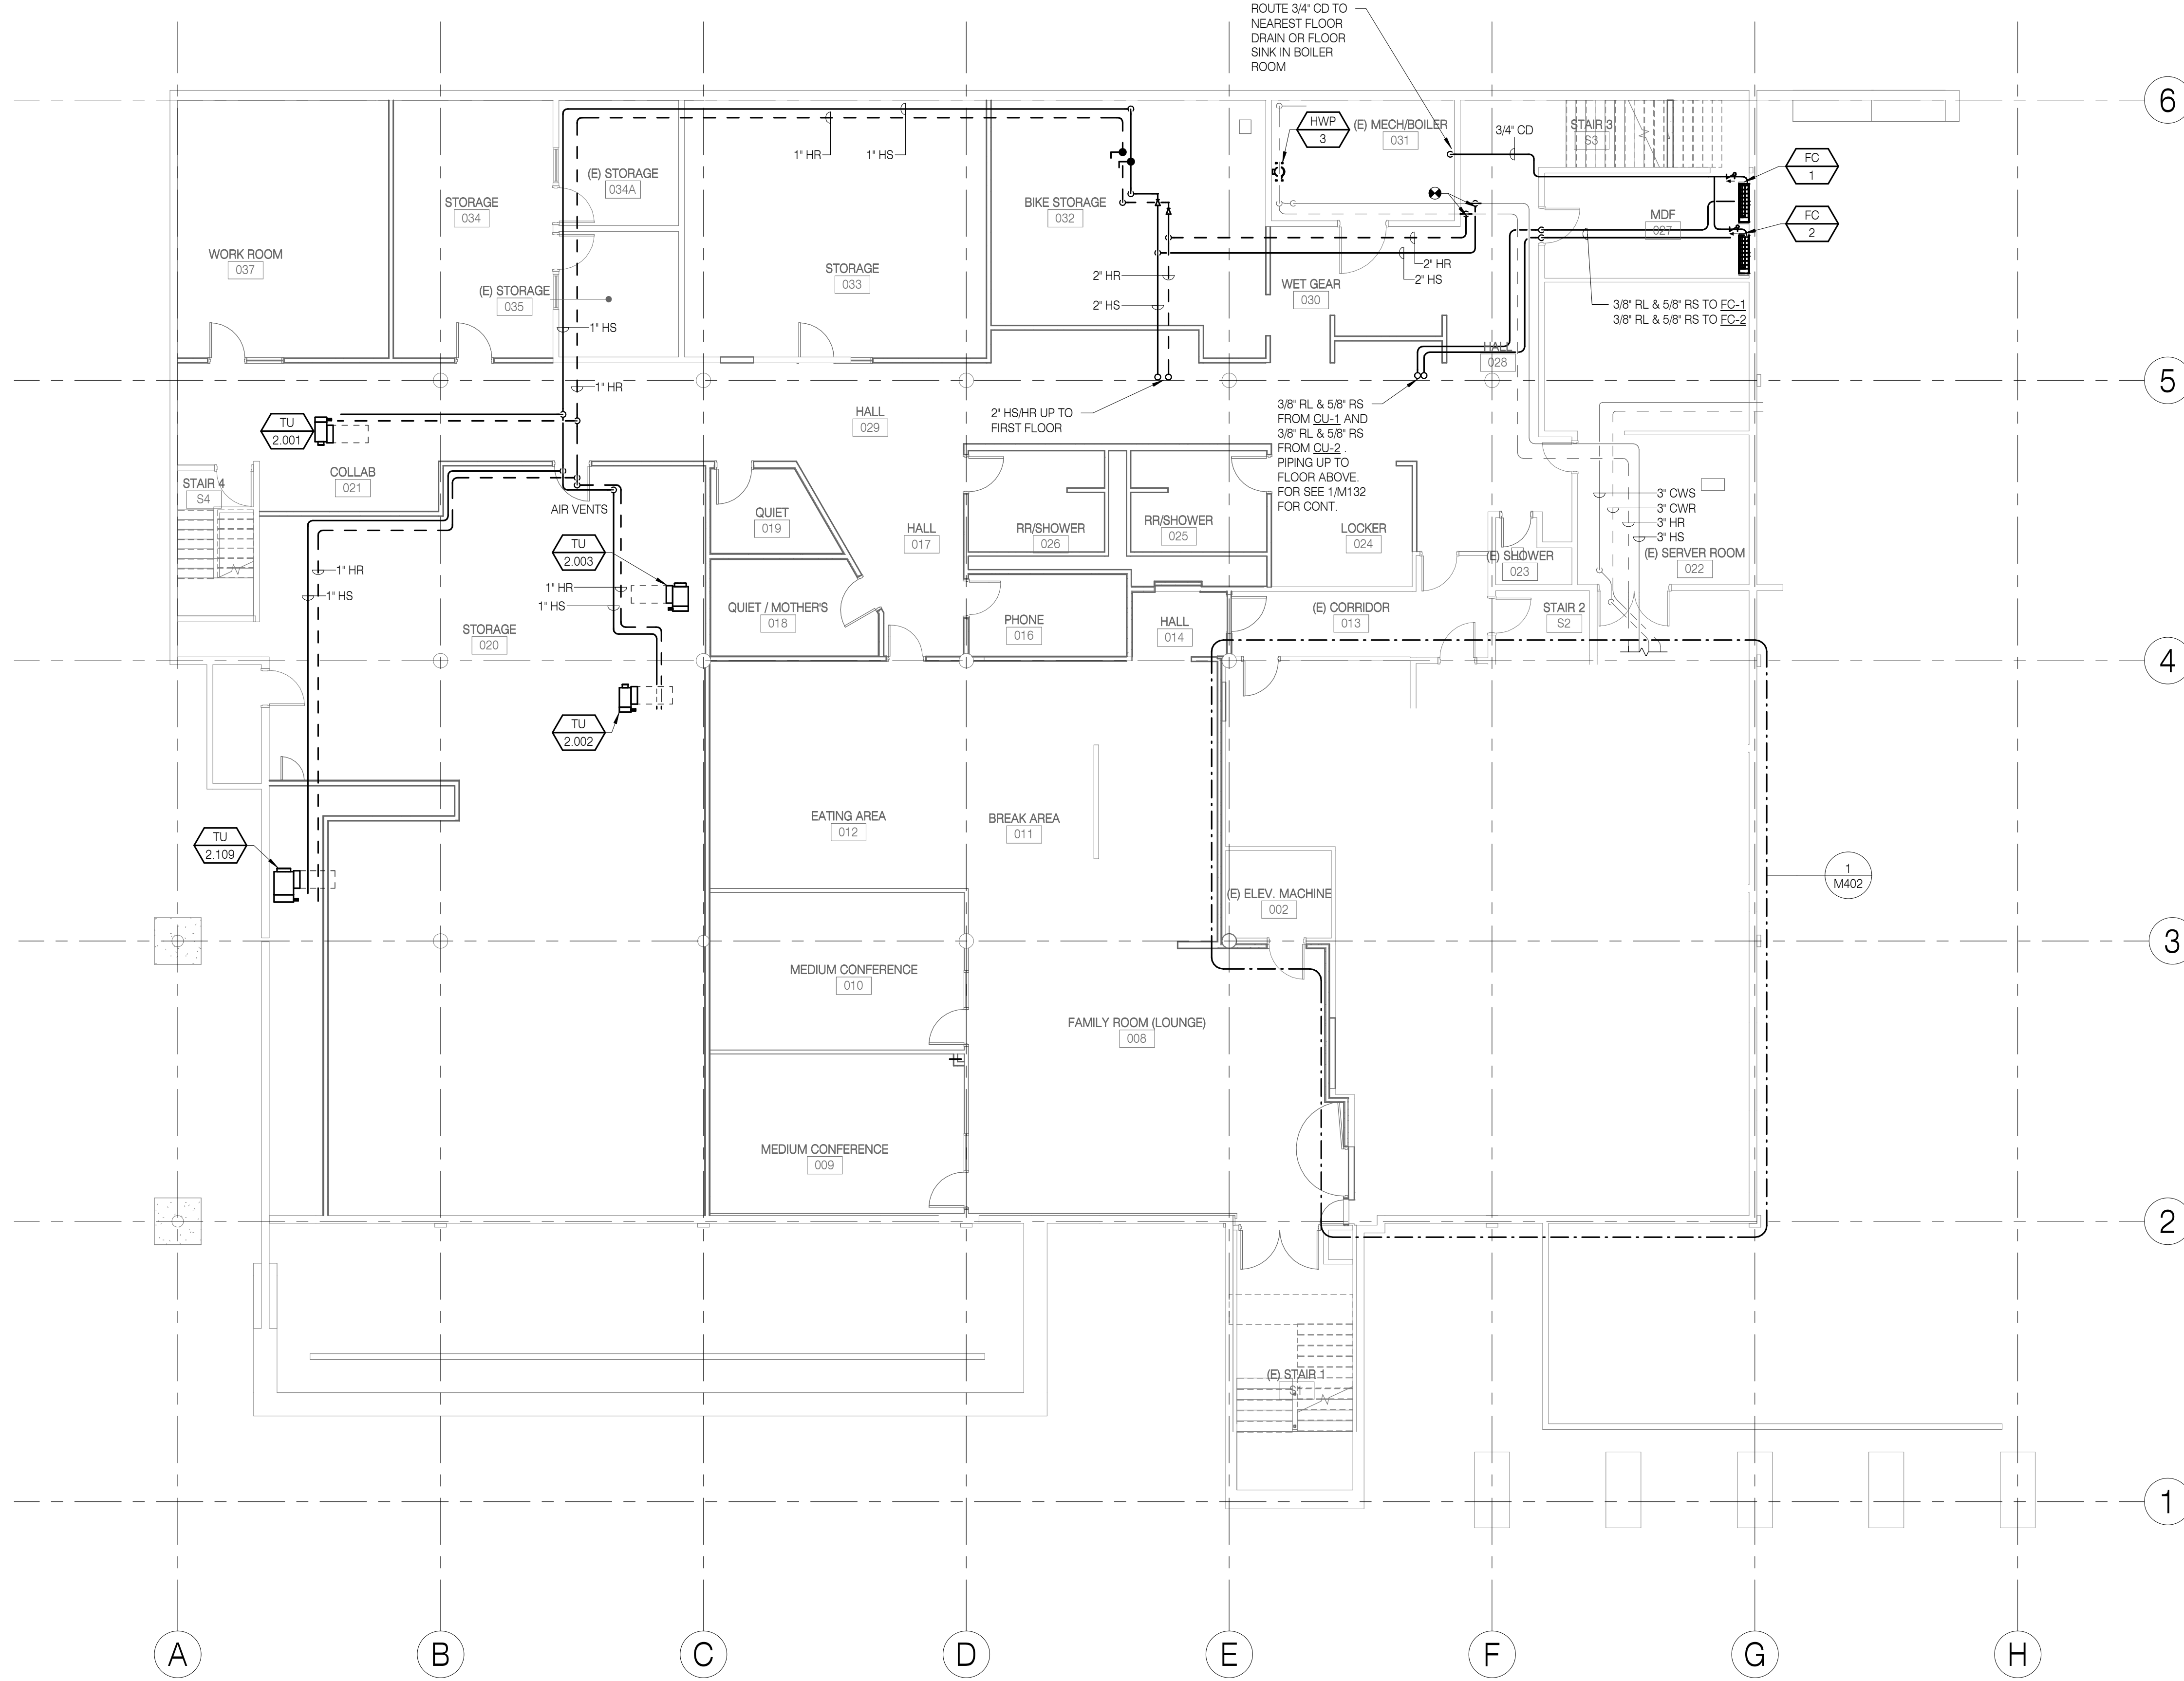

SHEET NOTES:

1. TERMINAL UNIT COIL CONNECTION DETAIL SEE 2/M531.


**RECORD
DRAWING**

NOTE: Documents have been corrected as per data supplied by Contractor and Revision / Change Order Drawings. They do not necessarily show all existing conditions and may not be completely accurate. Field verify existing / hidden conditions prior to commencement of new work.
DATE: AUGUST 20, 2020


SHEET TITLE:
**MECHANICAL
PIPING -
LOWER LEVEL**

REVISIONS:
DESCRP. DATE

ISSUE DATE: 08/20/2020

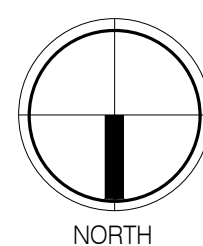

1 MECHANICAL PIPING - LOWER LEVEL
1/8" = 1'-0"

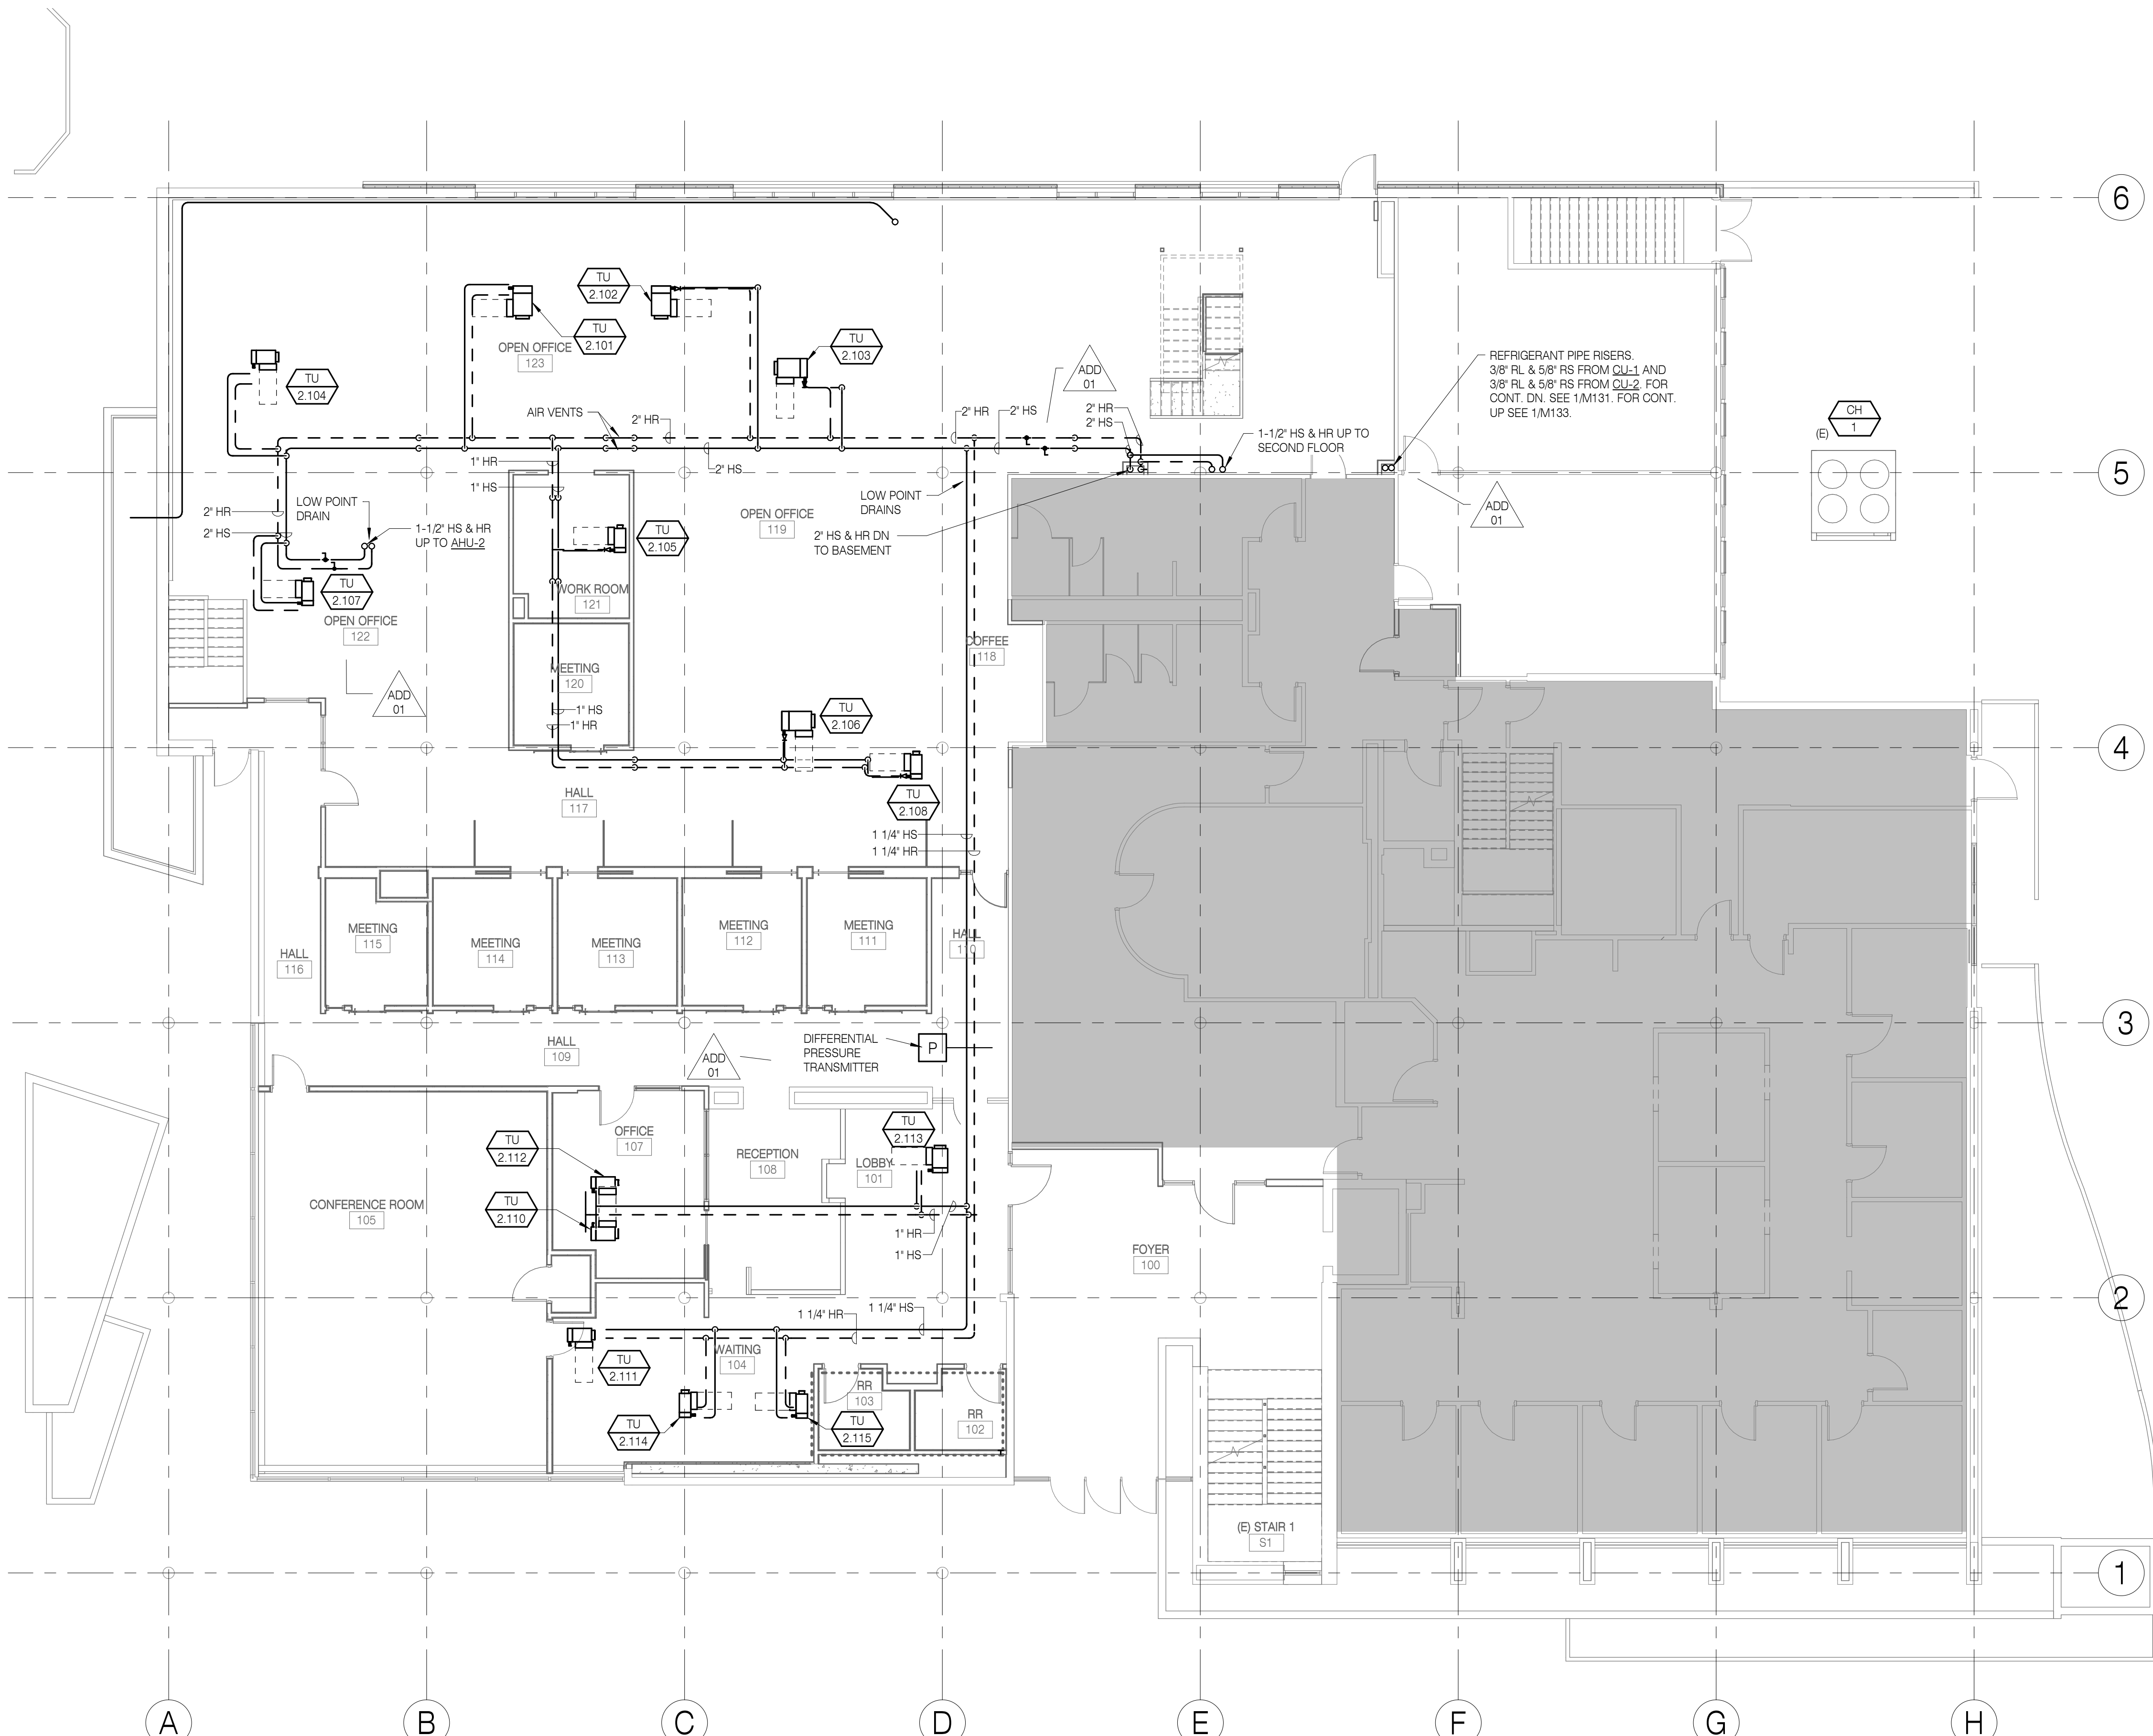

SHEET NOTES

1. TERMINAL UNIT COIL CONNECTION DETAIL SEE 2/M531.


RECORD DRAWING
NOTE: Documents have been corrected as per data supplied by Contractor and Revision / Change Order Drawings. They do not necessarily show all existing conditions and may not be completely accurate. Field verify existing / hidden conditions prior to commencement of new work.
DATE: AUGUST 20, 2020

SHEET TITLE:
MECHANICAL PIPING - FIRST FLOOR

REVISIONS:	#	DESCRP.	DATE
	1	ADD 01	05.17.19

ISSUE DATE: 08/20/2020


M132

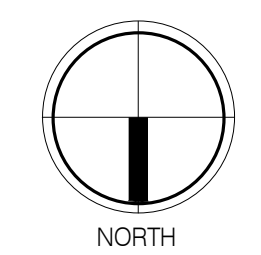

1 MECHANICAL PIPING - FIRST FLOOR
1/8" = 1'-0"

SHEET NOTES:

1. TERMINAL UNIT COIL CONNECTION DETAIL SEE 2/M531.

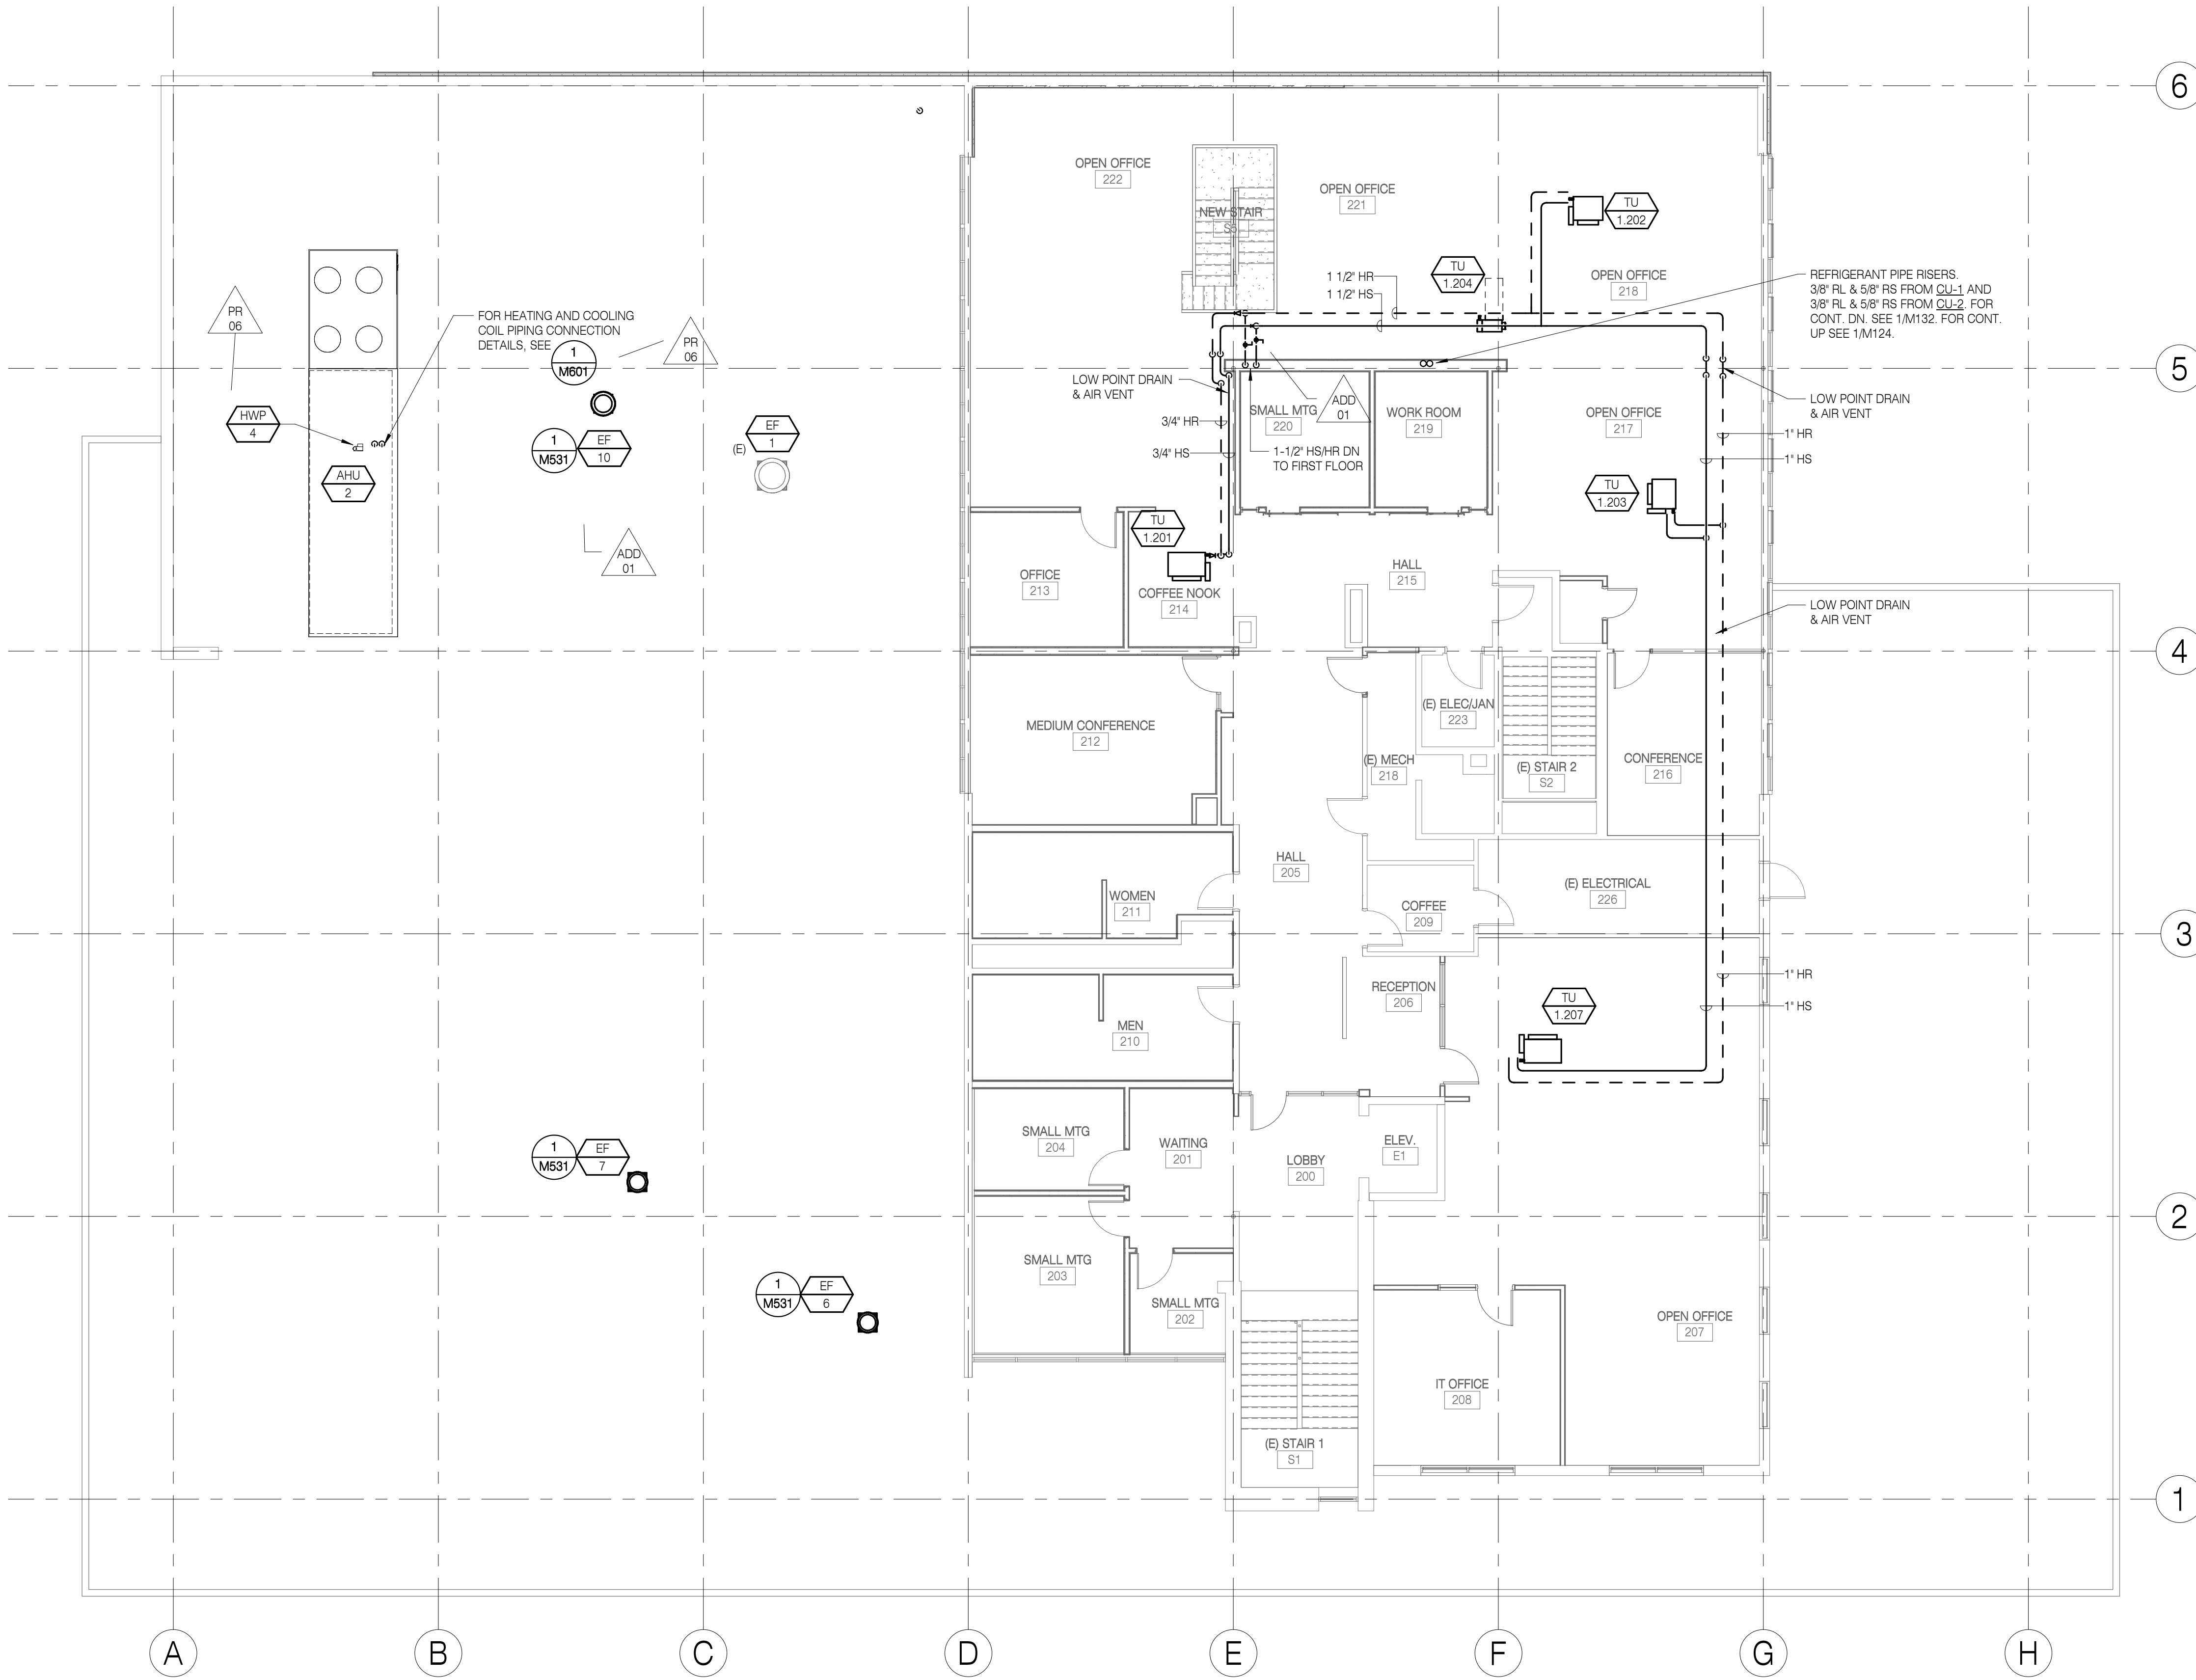


RECORD DRAWING
NOTE: Documents have been corrected as per data supplied by Contractor and Revision / Change Order Drawings. They do not necessarily show all existing conditions and may not be completely accurate. Field verify existing / hidden conditions prior to commencement of new work.
DATE: AUGUST 20, 2020

SHEET TITLE:
MECHANICAL PIPING - SECOND FLOOR



REVISIONS:

#	DESCRP.	DATE
1	ADD 01	05.17.19
11	PR 06	12.03.19

ISSUE DATE: 08/20/2020

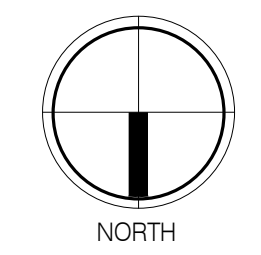

1 MECHANICAL PIPING - SECOND FLOOR
1/8" = 1'-0"

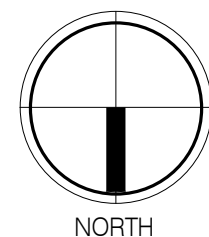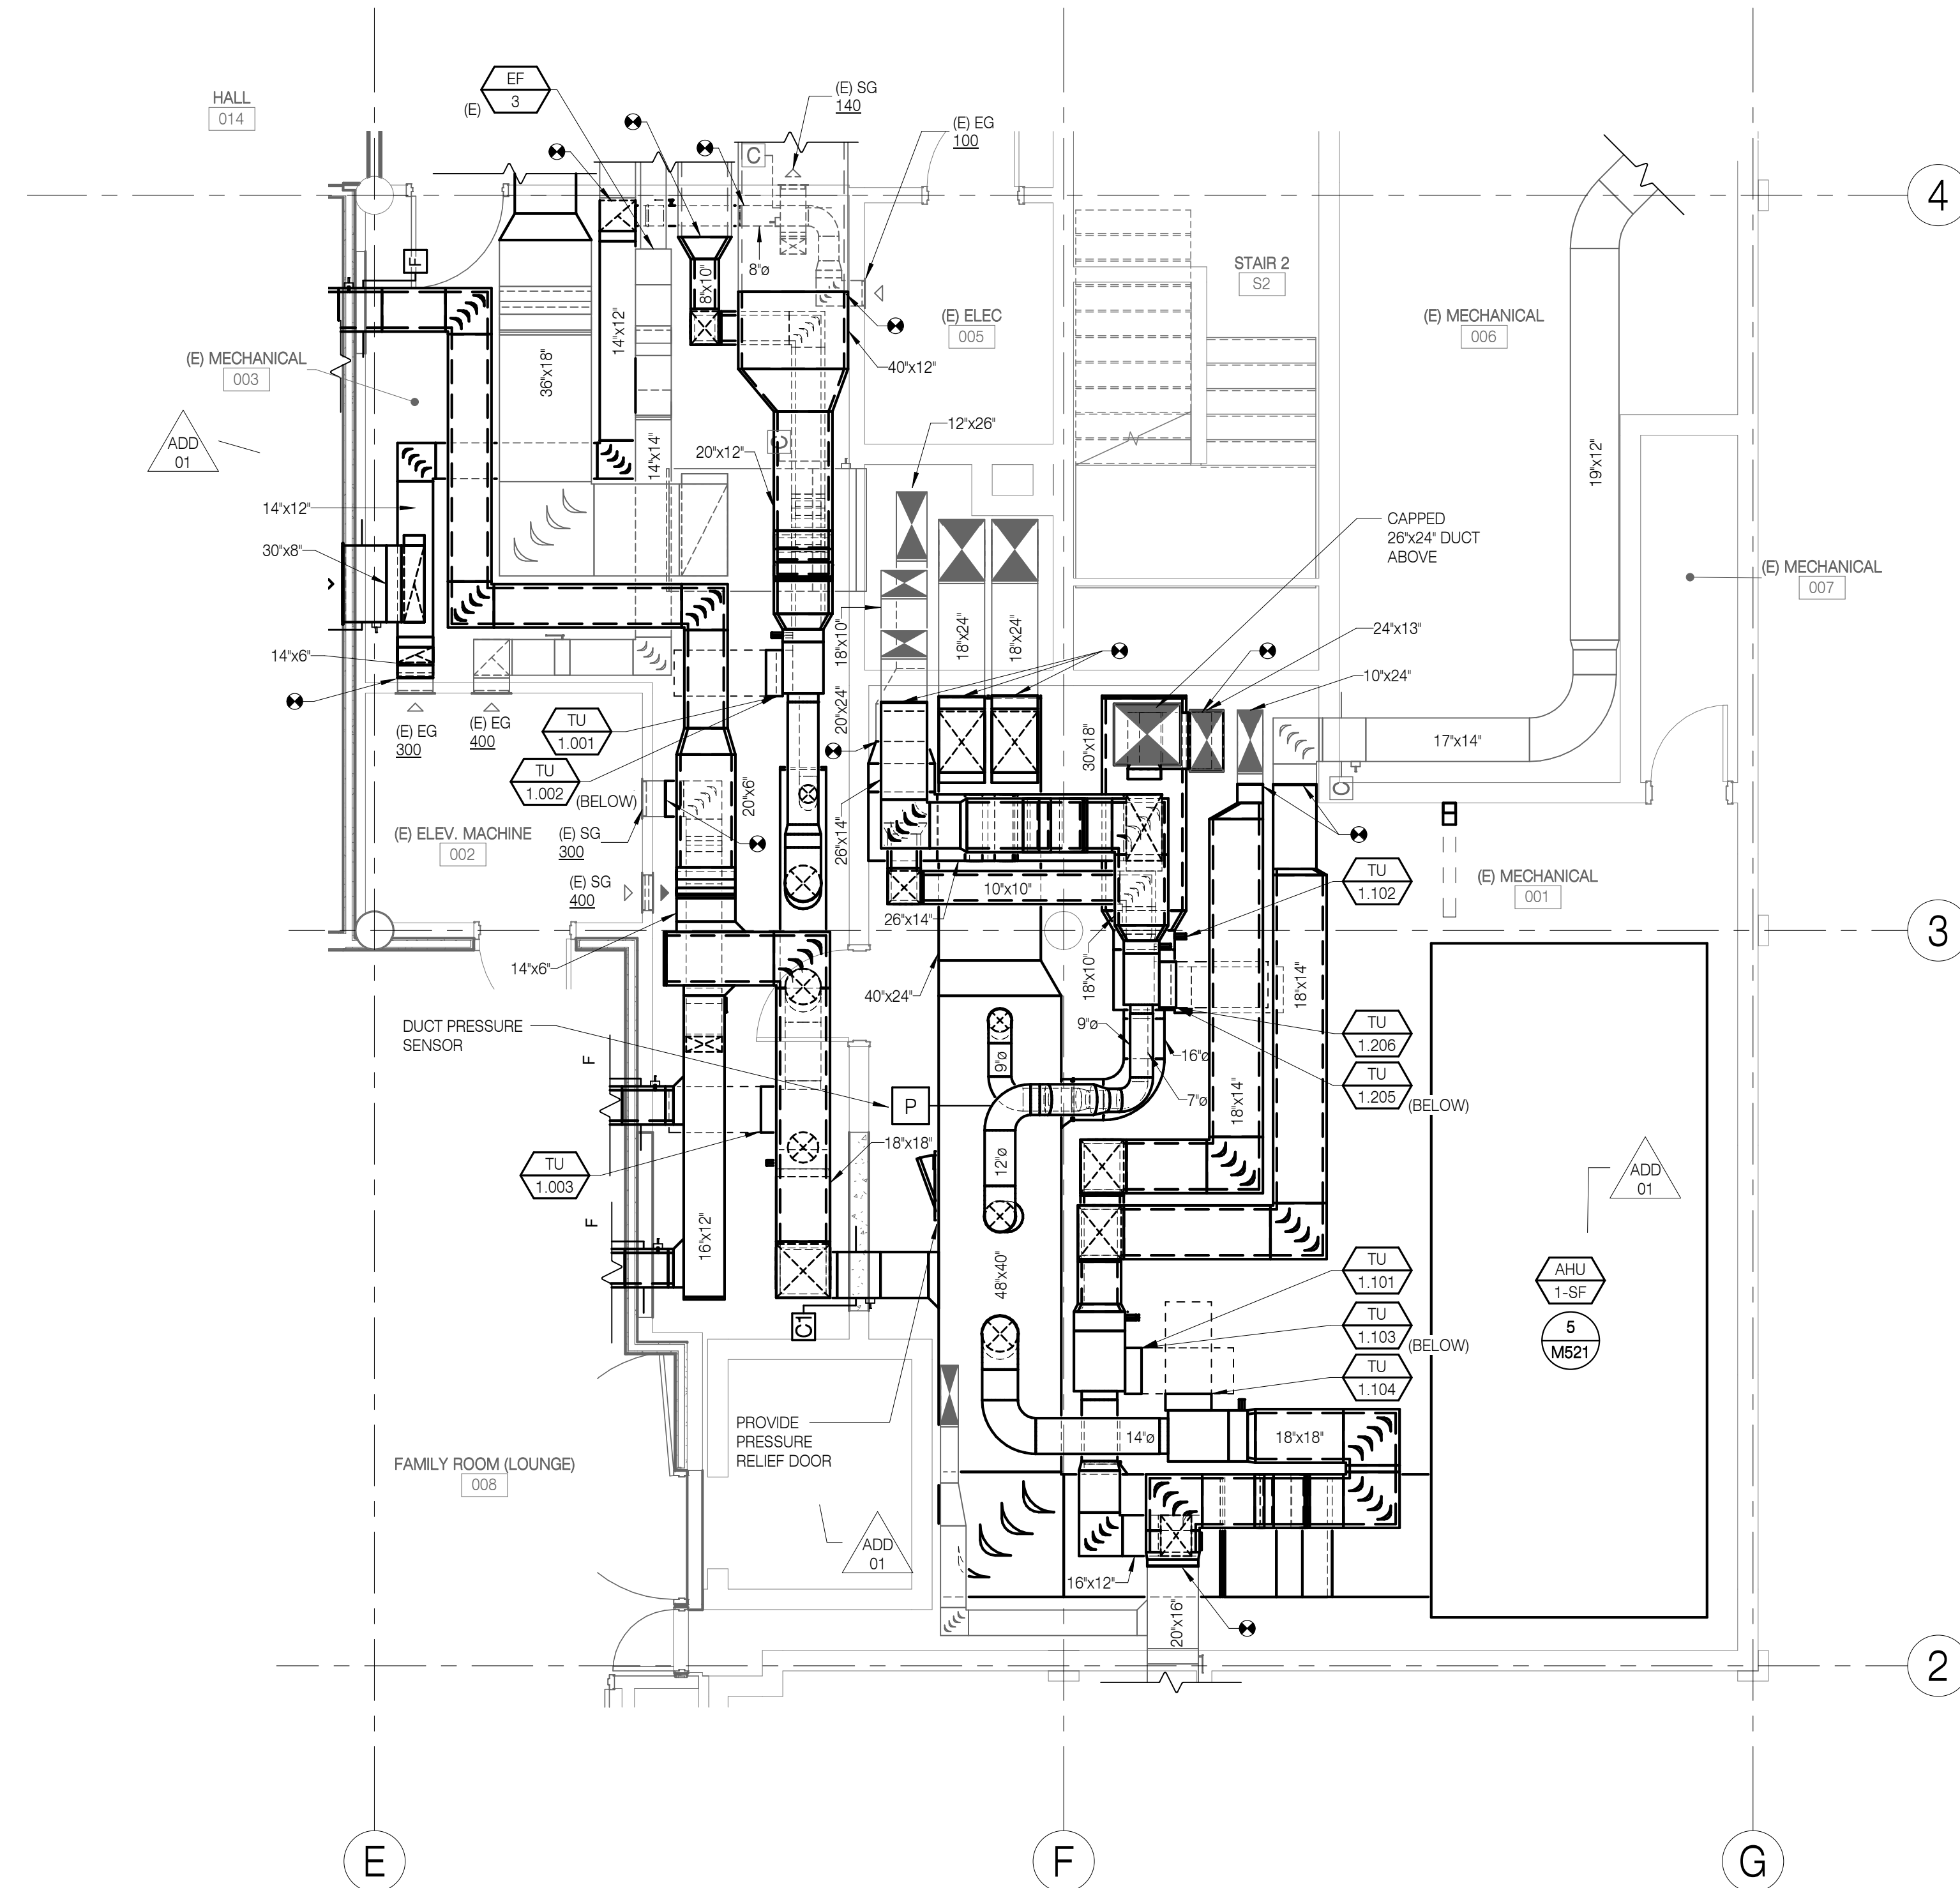

1 AIR DISTRIBUTION - ENLARGED MECHANICAL ROOM
1/4" = 1'-0"

RECORD DRAWING
NOTE: Documents have been corrected as per data supplied by Contractor and Revision / Change Order Drawings. They do not necessarily show all existing conditions and may not be completely accurate. Field verify existing / hidden conditions prior to commencement of new work.
DATE: AUGUST 20, 2020

RECORD DRAWING
20 AUGUST 2020

SW E
SYSTEMS WEST ENGINEERS
725 A Street
Springfield, OR 97477
541.342.7210
systemswestengineers.com
SWE Proj. No. U003.08



RECORD DRAWINGS
HOMES FOR GOOD OFFICE BUILDING REMODEL
100 WEST 30TH AVENUE
EUGENE, OR 97401

SHEET TITLE:
AIR DISTRIBUTION - ENLARGED MECHANICAL ROOM

REVISIONS:

#	DESCRP.	DATE
1	ADD 01	05.17.19

ISSUE DATE: 08/20/2020

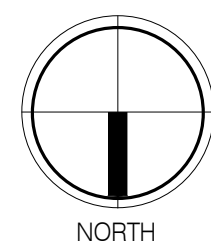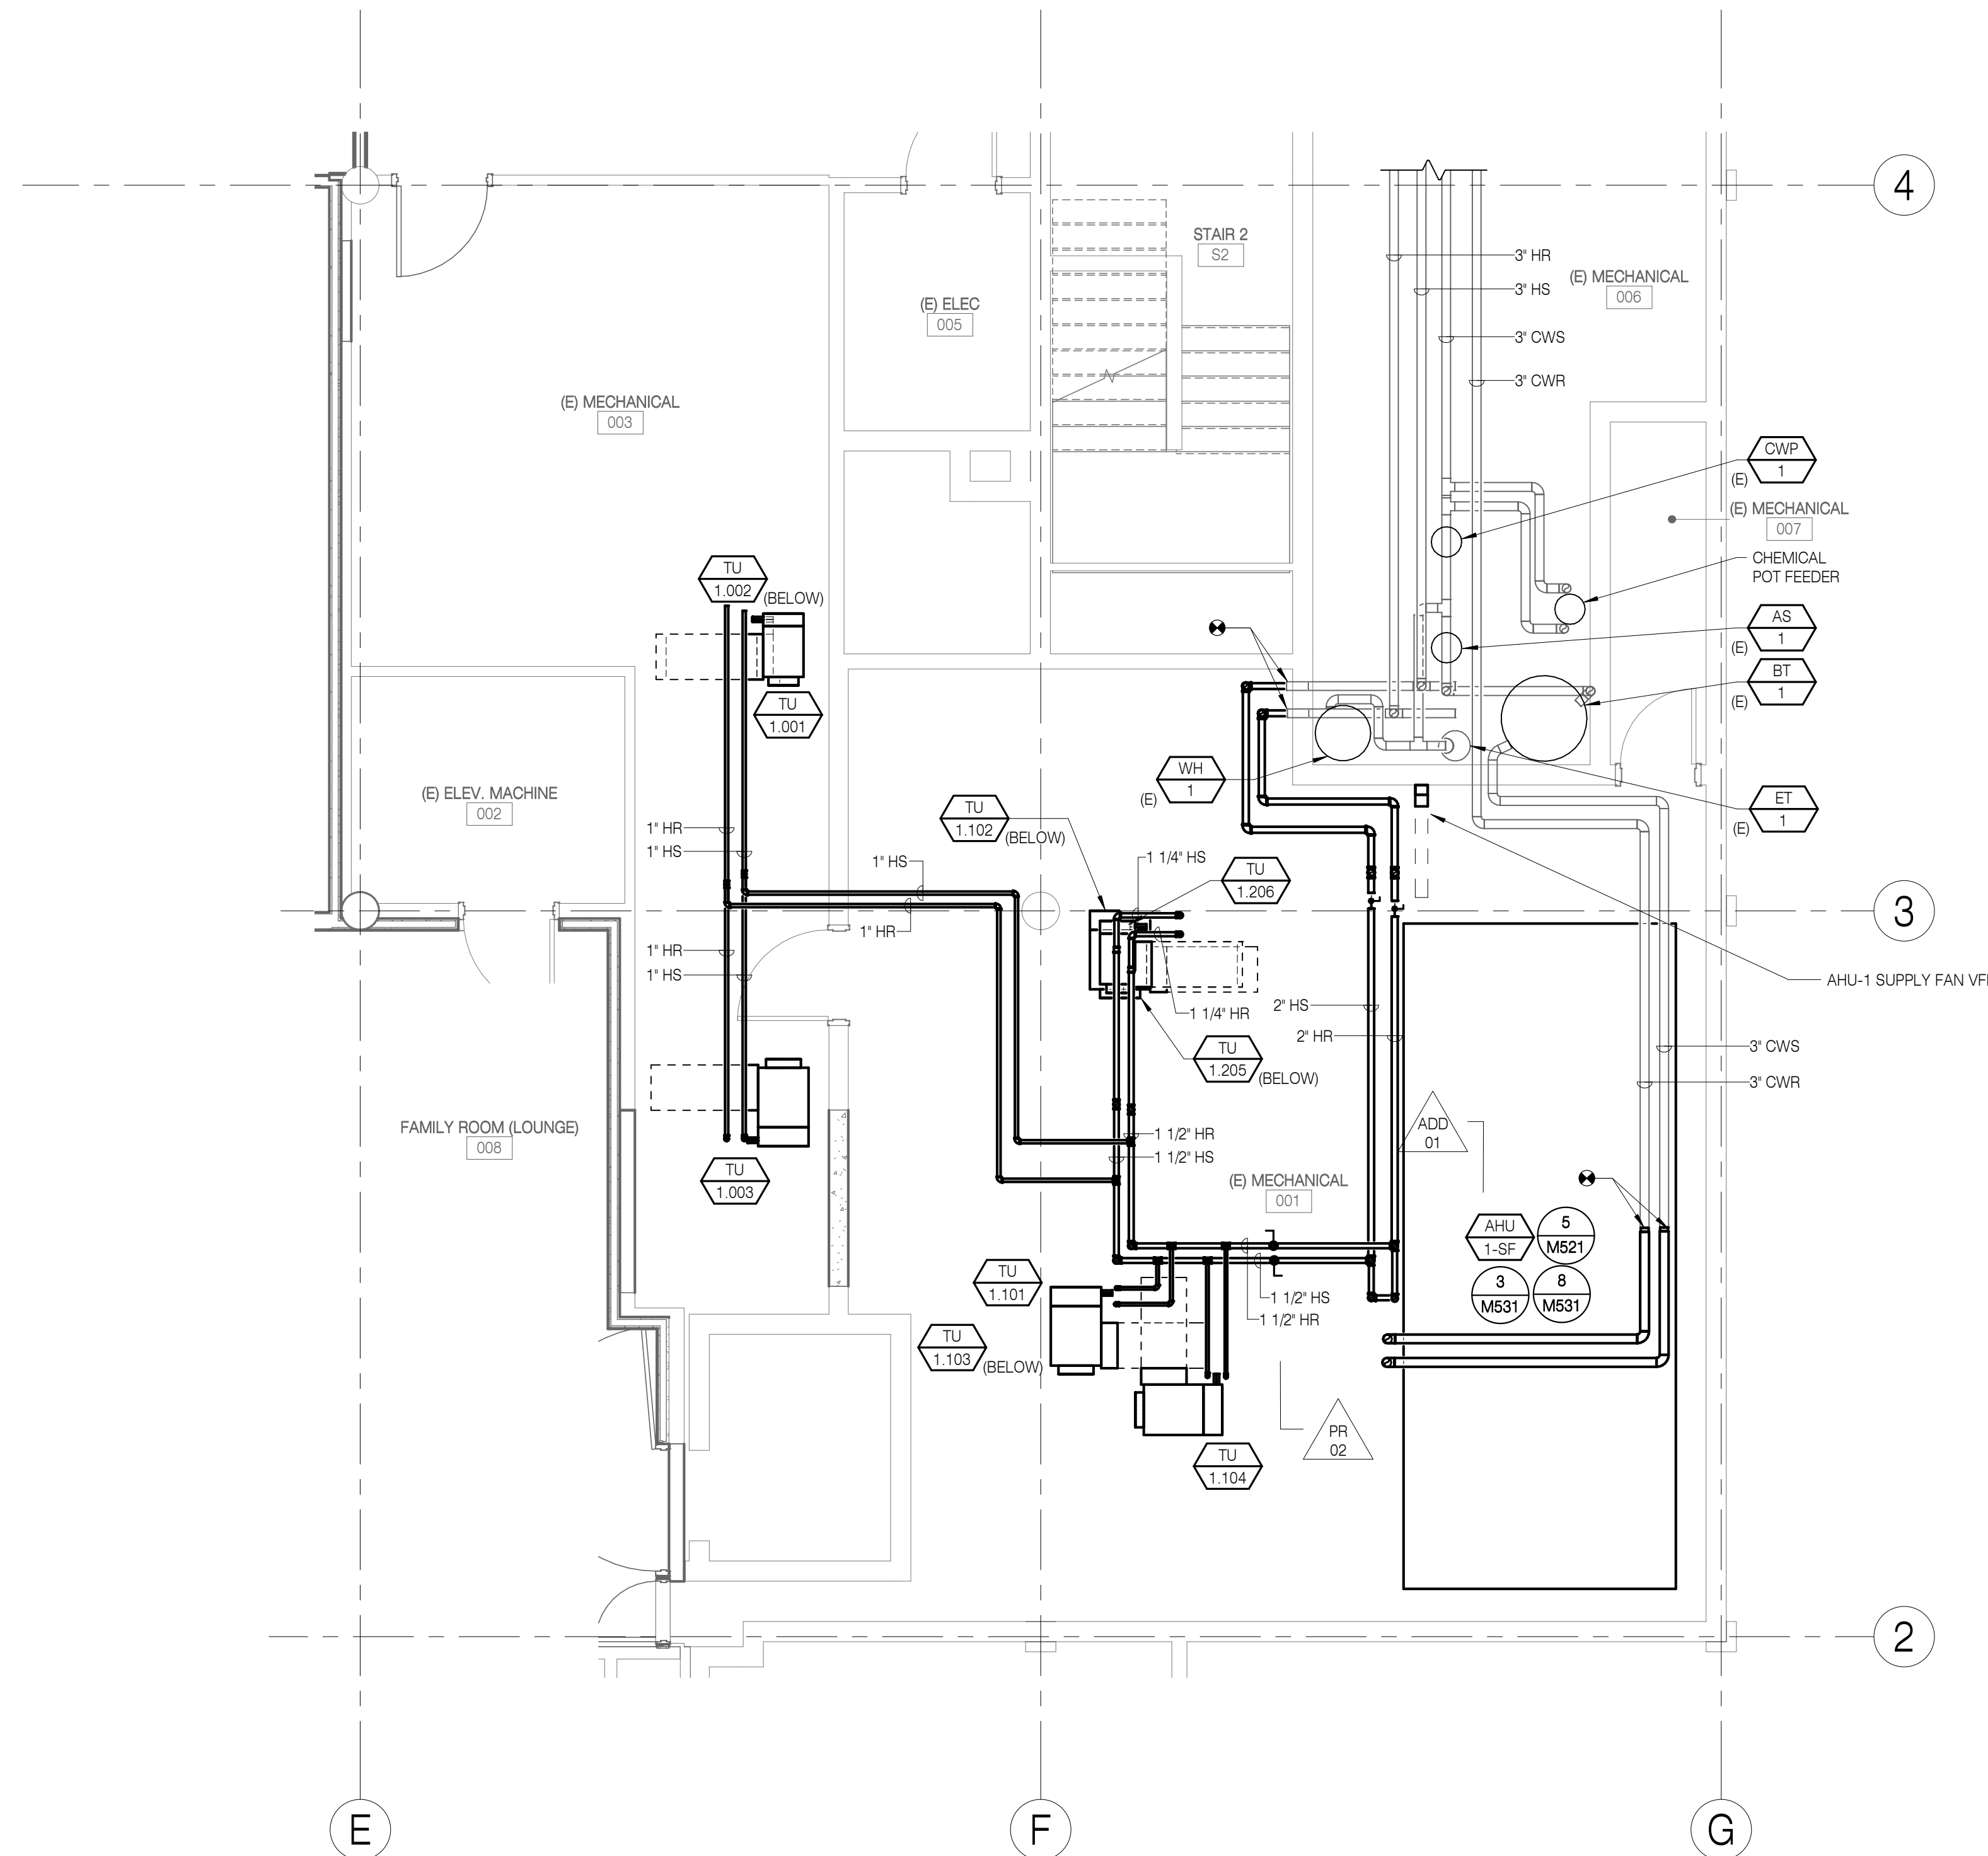

1

MECHANICAL PIPING - ENLARGED MECANICAL ROOM

1/4" = 1'-0"

RECORD DRAWING
 NOTE: Documents have been corrected as per data supplied by Contractor and Revision / Change Order Drawings. They do not necessarily show all existing conditions and may not be completely accurate. Field verify existing / hidden conditions prior to commencement of new work.
 DATE: AUGUST 20, 2020

RECORD DRAWING
 20 AUGUST 2020

SW E
 SYSTEMS WEST ENGINEERS
 725 A Street
 Springfield, OR 97477
 541.342.7210
 systemswestengineers.com
 SWE Proj. No. U003.08

RECORD DRAWINGS
 HOMES FOR GOOD OFFICE BUILDING
 REMODEL
 100 WEST 30TH AVENUE
 EUGENE, OR 97401


SHEET TITLE:
MECHANICAL PIPING - ENLARGED MECHANICAL ROOM

REVISIONS:


#	DESCRP.	DATE
1	ADD 01	05.17.19
3	PR 02	07.24.19

ISSUE DATE: 08/20/2020


M402

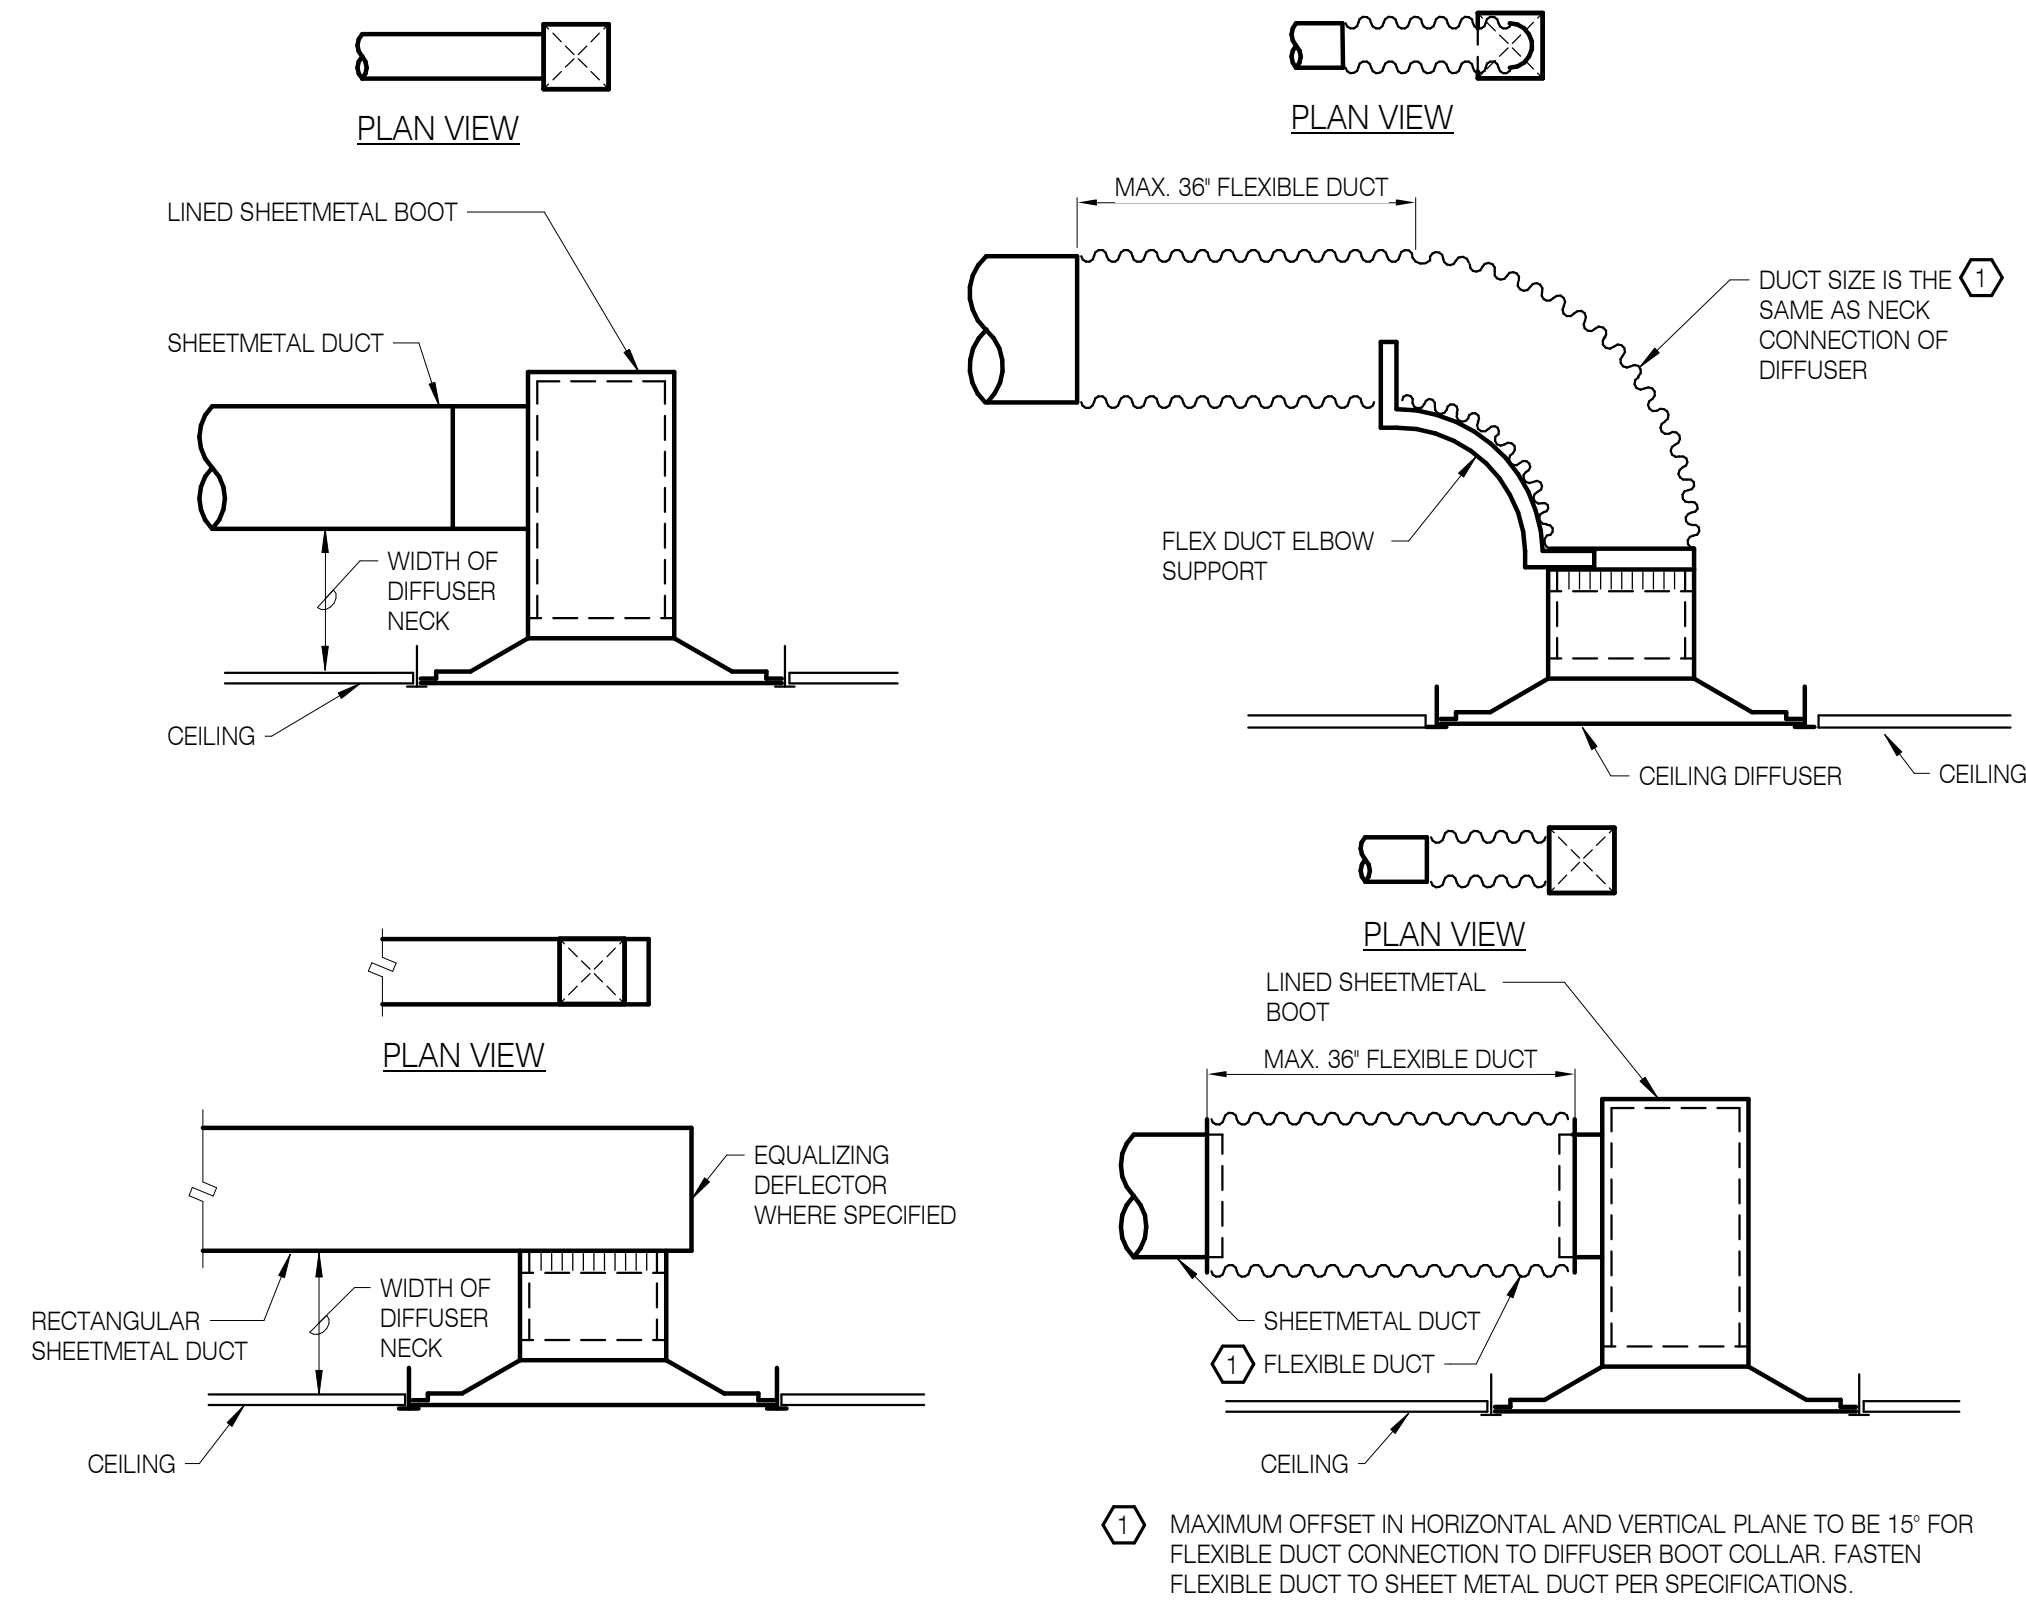


1 DIFFUSER GRILL & REGISTER CONNECTION
NOT TO SCALE

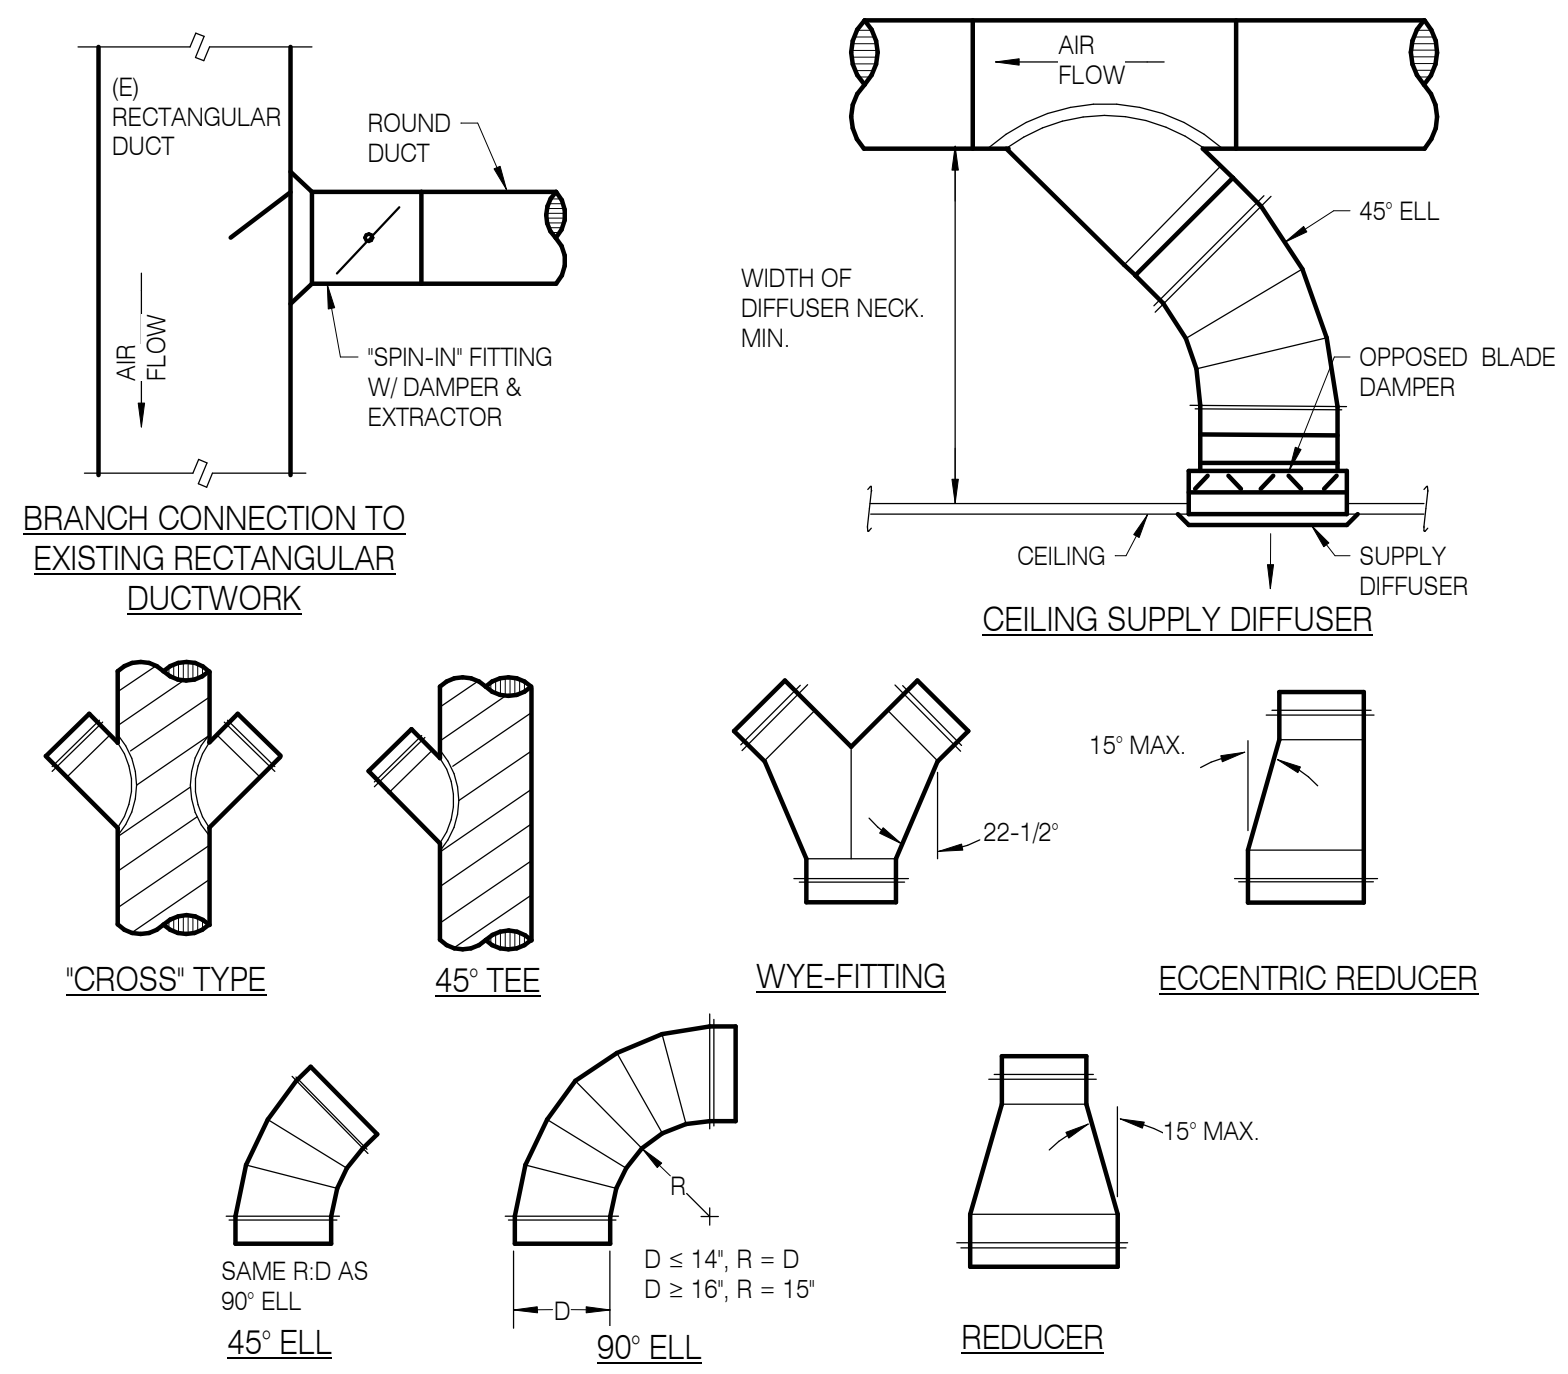


2 ROUND DUCT CONSTRUCTION
NOT TO SCALE

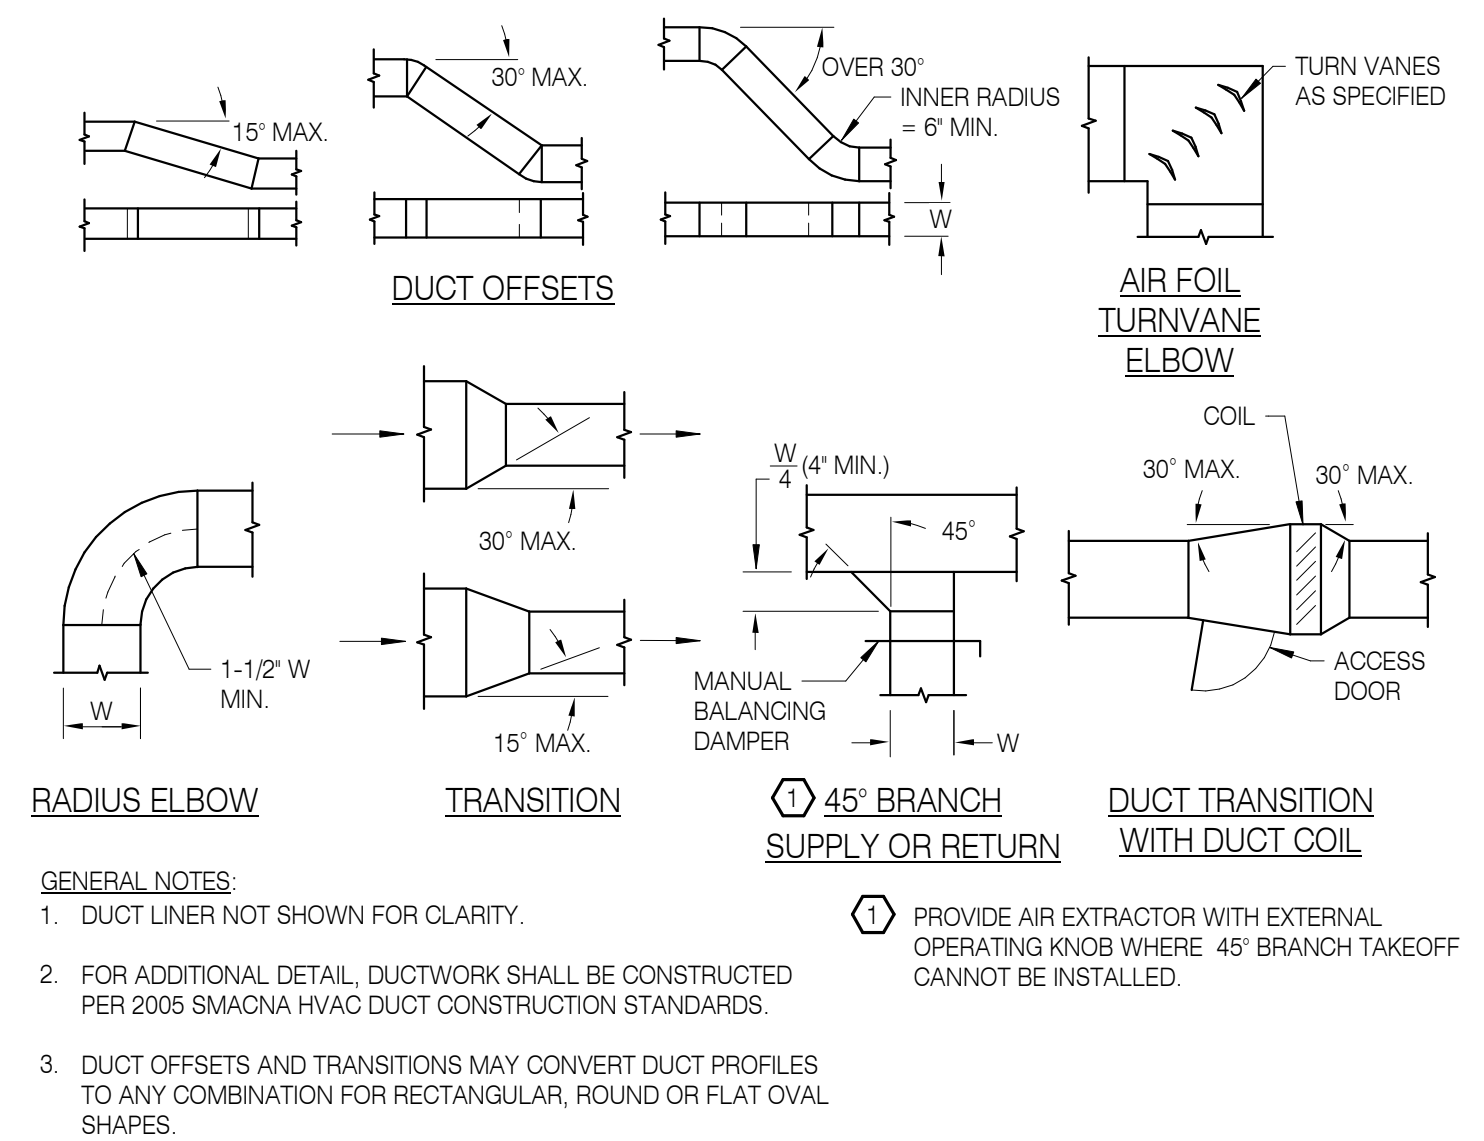

3 DUCT CONSTRUCTION
NOT TO SCALE

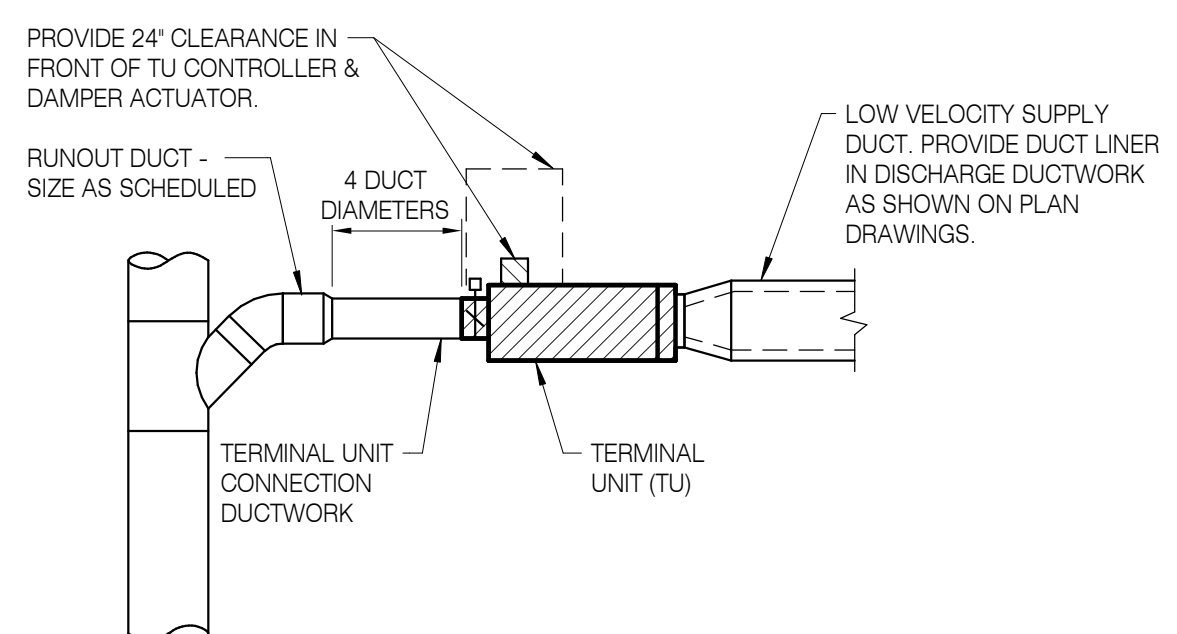

4 TERMINAL UNITS (TU)
NOT TO SCALE

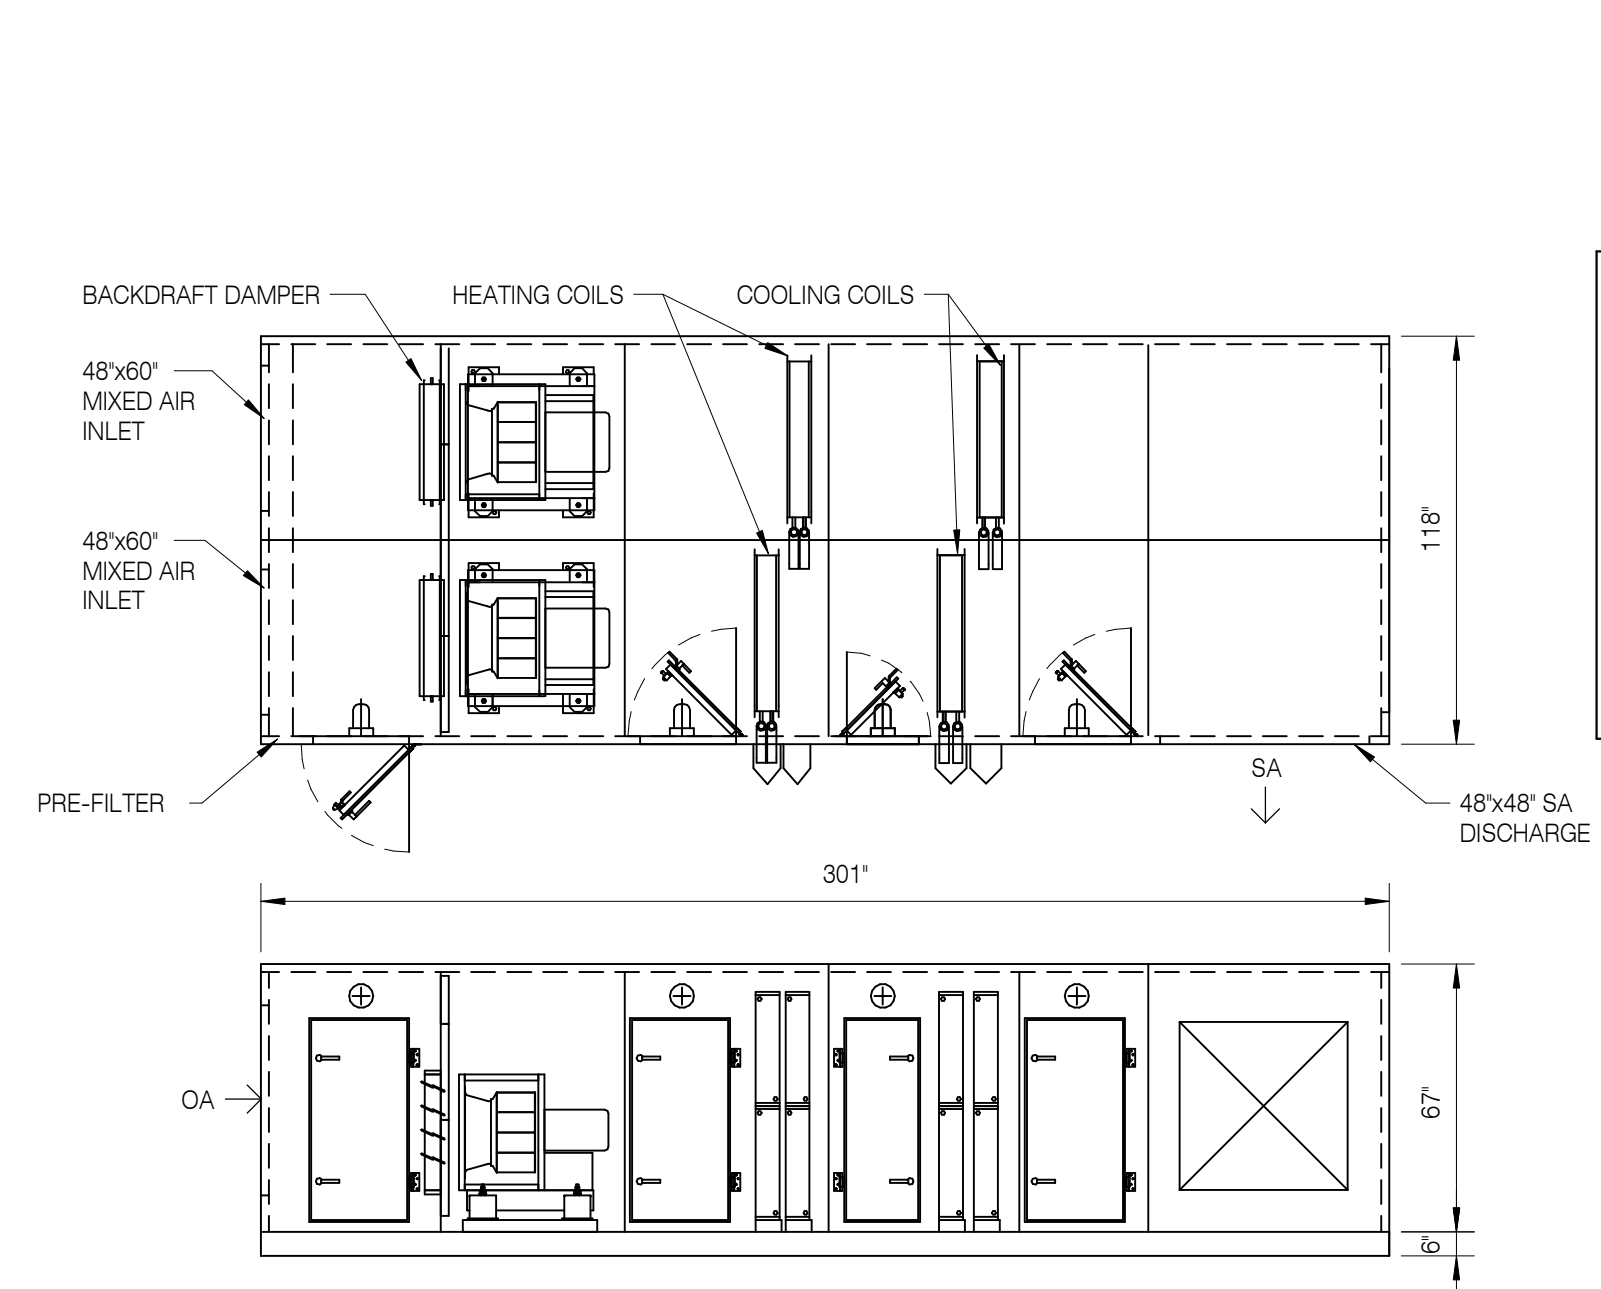

5 AHU-1 SF
NOT TO SCALE

RECORD DRAWING
NOTE: Documents have been corrected as per data supplied by Contractor and Revision / Change Order Drawings. They do not necessarily show all existing conditions and may not be completely accurate. Field verify existing / hidden conditions prior to commencement of new work.
DATE: AUGUST 20, 2020

RECORD DRAWING
20 AUGUST 2020

SW E
SYSTEMS WEST ENGINEERS
725 A Street
Springfield, OR 97477
541.342.7210
systemswestengineers.com
SWE Proj. No. U003.08

RECORD DRAWINGS
HOMES FOR GOOD OFFICE BUILDING
REMODEL
100 WEST 10TH AVENUE
EUGENE, OR 97401


SHEET TITLE:
DETAILS

REVISIONS:


#	DESCRIP.	DATE
1	ADD 01	05.17.19

ISSUE DATE: 08/20/2020


M521

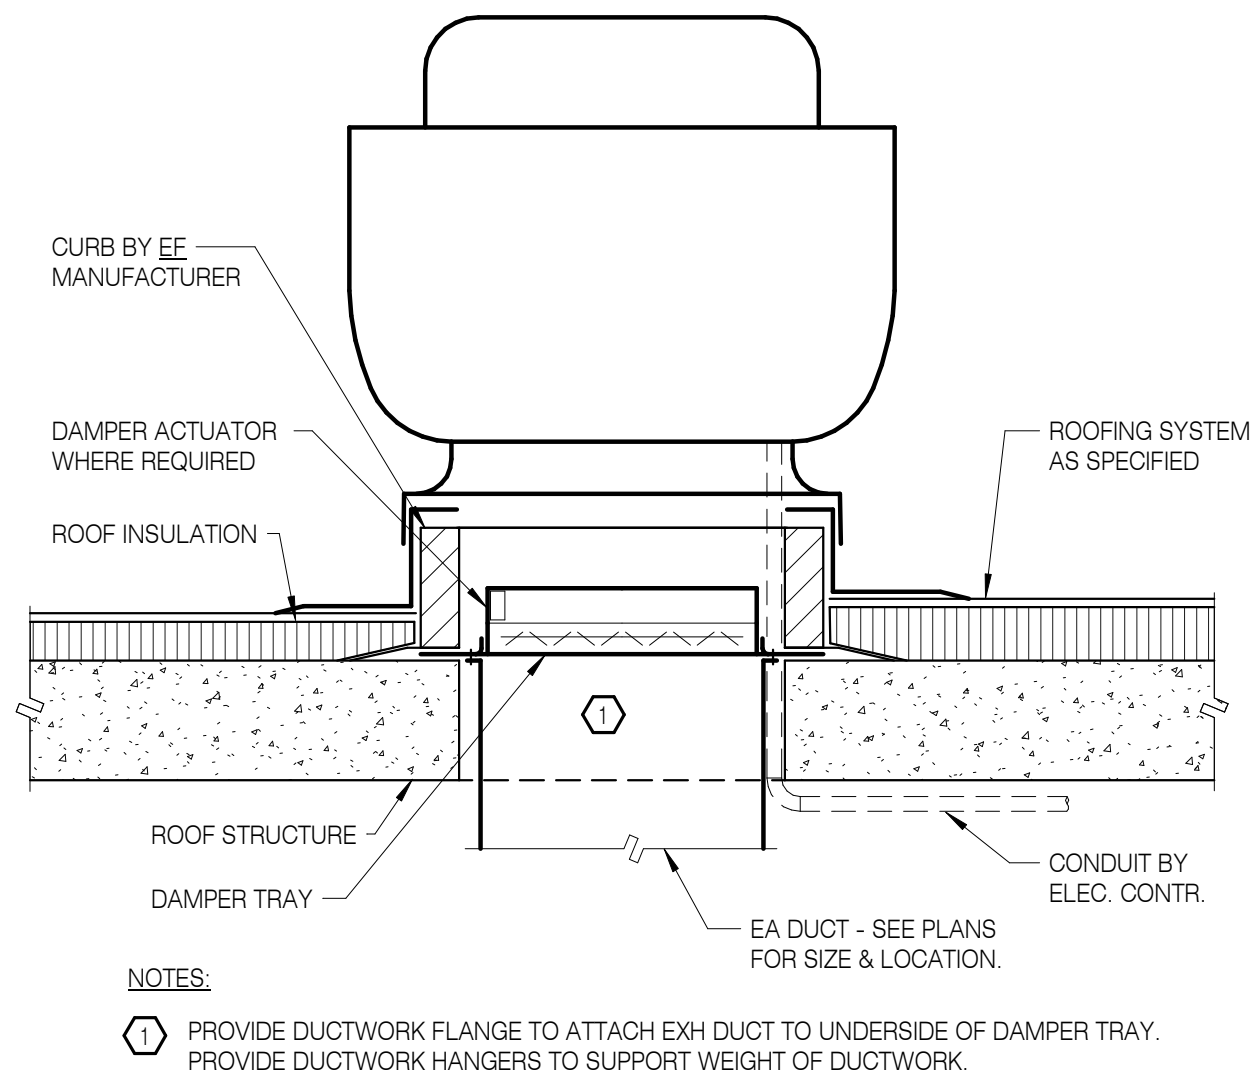


1 ROOF EXHAUST FAN
NOT TO SCALE

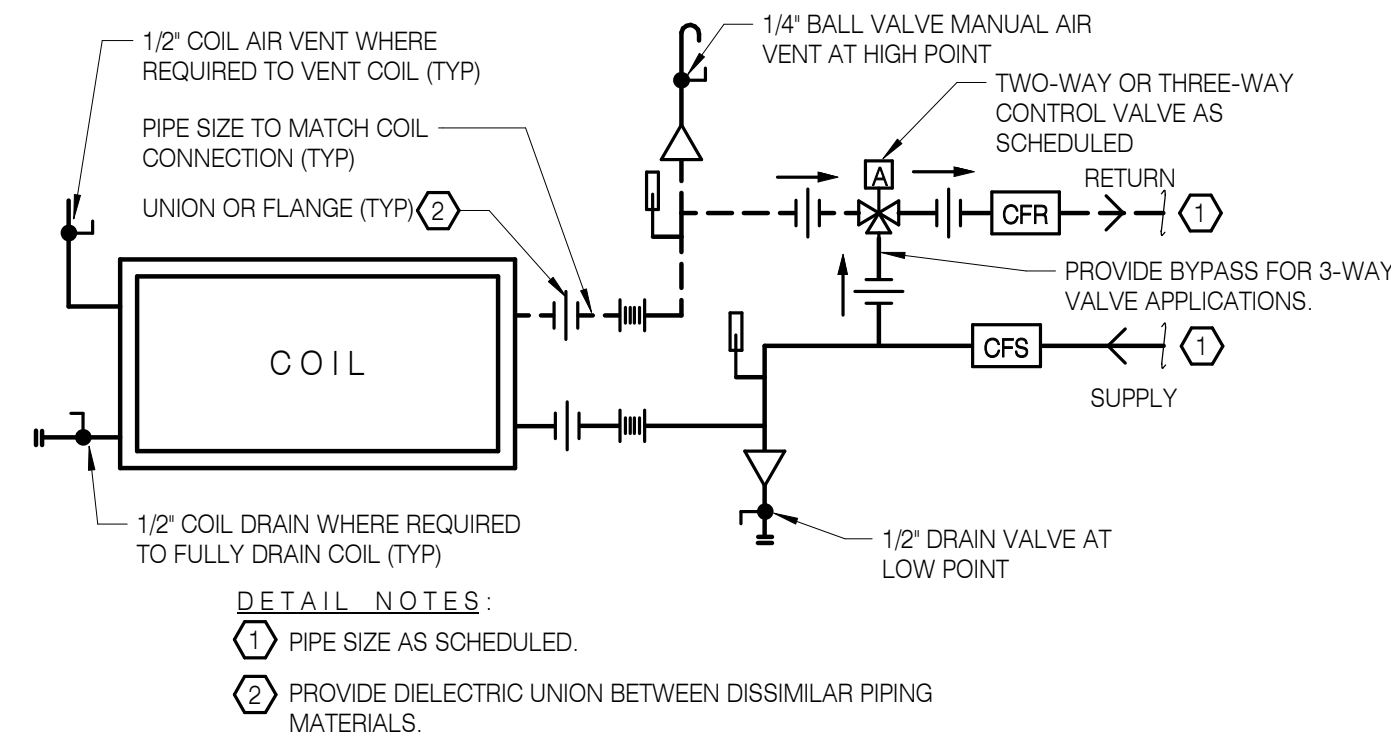


2 HEATING / COOLING COIL - SINGLE - TWO OR THREE WAY - 2" AND SMALLER
NOT TO SCALE

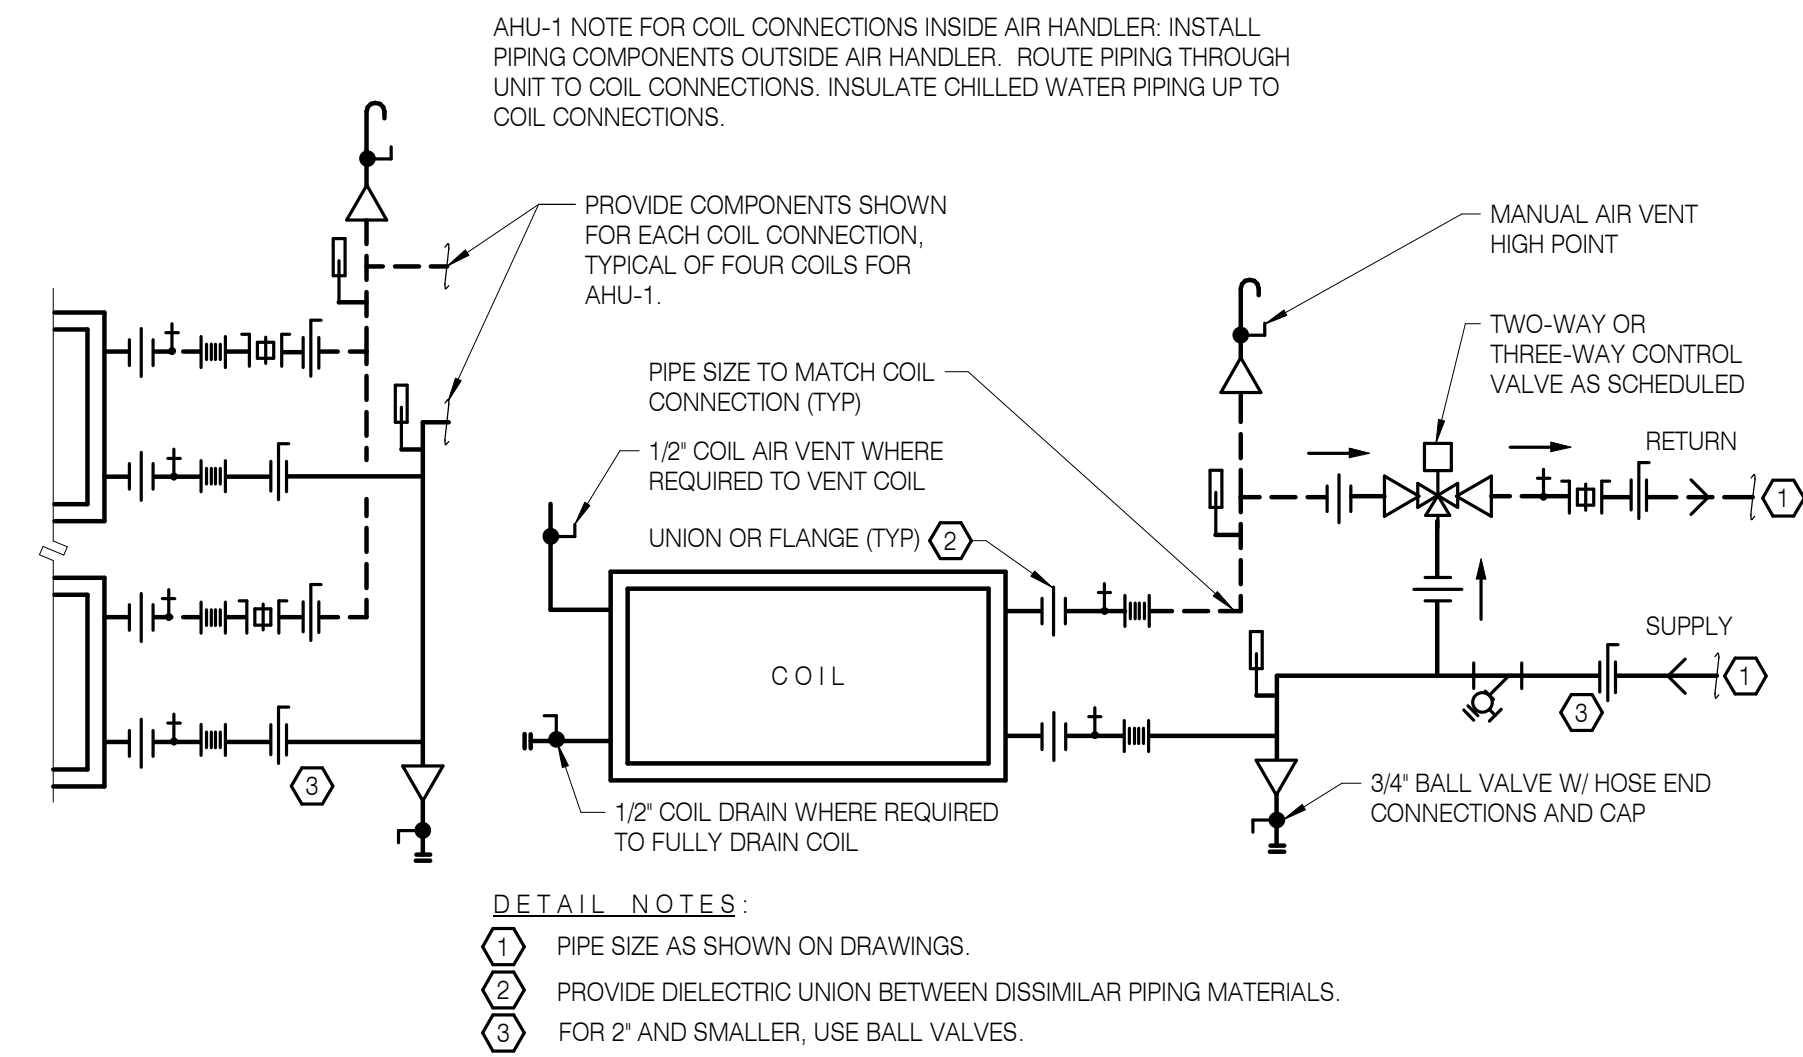


3 HEATING / COOLING COIL - SINGLE - THREE-WAY
NOT TO SCALE

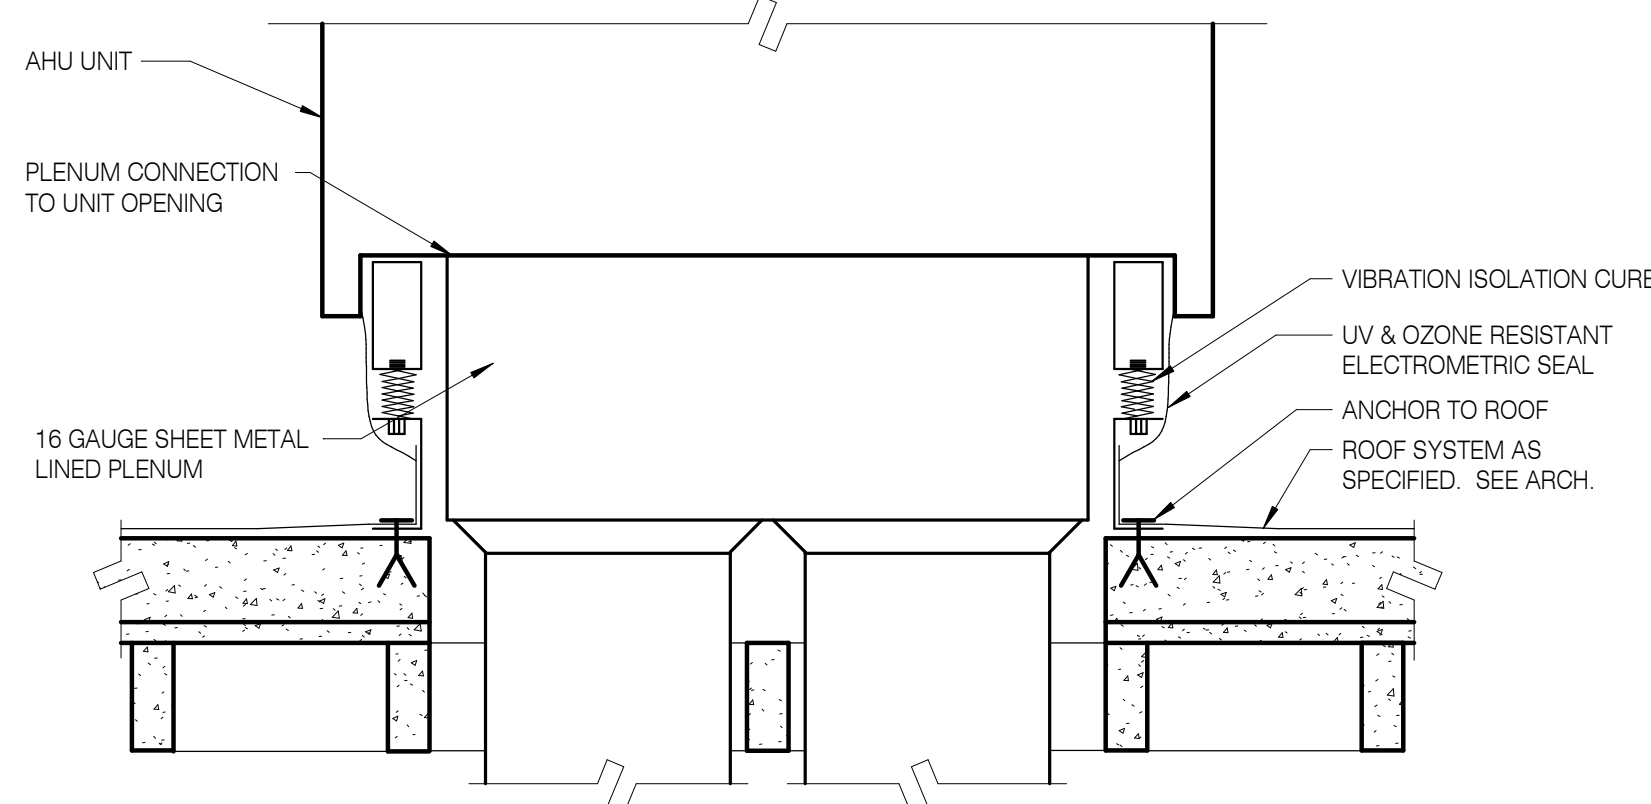


4 AHU DUCT CONNECTIONS
NOT TO SCALE

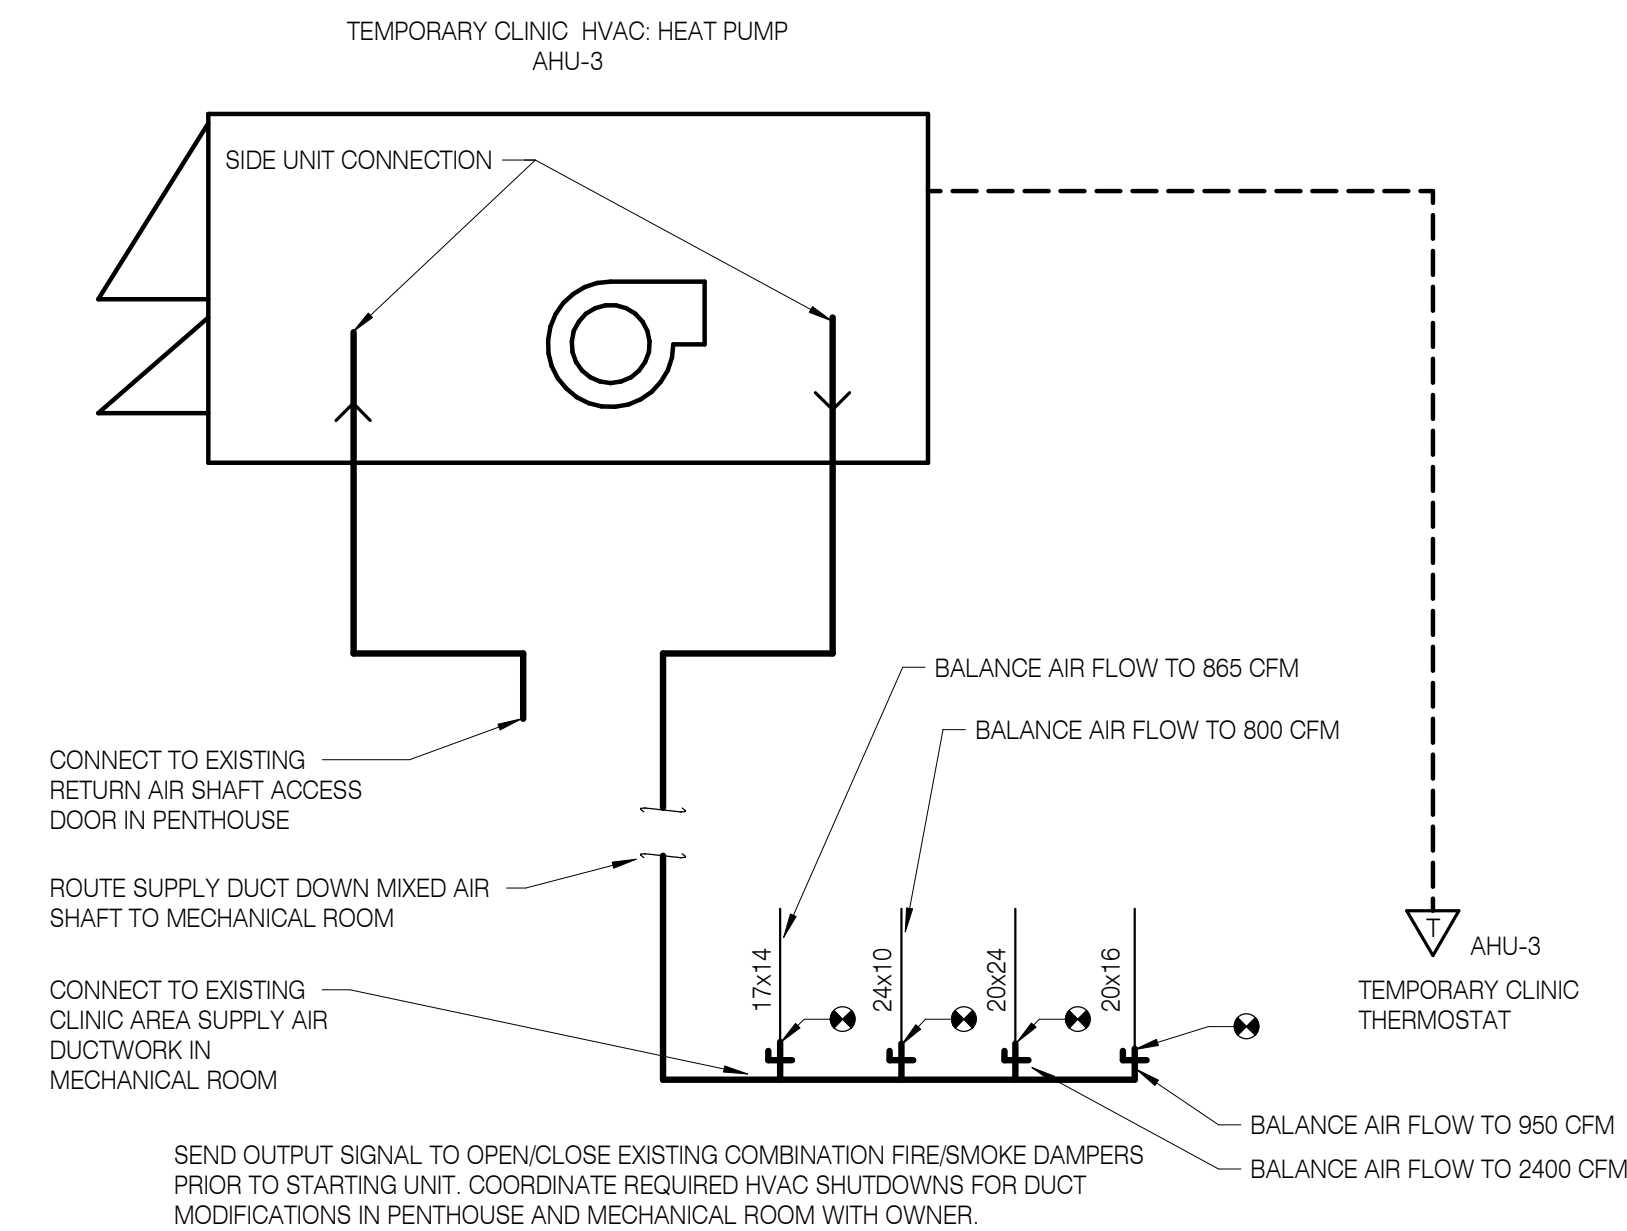


5 CLINIC AREA TEMPORARY HVAC
NOT TO SCALE

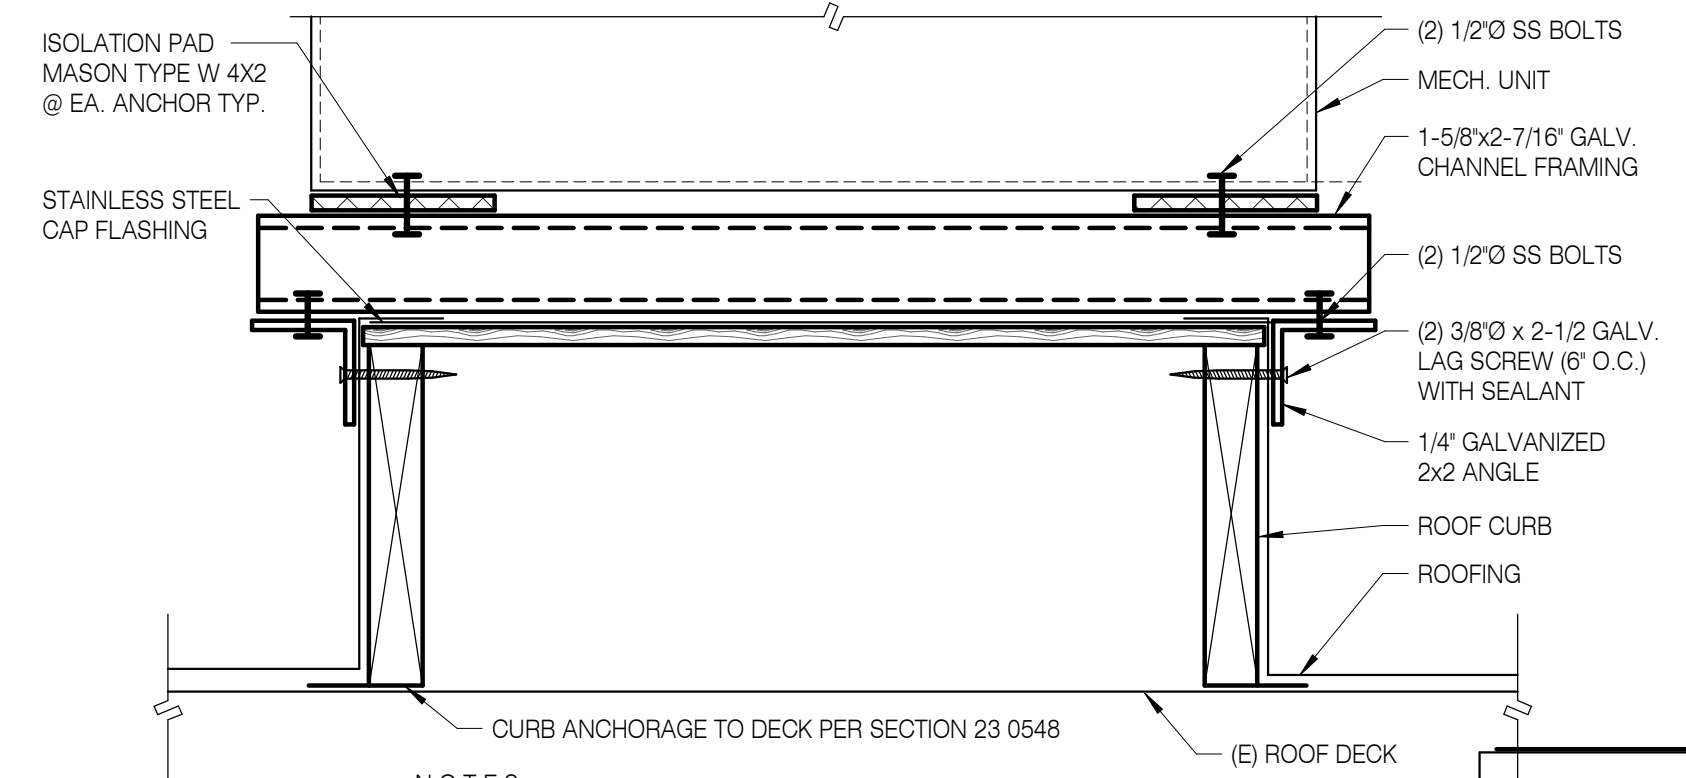

6 ROOFTOP CONDENSING UNIT ROOF CURB
NOT TO SCALE

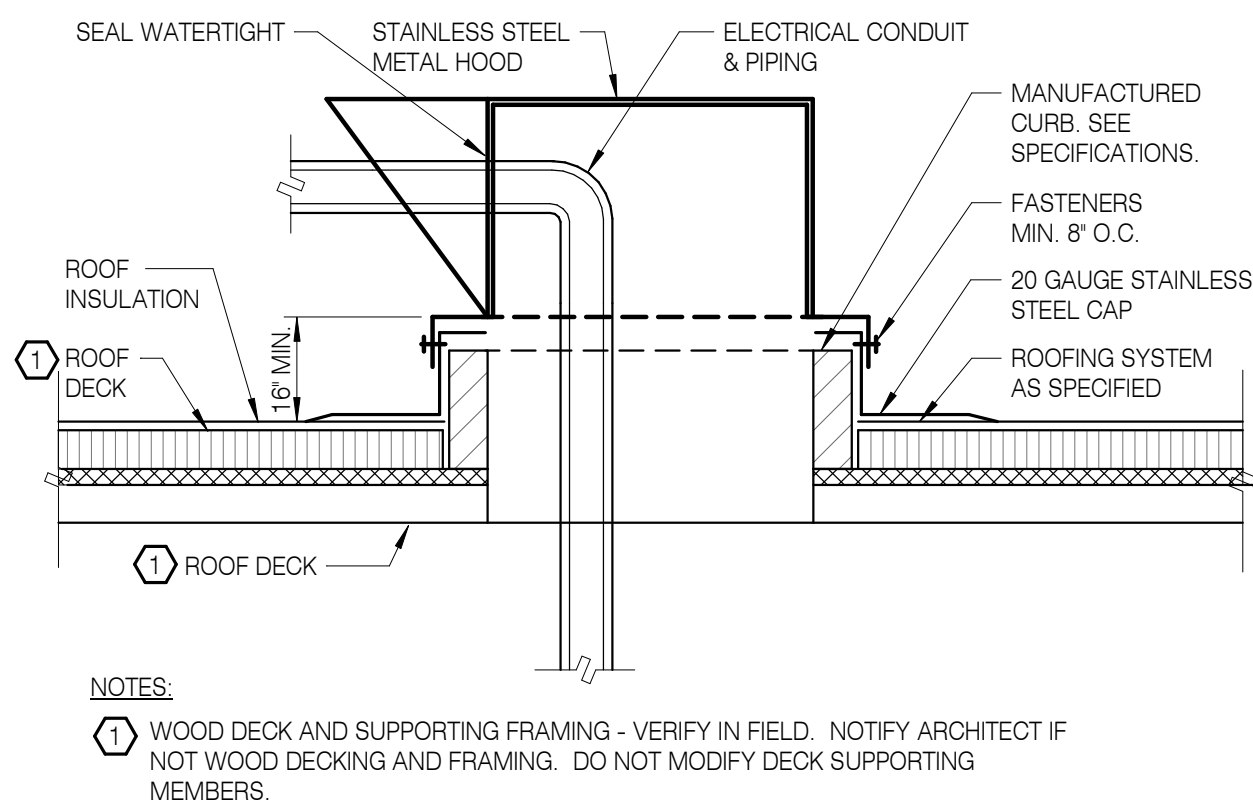

7 ROOF PIPING PENETRATION
NOT TO SCALE

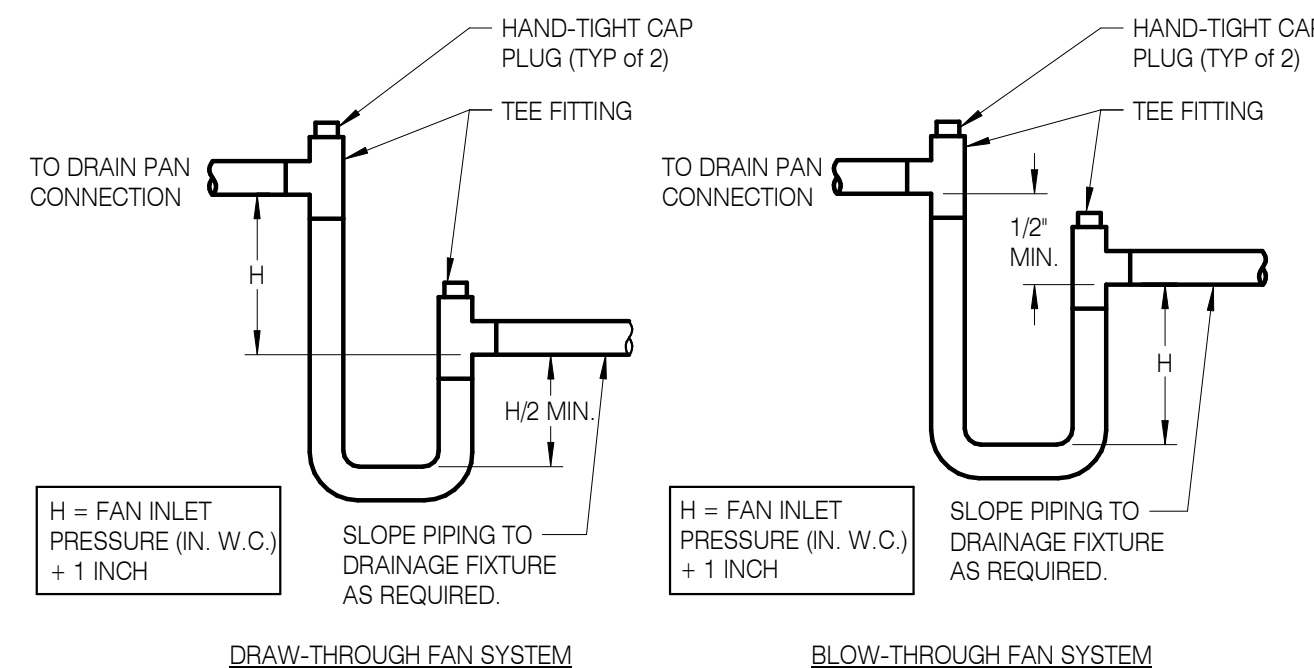

8 CONDENSATE DRAIN CONNECTION
NOT TO SCALE

RECORD DRAWING
NOTE: Documents have been corrected as per data supplied by Contractor and Revision / Change Order Drawings. They do not necessarily show all existing conditions and may not be completely accurate. Field verify existing / hidden conditions prior to commencement of new work.
DATE: AUGUST 20, 2020

SHEET TITLE:
DETAILS

REVISIONS:
DESCRP. DATE

ISSUE DATE: 08/20/2020

M531

VENTILATION CALCULATIONS FOR HEATING DESIGN CONT.

Table with columns: SYSTEM/ZONE, ROOM, Vpz, Vfan, Vdzt, Vpz-min, Voz-htg, Zd, Ep, Er, Fa, Fb, Fc, Evz. Rows include various rooms like 035 STORAGE, 029 HALL, 030 WET GEAR, etc.

VENTILATION CALCULATIONS FOR HEATING DESIGN CONT.

Table with columns: SYSTEM/ZONE, ROOM, Vpz, Vfan, Vdzt, Vpz-min, Voz-htg, Zd, Ep, Er, Fa, Fb, Fc, Evz. Rows include various rooms like 037 WORK ROOM, 020 STORAGE, 012 EATING AREA, etc.

RECORD DRAWING
NOTE: Documents have been corrected as per data supplied by Contractor and Revision / Change Order Drawings. They do not necessarily show all existing conditions and may not be completely accurate. Field verify existing / hidden conditions prior to commencement of new work.
DATE: AUGUST 20, 2020

RECORD DRAWING
20 AUGUST 2020




SHEET TITLE:
SCHEDULES


REVISIONS:
DESCRP. DATE

ISSUE DATE: 08/20/2020


M603

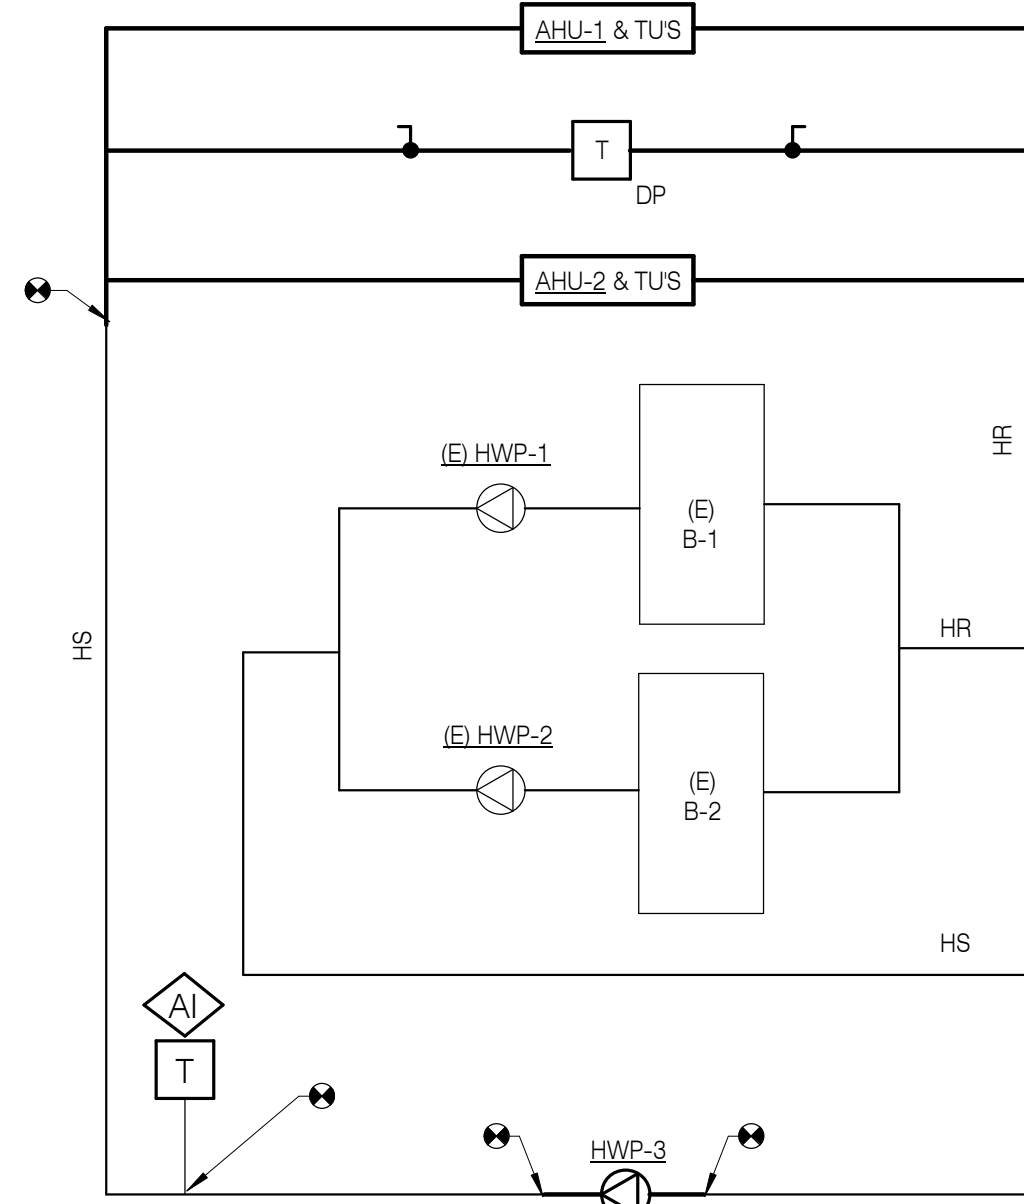


1 HEATING WATER SYSTEM
NOT TO SCALE

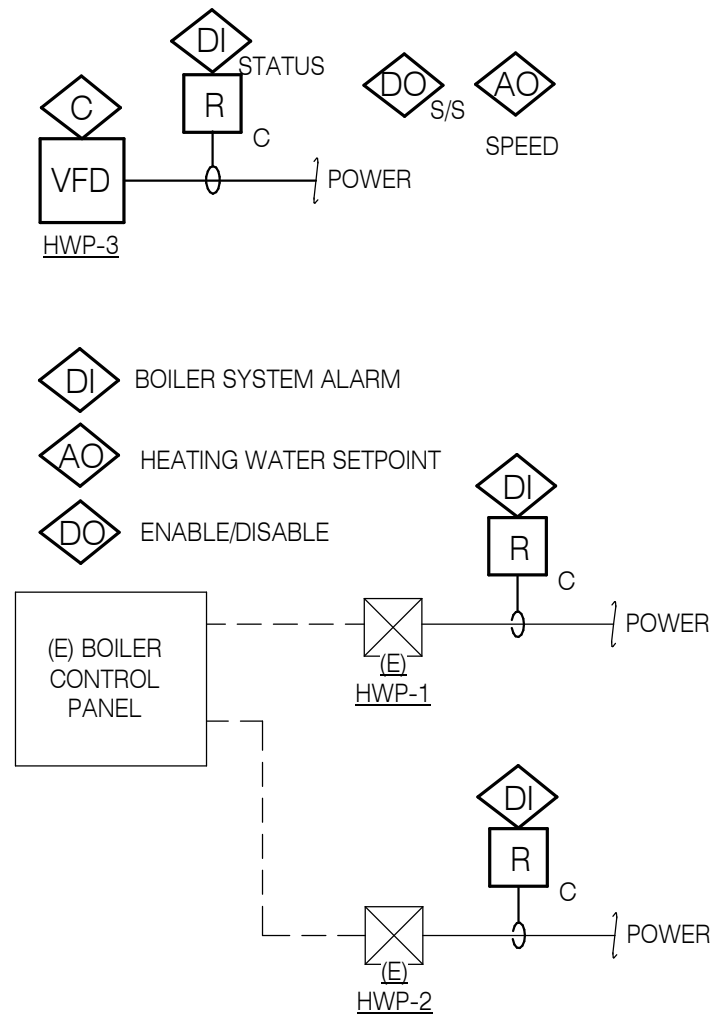


2 CHILLED WATER SYSTEM
NOT TO SCALE

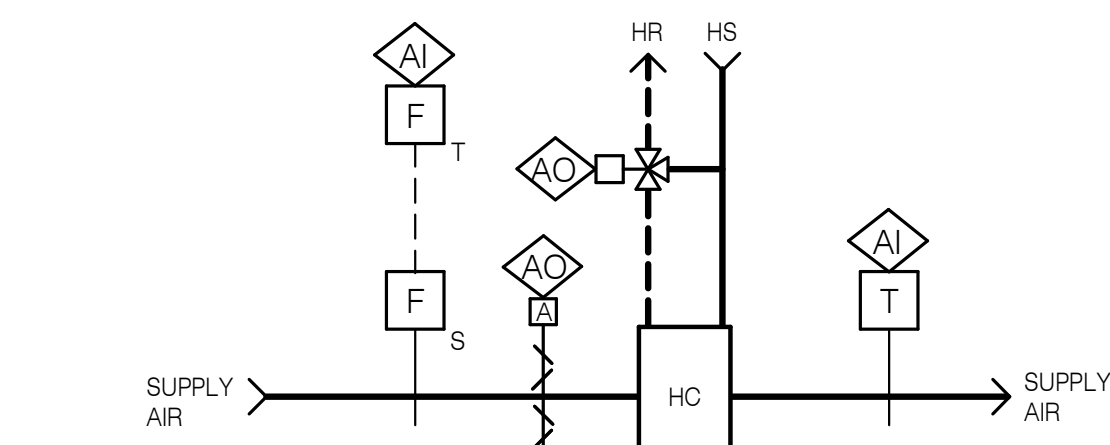

3 TERMINAL UNIT CONTROL
NOT TO SCALE

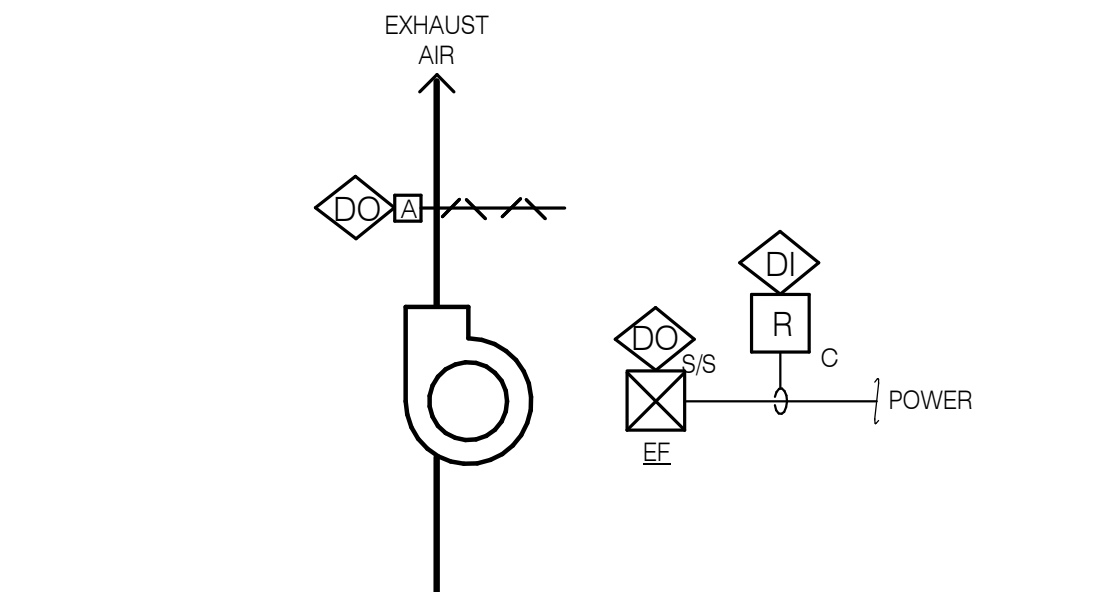


4 EXHAUST FAN CONTROL
NOT TO SCALE

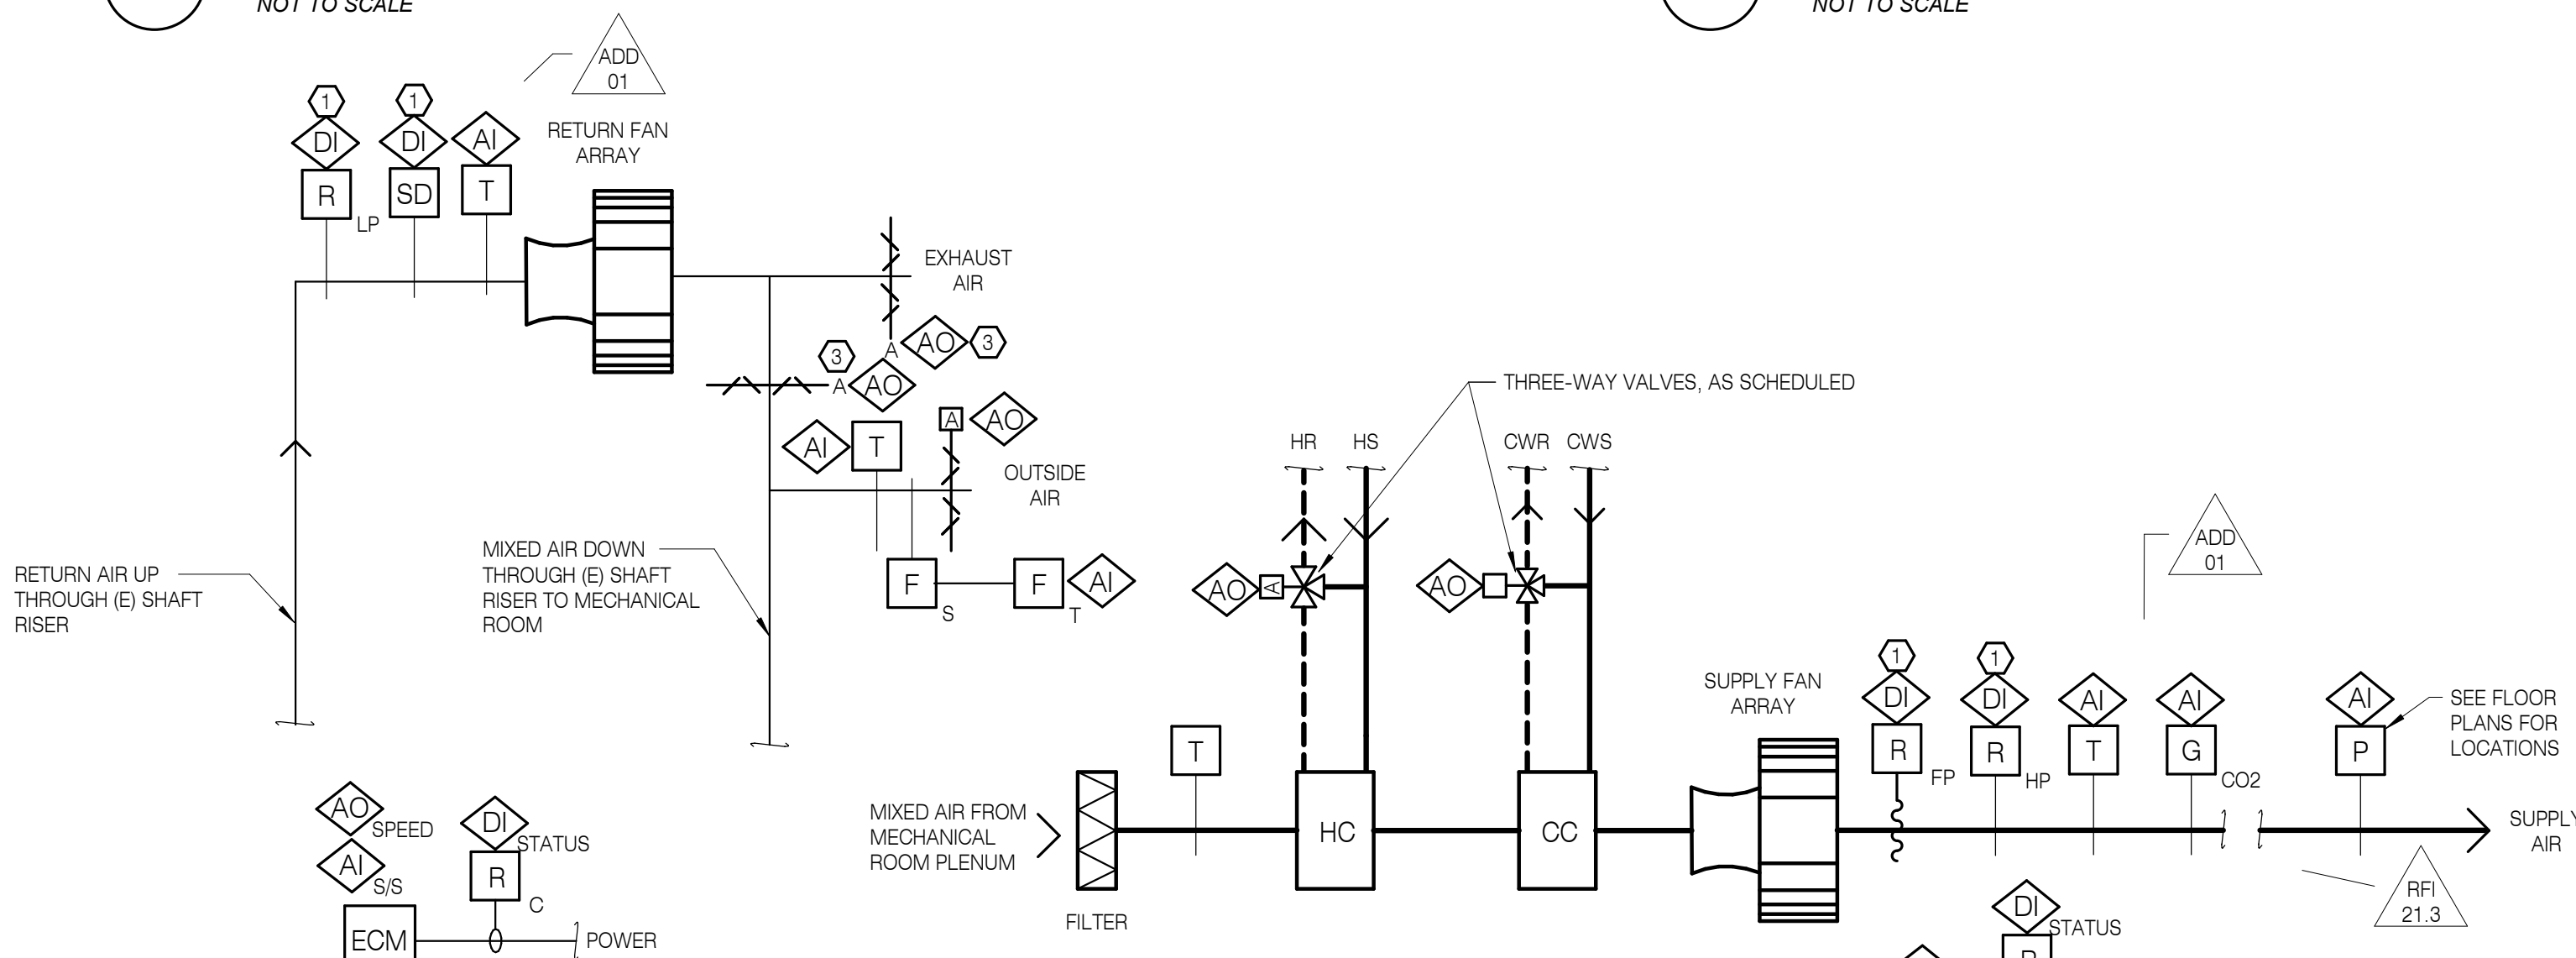

5 AHU-1 CONTROLS
NOT TO SCALE

- DETAIL NOTES:**
- ① HARDWIRE SMOKE DETECTOR TO FAN MOTOR CONTROL SAFETY SHUTDOWN BY DIVISION 28.
 - ② HARDWIRE SAFETY DEVICE TO FAN MOTOR CONTROL SAFETY SHUTDOWN.
 - ③ PROVIDE NEW ACTUATOR ON EXISTING DAMPER.

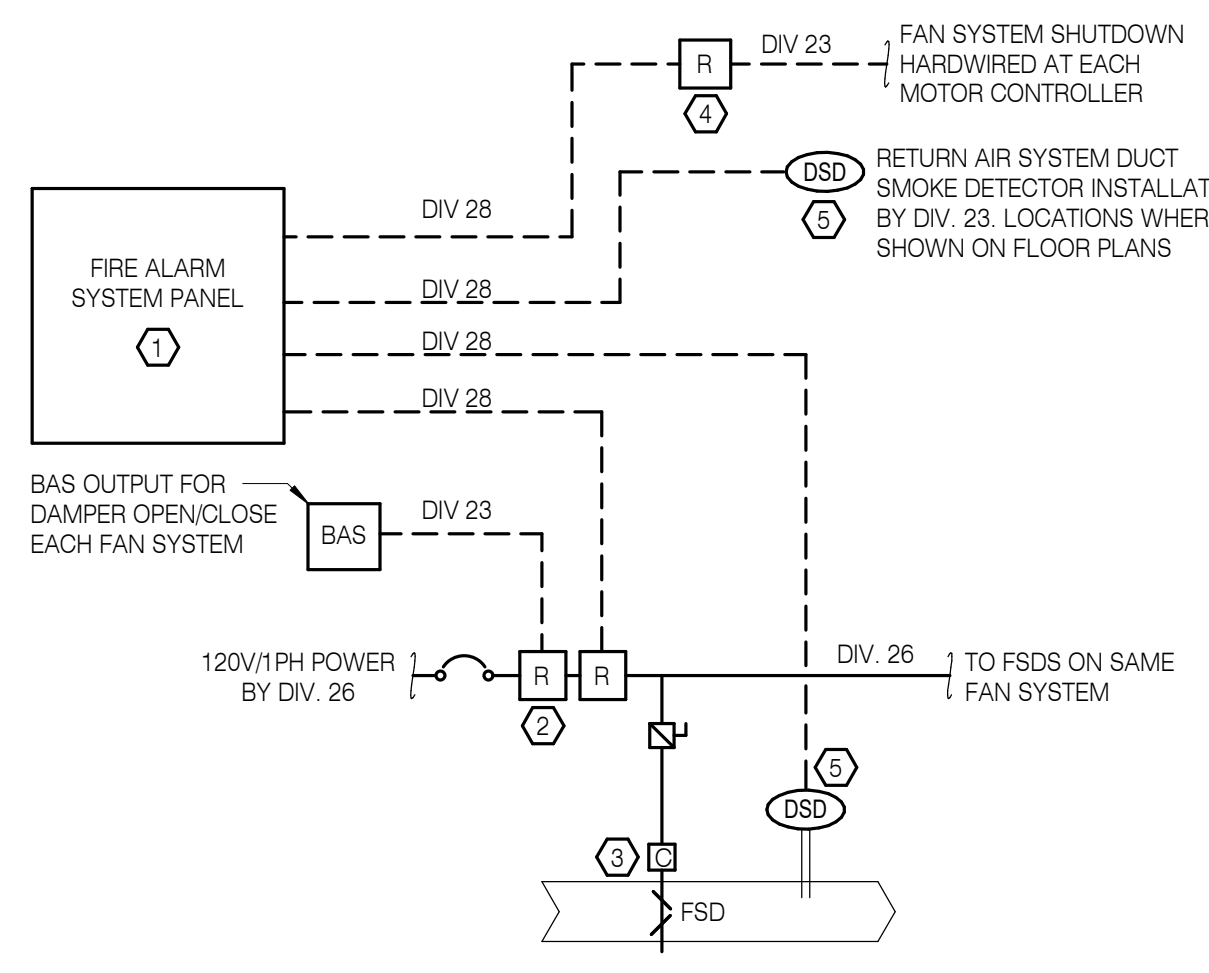

6 AIR HANDLER FIRE ALARM CONTROL
NOT TO SCALE

- ① MIN. OSA SETPOINT
- ② SUPPLY FAN STATIC PRESSURE SETPOINT
- ③ SUPPLY AIR TEMPERATURE SETPOINT
- ④ OCCUPANCY MODE


- GENERAL NOTES:**
1. REFER TO MECHANICAL AND ELECTRICAL FLOOR PLANS AND DETAILS FOR FIRE/SMOKE DAMPER AND DUCT SMOKE DETECTOR QUANTITIES AND LOCATIONS.
 2. CONTRACTOR SHALL COORDINATE DUCT SMOKE DETECTOR INSTALLATION AT EACH LOCATION PRIOR TO COMMENCING WORK. DIV. 23 SHALL INSTALL DUCT SMOKE DETECTORS, AND MODIFY DUCTWORK AS REQUIRED TO ACCOMMODATE DETECTOR INSTALLATION. PROVIDE ALL WORK TO SUIT INSTALLATION REQUIREMENTS AND ALL APPLICABLE CODES.
 3. REFER TO DIV. 28 FOR ALARM SEQUENCE OF OPERATIONS.

- REFERENCE NOTES:**
- ① REFER TO ELECTRICAL PLANS FOR FIRE ALARM PANEL LOCATION.
 - ② ADDRESSABLE FIRE ALARM CONTROL MODULES BY DIV. 28. INSTALL ADJACENT TO ELECTRICAL PANEL.
 - ③ FIRE SMOKE DAMPER PROVIDED BY DIV. 23. POWER ALL FIRE SMOKE DAMPERS FOR EACH FAN SYSTEM FROM SAME CIRCUIT.
 - ④ ADDRESSABLE FIRE ALARM CONTROL MODULE BY DIV. 28. INSTALL ADJACENT TO BAS PANEL.
 - ⑤ DUCT SMOKE DETECTOR FURNISHED & WIRED BY DIV. 28, INSTALLED BY DIV. 23.

RECORD DRAWING

NOTE: Documents have been corrected as per data supplied by Contractor and Revision / Change Order Drawings. They do not necessarily show all existing conditions and may not be completely accurate. Field verify existing / hidden conditions prior to commencement of new work.

DATE: AUGUST 20, 2020

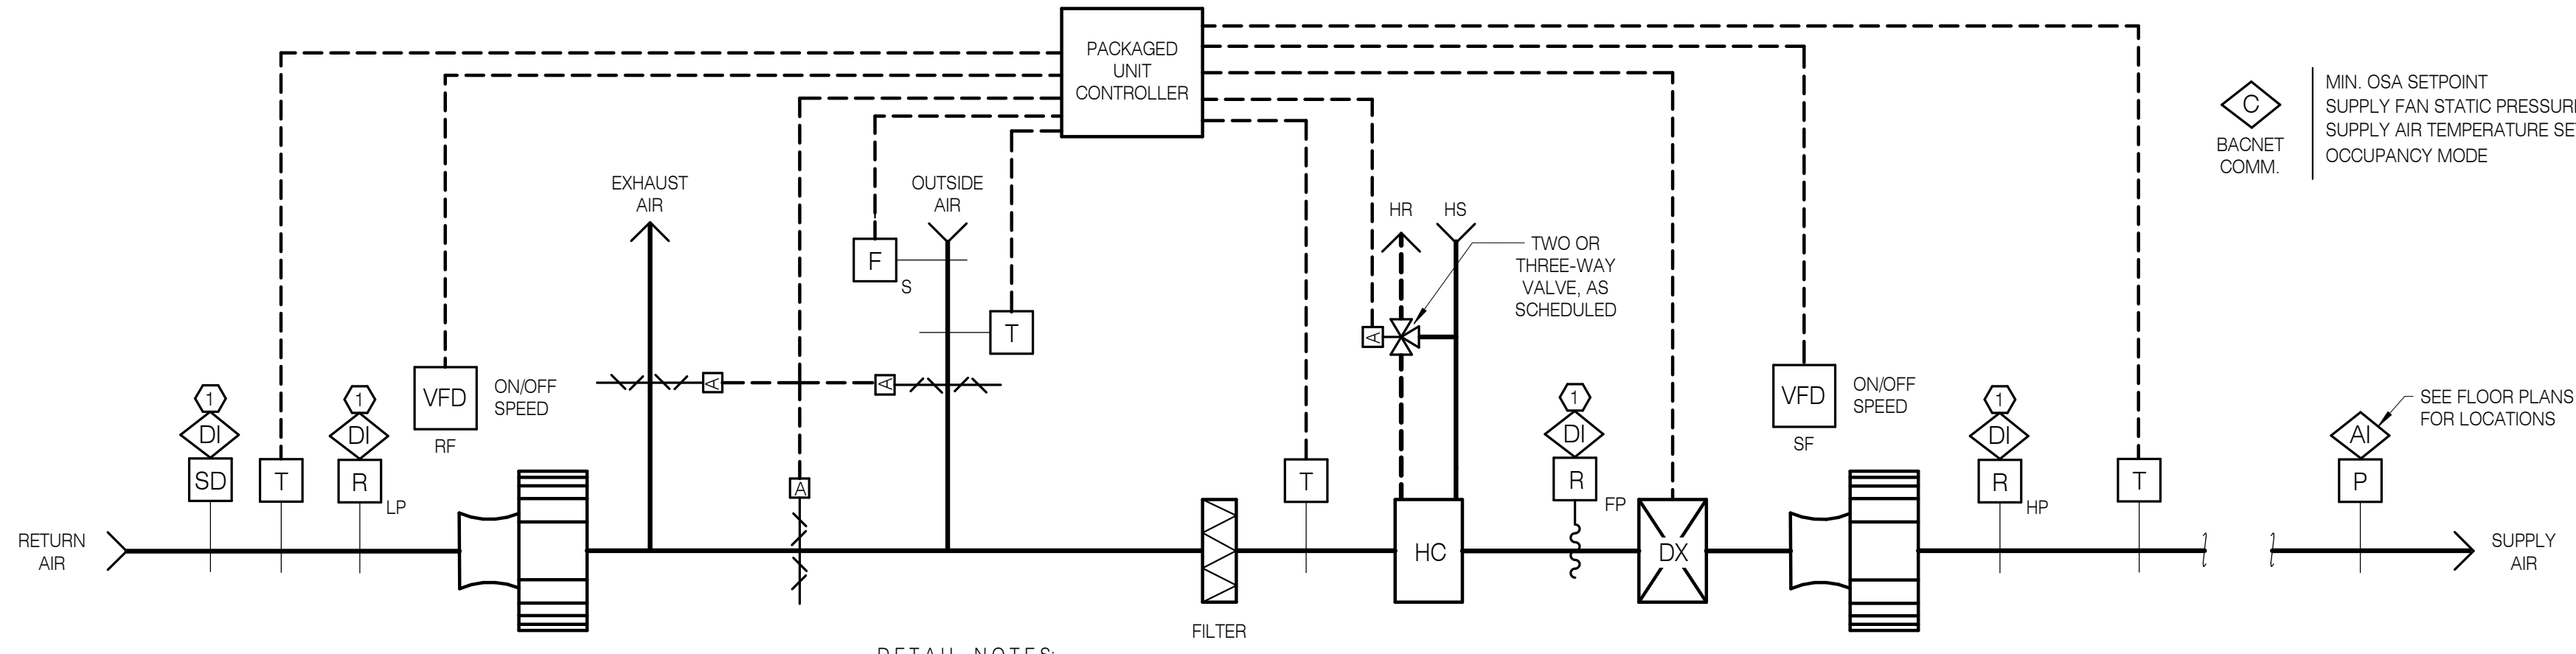


7 AHU-2 CONTROLS
NOT TO SCALE

- DETAIL NOTES:**
- ① HARDWIRE SMOKE DETECTOR TO FAN MOTOR CONTROL SAFETY SHUTDOWN BY DIVISION 28.
 - ② HARDWIRE SAFETY DEVICE TO FAN MOTOR CONTROL SAFETY SHUTDOWN.

REVISIONS:

#	DESCR.	DATE
1	ADD 01	05.17.19
7	RFI 21.3	08.21.19

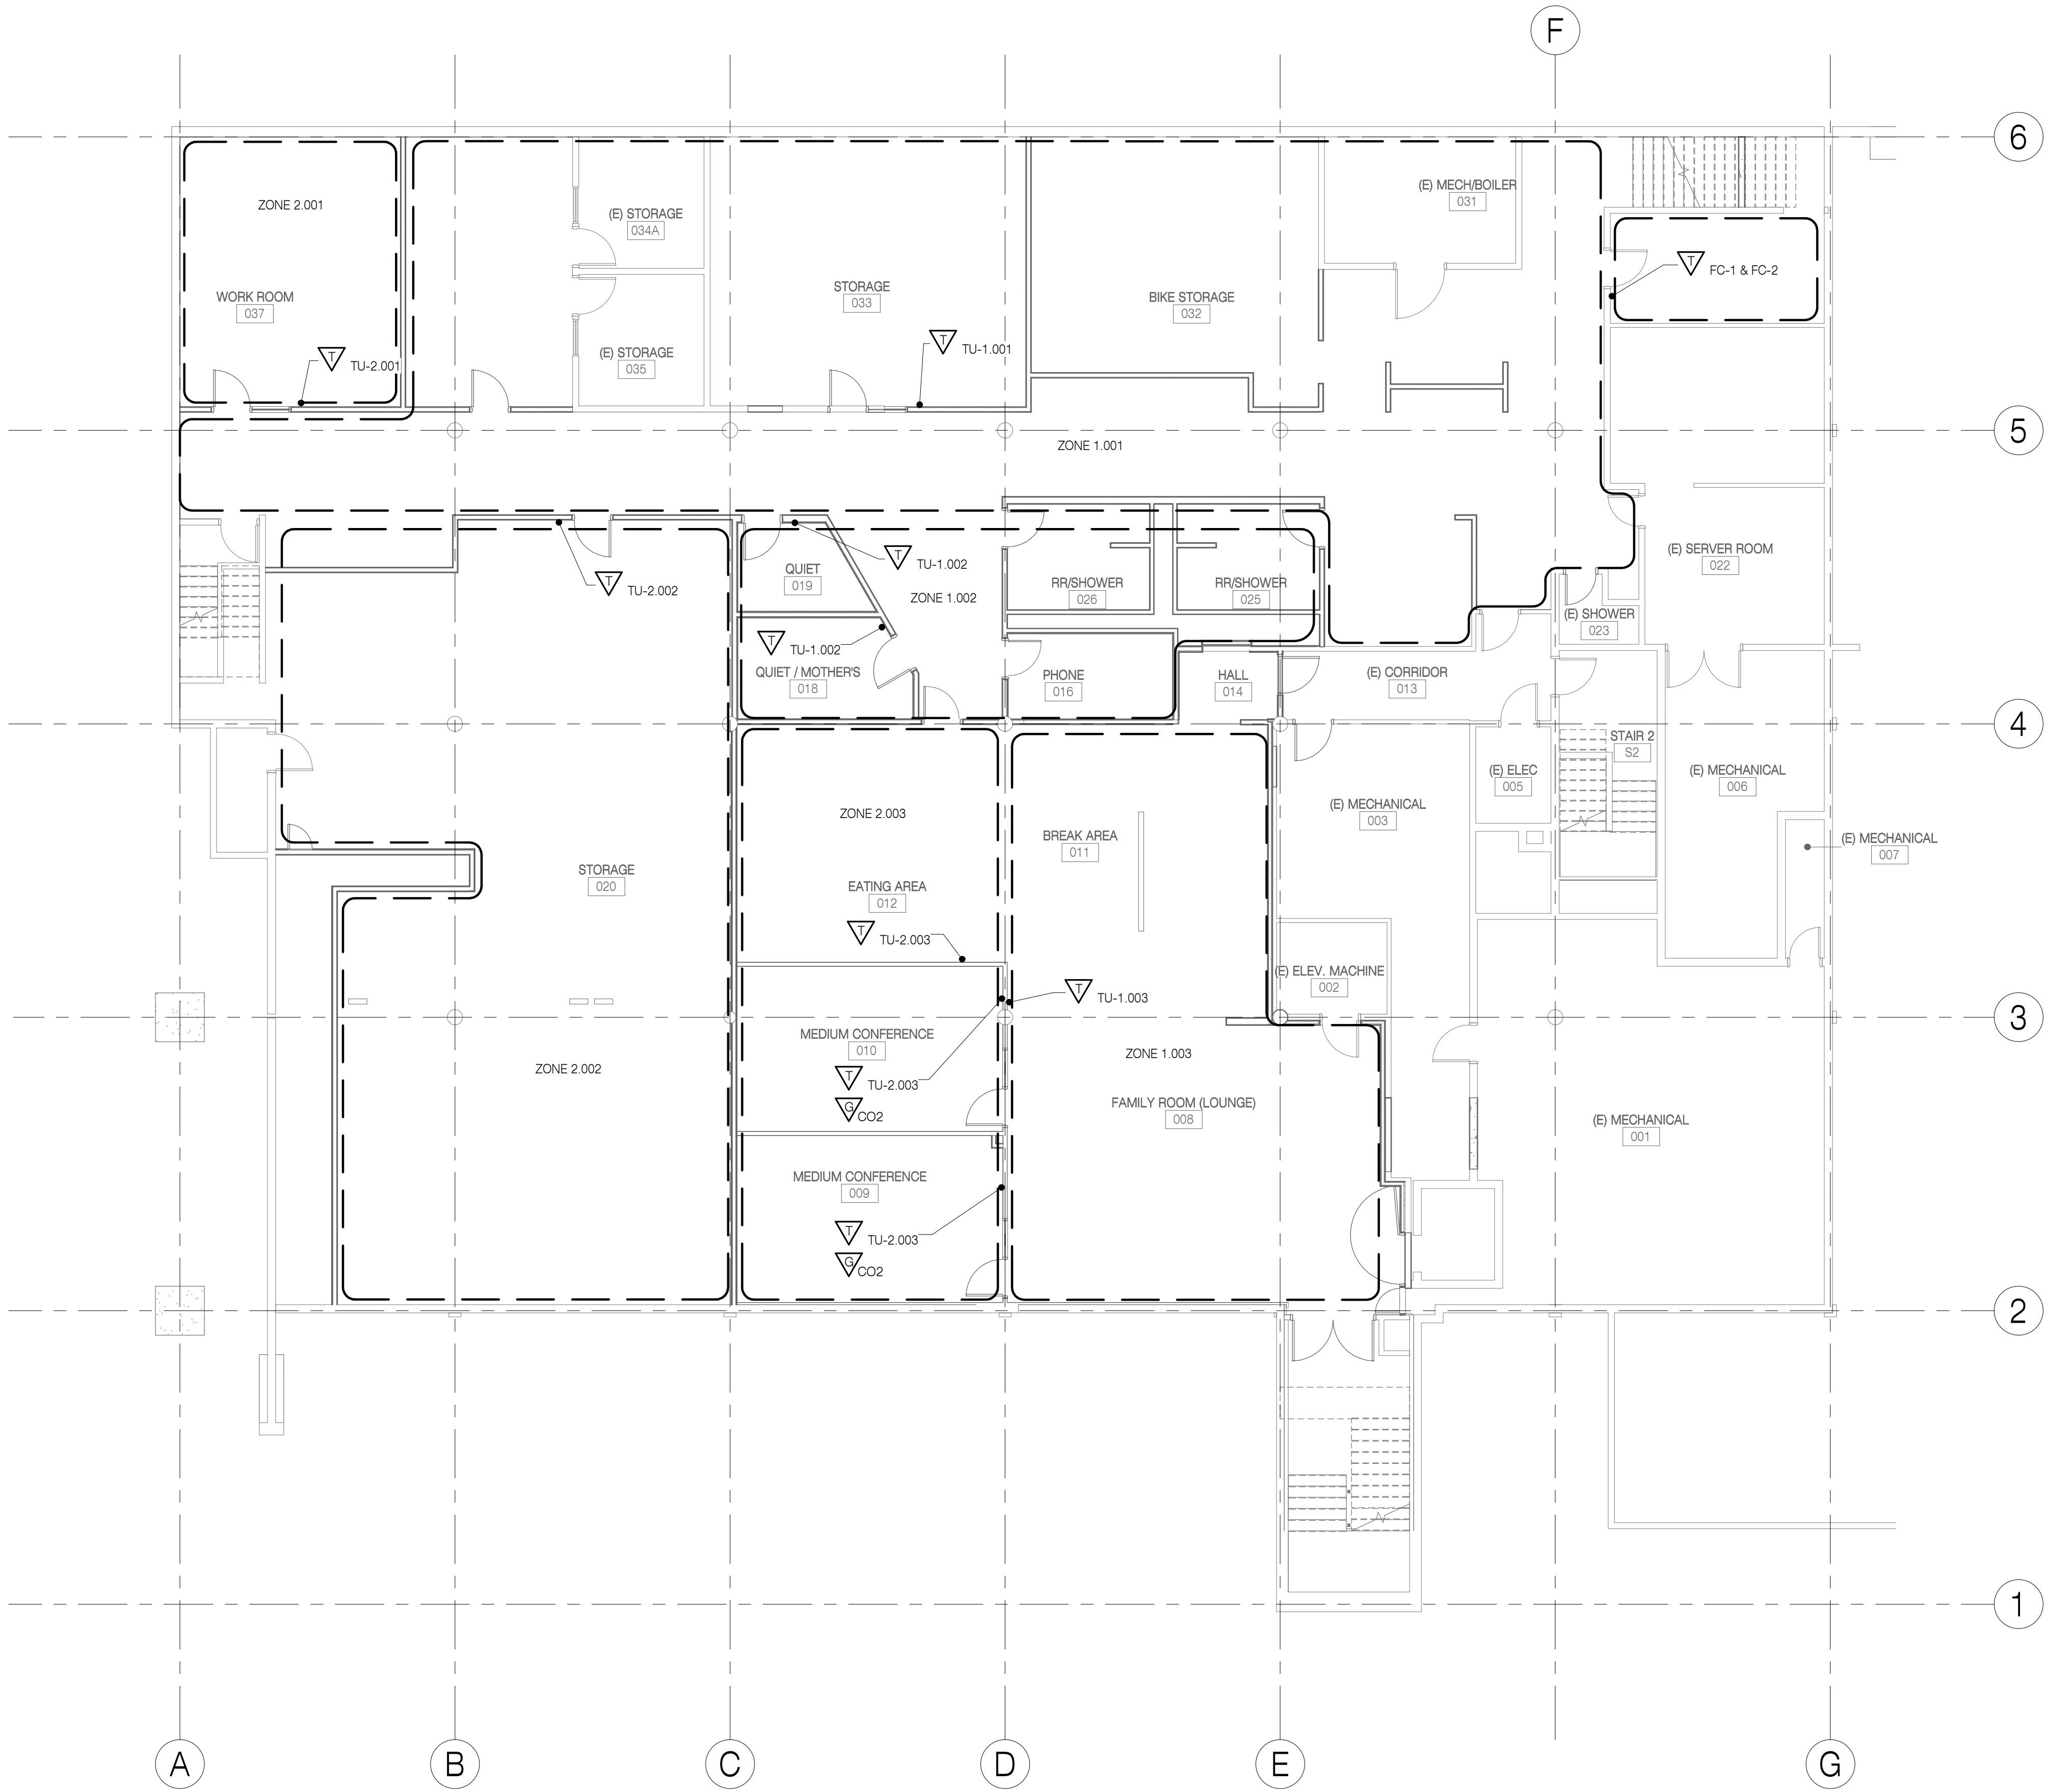


ZONE TAG DESCRIPTION (A.B.CC):


A = AIR HANDLER SYSTEM DESIGNATION (1 = AHU-1, 2 = AHU-2)
 B = FLOOR LEVEL (0 = BASEMENT, 1 = FIRST FLOOR, 2 = SECOND FLOOR)
 CC = SYSTEM ZONE SEQUENCE ON DESIGNATED FLOOR LEVEL

EXAMPLE: ZONE 2.001 = AHU-2, BASEMENT, FIRST AHU-2 ZONE ON BASEMENT LEVEL

RECORD DRAWING
 NOTE: Documents have been corrected as per data supplied by Contractor and Revision / Change Order Drawings. They do not necessarily show all existing conditions and may not be completely accurate. Field verify existing / hidden conditions prior to commencement of new work.
 DATE: AUGUST 20, 2020

1 ZONE MAP - LOWER LEVEL
 1/8" = 1'-0"

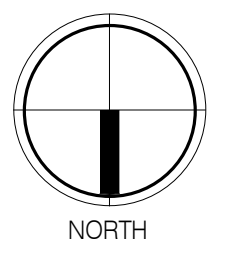

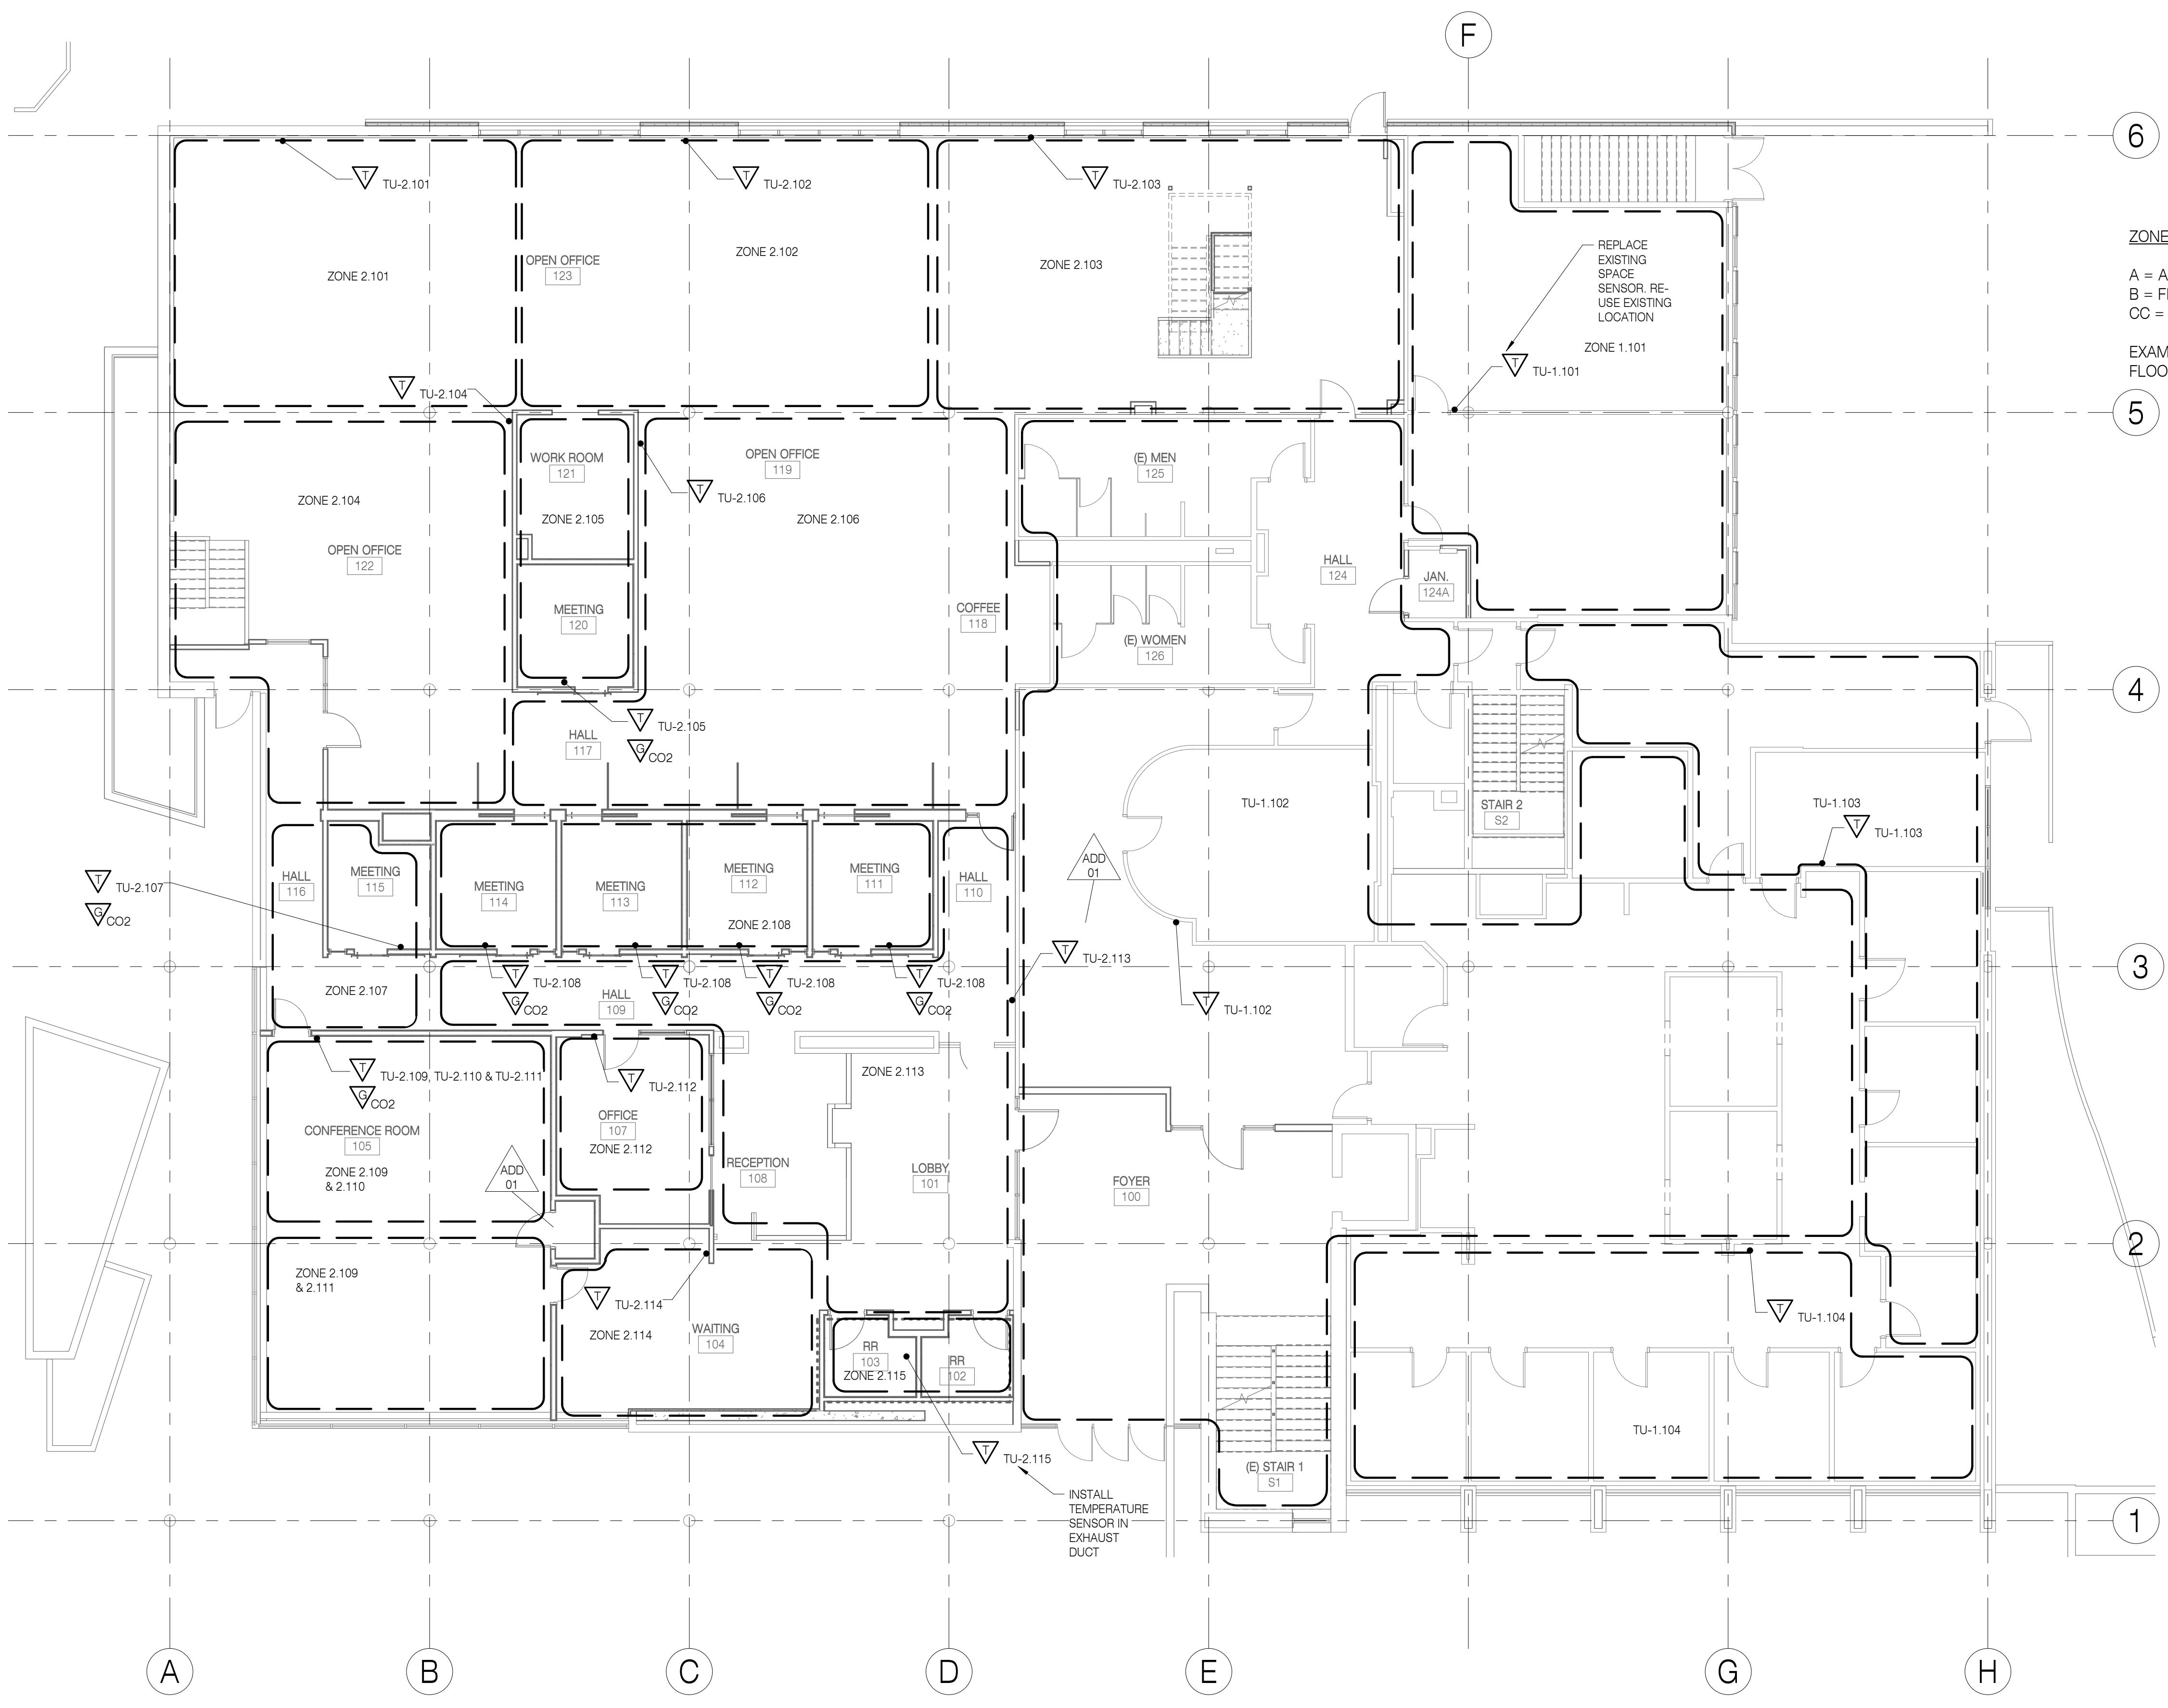


ZONE TAG DESCRIPTION (A.B.CC):
 A = AIR HANDLER SYSTEM DESIGNATION (1 = AHU-1, 2 = AHU-2)
 B = FLOOR LEVEL (0 = BASEMENT, 1 = FIRST FLOOR, 2 = SECOND FLOOR)
 CC = SYSTEM ZONE SEQUENCE ON DESIGNATED FLOOR LEVEL

EXAMPLE: ZONE 2.101 = AHU-2, FIRST FLOOR, FIRST AHU-2 ZONE ON FIRST FLOOR

RECORD DRAWING
 NOTE: Documents have been corrected as per data supplied by Contractor and Revision / Change Order Drawings. They do not necessarily show all existing conditions and may not be completely accurate. Field verify existing / hidden conditions prior to commencement of new work.
 DATE: AUGUST 20, 2020

1 ZONE MAP - FIRST FLOOR
 1/8" = 1'-0"

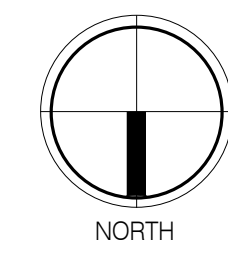

REVISIONS:

#	DESCRP.	DATE
1	ADD 01	05.17.19
11	PR 06	12.03.19



ZONE TAG DESCRIPTION (A.BCC):
 A = AIR HANDLER SYSTEM DESIGNATION (1 = AHU-1, 2 = AHU-2)
 B = FLOOR LEVEL (0 = BASEMENT, 1 = FIRST FLOOR, 2 = SECOND FLOOR)
 CC = SYSTEM ZONE SEQUENCE ON DESIGNATED FLOOR LEVEL

EXAMPLE: ZONE 1.201 = AHU-1, SECOND FLOOR, FIRST AHU-1 ZONE ON SECOND FLOOR

RECORD DRAWING
 NOTE: Documents have been corrected as per data supplied by Contractor and Revision / Change Order Drawings. They do not necessarily show all existing conditions and may not be completely accurate. Field verify existing / hidden conditions prior to commencement of new work.
 DATE: AUGUST 20, 2020

PIVOT
 ARCHITECTURE

RECORD DRAWING
 20 AUGUST 2020

SW E
 SYSTEMS WEST ENGINEERS
 725 A Street
 Springfield, OR 97477
 541.342.7210
 systemswestengineers.com
 SWE Proj. No. U003.08

RECORD DRAWINGS
HOMES FOR GOOD OFFICE BUILDING
REMODEL
 100 WEST 30TH AVENUE
 EUGENE, OR 97401

SHEET TITLE:
ZONE MAP - SECOND FLOOR

REVISIONS:

#	DESCRP.	DATE
1	ADD 01	05.17.19

ISSUE DATE: 08/20/2020

M703

1 ZONE MAP - SECOND FLOOR
 1/8" = 1'-0"

PLUMBING LEGEND

PIPING

SYMBOL	ABBREV.	DESCRIPTION	SYMBOL	ABBREV.	DESCRIPTION
FIRE PROTECTION PIPING:					
	F	FIRE SPRINKLER SUPPLY			
PLUMBING PIPING:					
	CW	POTABLE COLD WATER		HW	POTABLE HOT WATER
	HWR	POTABLE HOT WATER RETURN		NP	NON-POTABLE COLD WATER
	W	SANITARY WASTE		PW	PUMPED WASTE
	GW	GREASE WASTE		V	VENT
	D	DRAIN		SD	STORM DRAIN
	OD	OVERFLOW DRAIN		PSW	PUMPED STORM WATER
FUEL PIPING:					
	G	NATURAL GAS			
SITE PIPING (REFERENCE)					
	W	WATER SERVICE			
	I	IRRIGATION			
	RV	RELIEF VALVE		TPS	TEMPERATURE/PRESSURE SAFETY VALVE
		SENSOR WELL			
		THERMOMETER			
		PRESSURE GAUGE			
		TEST PLUG			
		METER, SELF-CONTAINED			
	FMS	FLOW MEASURING STATION			
	COG, FOO	CLEANOUT TO GRADE, FLOOR CLEANOUT			
	WCO	WALL CLEANOUT			
	FD	FLOOR DRAIN			
	HB	HOSE BIBB			
	RP	REDUCED PRESSURE BACKFLOW PREVENTER			
	DC	DOUBLE CHECK BACKFLOW PREVENTER			
		WATER HAMMER ARRESTOR			

GENERAL

SYMBOL	ABBREVIATION	DESCRIPTION
	EXISTING DIAMETER	EXISTING DIAMETER
	NEW TO EXISTING POINT OF CONNECTION	NEW TO EXISTING POINT OF CONNECTION
	NOTE REFERENCE MARKER	NOTE REFERENCE MARKER
	PLAN OR DETAIL REFERENCE MARKER	PLAN OR DETAIL REFERENCE MARKER
	SECTION REFERENCE MARKER	SECTION REFERENCE MARKER
	EQUIPMENT MARKER	EQUIPMENT MARKER
	ROOM NUMBER	ROOM NUMBER
	EXISTING SHOWN LIGHT	EXISTING SHOWN LIGHT
	NEW WORK SHOWN BOLD	NEW WORK SHOWN BOLD
	EXISTING TO BE REMOVED	EXISTING TO BE REMOVED

ABBREVIATIONS

ABBREVIATION	DESCRIPTION	ABBREVIATION	DESCRIPTION
ACH	AIR CHANGES PER HOUR	IN WC	INCHES WATER COLUMN
AFF	ABOVE FINISHED FLOOR	IPLV	INTEGRATED PART LOAD VALUE
AFS	AUTOMATIC FIRE SPRINKLER	IW	INDIRECT WASTE
AL	ALUMINUM	LBS	POUNDS
ALT	ALTERNATE	LWT	LEAVING WATER TEMPERATURE
BAS	BUILDING AUTOMATION SYSTEM	Ma	MILLIAMPERE
BHP	BRAKE HORSEPOWER	MAX	MAXIMUM
BOP	BOTTOM OF PIPE	MBH	THOUSAND BTUs per HOUR
BTUH	BRITISH THERMAL UNITS PER HOUR	MCA	MINIMUM CIRCUIT AMPS
CFH	CUBIC FEET per HOUR	MFG	MANUFACTURER
CFM	CUBIC FEET per MINUTE	MIN	MINIMUM
CMU	CONCRETE MASONRY UNIT	MOP	MAX. OVERCURRENT PROTECTION
CONC	CONCRETE	NC	NOISE CRITERIA
CONT	CONTINUATION	NC	NORMALLY CLOSED
DB	DRY BULB	NIC	NOT IN CONTRACT
Dba	DECIBELS ACOUSTIC	NO	NORMALLY OPEN
DN	DOWN	NPLV	NON-STANDARD PART LOAD VALUE
DP	DIFFERENTIAL PRESSURE	NPSH	NET POSITIVE SUCTION HEAD
EFF	EFFICIENCY	OFCI	OWNER FURNISHED/CONTRACTOR INSTALLED
EVT	ENTERING WATER TEMPERATURE	PD	PRESSURE DROP
FLA	FULL LOAD AMPS	PH	PHASE
FPM	FEET PER MINUTE	PPH	POUNDS per HOUR
FT	FEET	PSI	POUNDS per SQUARE INCH GAUGE
FT WC	FEET WATER COLUMN	RD	ROOF DRAIN
FUT	FUTURE	REQD	REQUIRED
GPH	GALLONS PER HOUR	RH	RELATIVE HUMIDITY
GPM	GALLONS PER MINUTE	RP	REVOLUTIONS per MINUTE
GYP BD	GYPSONUM WALL BOARD	SS	STAINLESS STEEL
HP	HORSEPOWER	STL	STEEL
HVAC	HEATING, VENTILATING, & AIR CONDITIONING	TYP	TYPICAL
HZ	HERTZ (CYCLES PER SECOND)	VFD	VARIABLE FREQUENCY DRIVE
IAQ	INDOOR AIR QUALITY	WB	WET BULB
IE	INVERT ELEVATION	WC	WATER COLUMN
IN	INCHES	WG	WATER GAUGE


GENERAL NOTES

1. THE CLINIC PORTION OF THE FACILITY WILL REMAIN IN OPERATION DURING CONSTRUCTION. COORDINATE ALL SHUTDOWNS AND CONSTRUCTION ACTIVITY WITH FACILITIES STAFF.
2. SIZE AND LOCATION OF ALL PIPING AND OTHER MECHANICAL EQUIPMENT IS APPROXIMATE. CONTRACTOR SHALL SITE VERIFY THE EXACT LOCATION OF EXISTING AND CONSTRUCT ALL WORK FROM FIELD DIMENSIONS. CONTRACTOR SHALL MAKE ADJUSTMENTS NECESSARY TO ACCOMMODATE MINOR DEVIATIONS AT NO COST TO OWNER.
3. FINE (LIGHT) LINE WORK INDICATES EXISTING PIPING AND OTHER MECHANICAL EQUIPMENT. BOLD (HEAVY) LINE WORK INDICATES NEW PIPING AND OTHER MECHANICAL EQUIPMENT.
4. IT IS RESPONSIBILITY OF THE CONTRACTOR TO PROVIDE CUTTING AND PATCHING TO ALLOW THE INSTALLATION OF MATERIALS AND EQUIPMENT AS SPECIFIED AND SHOWN ON DRAWINGS.


SHEET INDEX - PLUMBING

P001	LEGEND, GENERAL NOTES & PLUMBING SHEET INDEX
P101	PLUMBING DEMOLITION PLAN - LOWER LEVEL
P102	PLUMBING DEMOLITION PLAN - FIRST FLOOR
P103	PLUMBING DEMOLITION PLAN - SECOND FLOOR
P111	PLUMBING PLAN - LOWER LEVEL
P112	PLUMBING PLAN - FIRST FLOOR
P113	PLUMBING PLAN - SECOND FLOOR
P501	PLUMBING DETAILS
P601	PLUMBING SCHEDULES

RECORD DRAWING
 NOTE: Documents have been corrected as per data supplied by Contractor and Revision / Change Order Drawings. They do not necessarily show all existing conditions and may not be completely accurate. Field verify existing / hidden conditions prior to commencement of new work.
 DATE: AUGUST 20, 2020

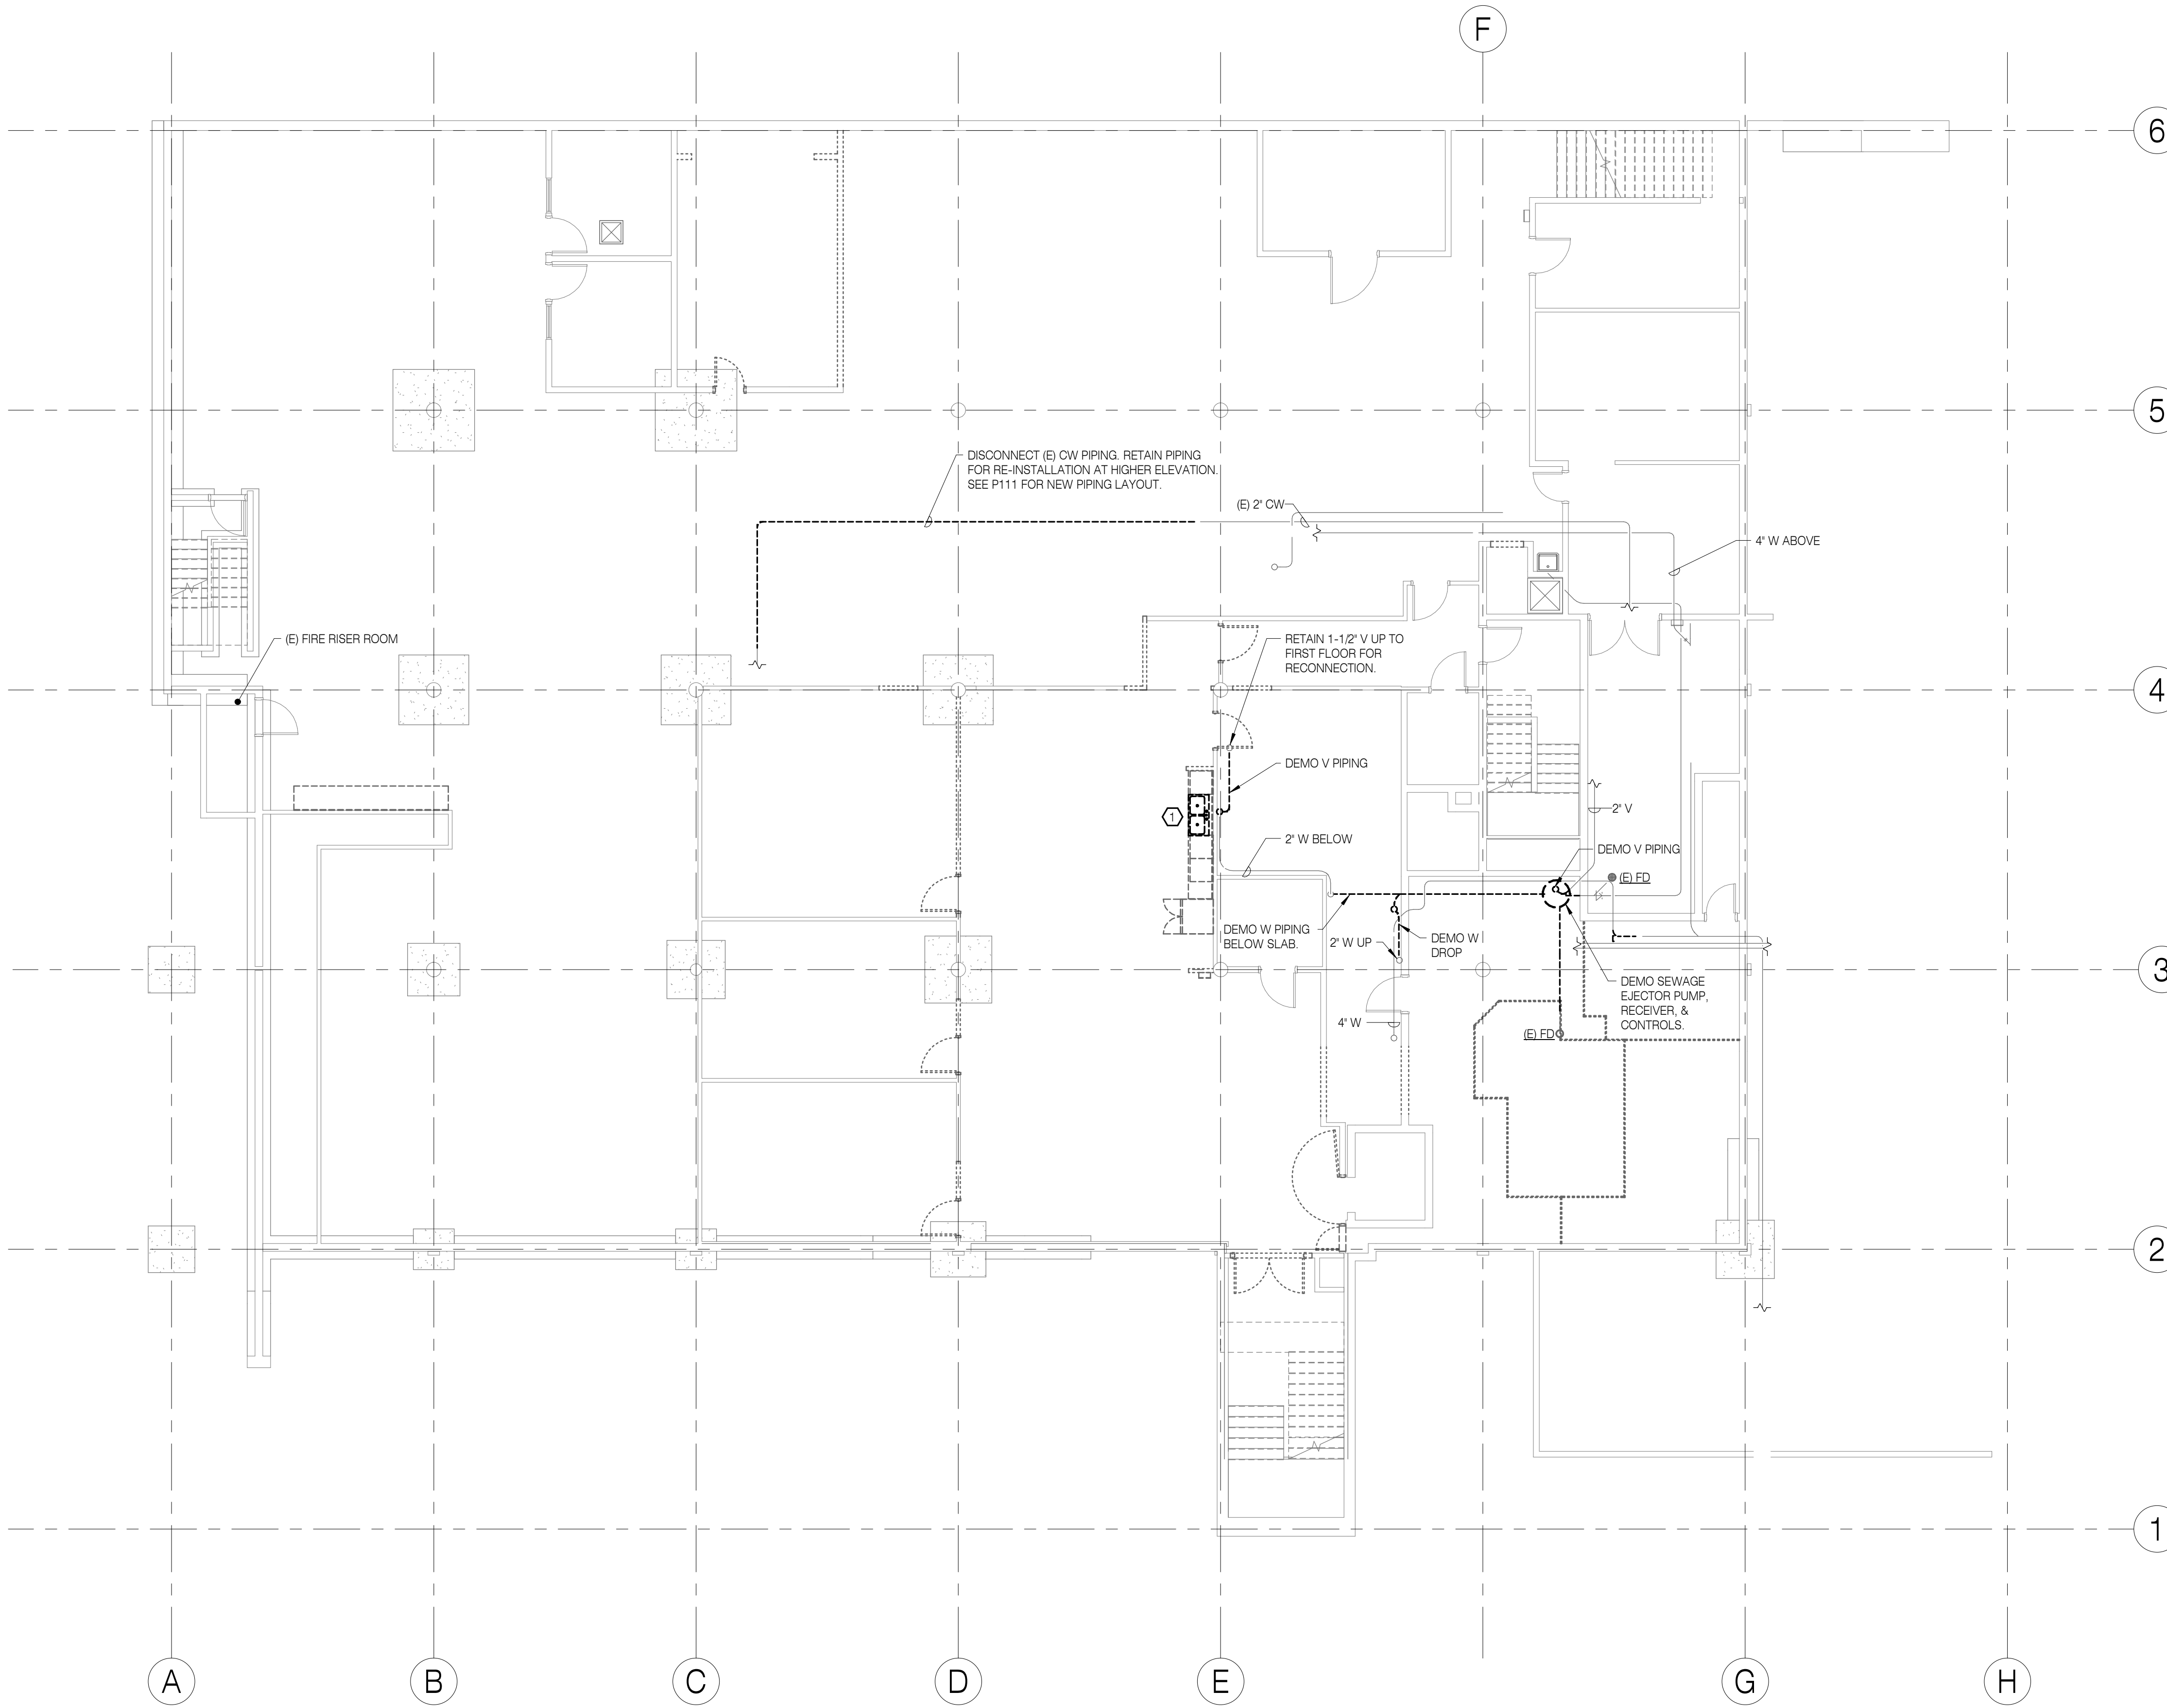

REFERENCE NOTES:
 ① DEMOLISH SINK & ASSOCIATED COOLING UNIT IN ADJACENT MECHANICAL SPACE. RETAIN CW, HW, & W PIPING FOR RECONNECTION.

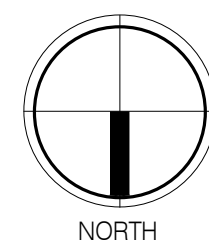

1 PLUMBING DEMOLITION PLAN - LOWER LEVEL
 1/8" = 1'-0"

RECORD DRAWING
 NOTE: Documents have been corrected as per data supplied by Contractor and Revision / Change Order Drawings. They do not necessarily show all existing conditions and may not be completely accurate. Field verify existing / hidden conditions prior to commencement of new work.
 DATE: AUGUST 20, 2020

REVISIONS:

#	DESCRP.	DATE

ISSUE DATE: 08/20/2020



REFERENCE NOTES:

- ① DEMOLISH (E) SINK. RETAIN (E) CW, HW, V, & W PIPING FOR RECONNECTION.
- ② DEMOLISH (E) DRINKING FOUNTAIN. RETAIN (E) CW, V, & W PIPING FOR RECONNECTION.




1 PLUMBING DEMOLITION PLAN - FIRST FLOOR
1/8" = 1'-0"

RECORD DRAWING
NOTE: Documents have been corrected as per data supplied by Contractor and Revision / Change Order Drawings. They do not necessarily show all existing conditions and may not be completely accurate. Field verify existing / hidden conditions prior to commencement of new work.
DATE: AUGUST 20, 2020

SHEET TITLE:
PLUMBING DEMOLITION PLAN - FIRST FLOOR

REVISIONS:
DESCRP. DATE

ISSUE DATE: 08/20/2020

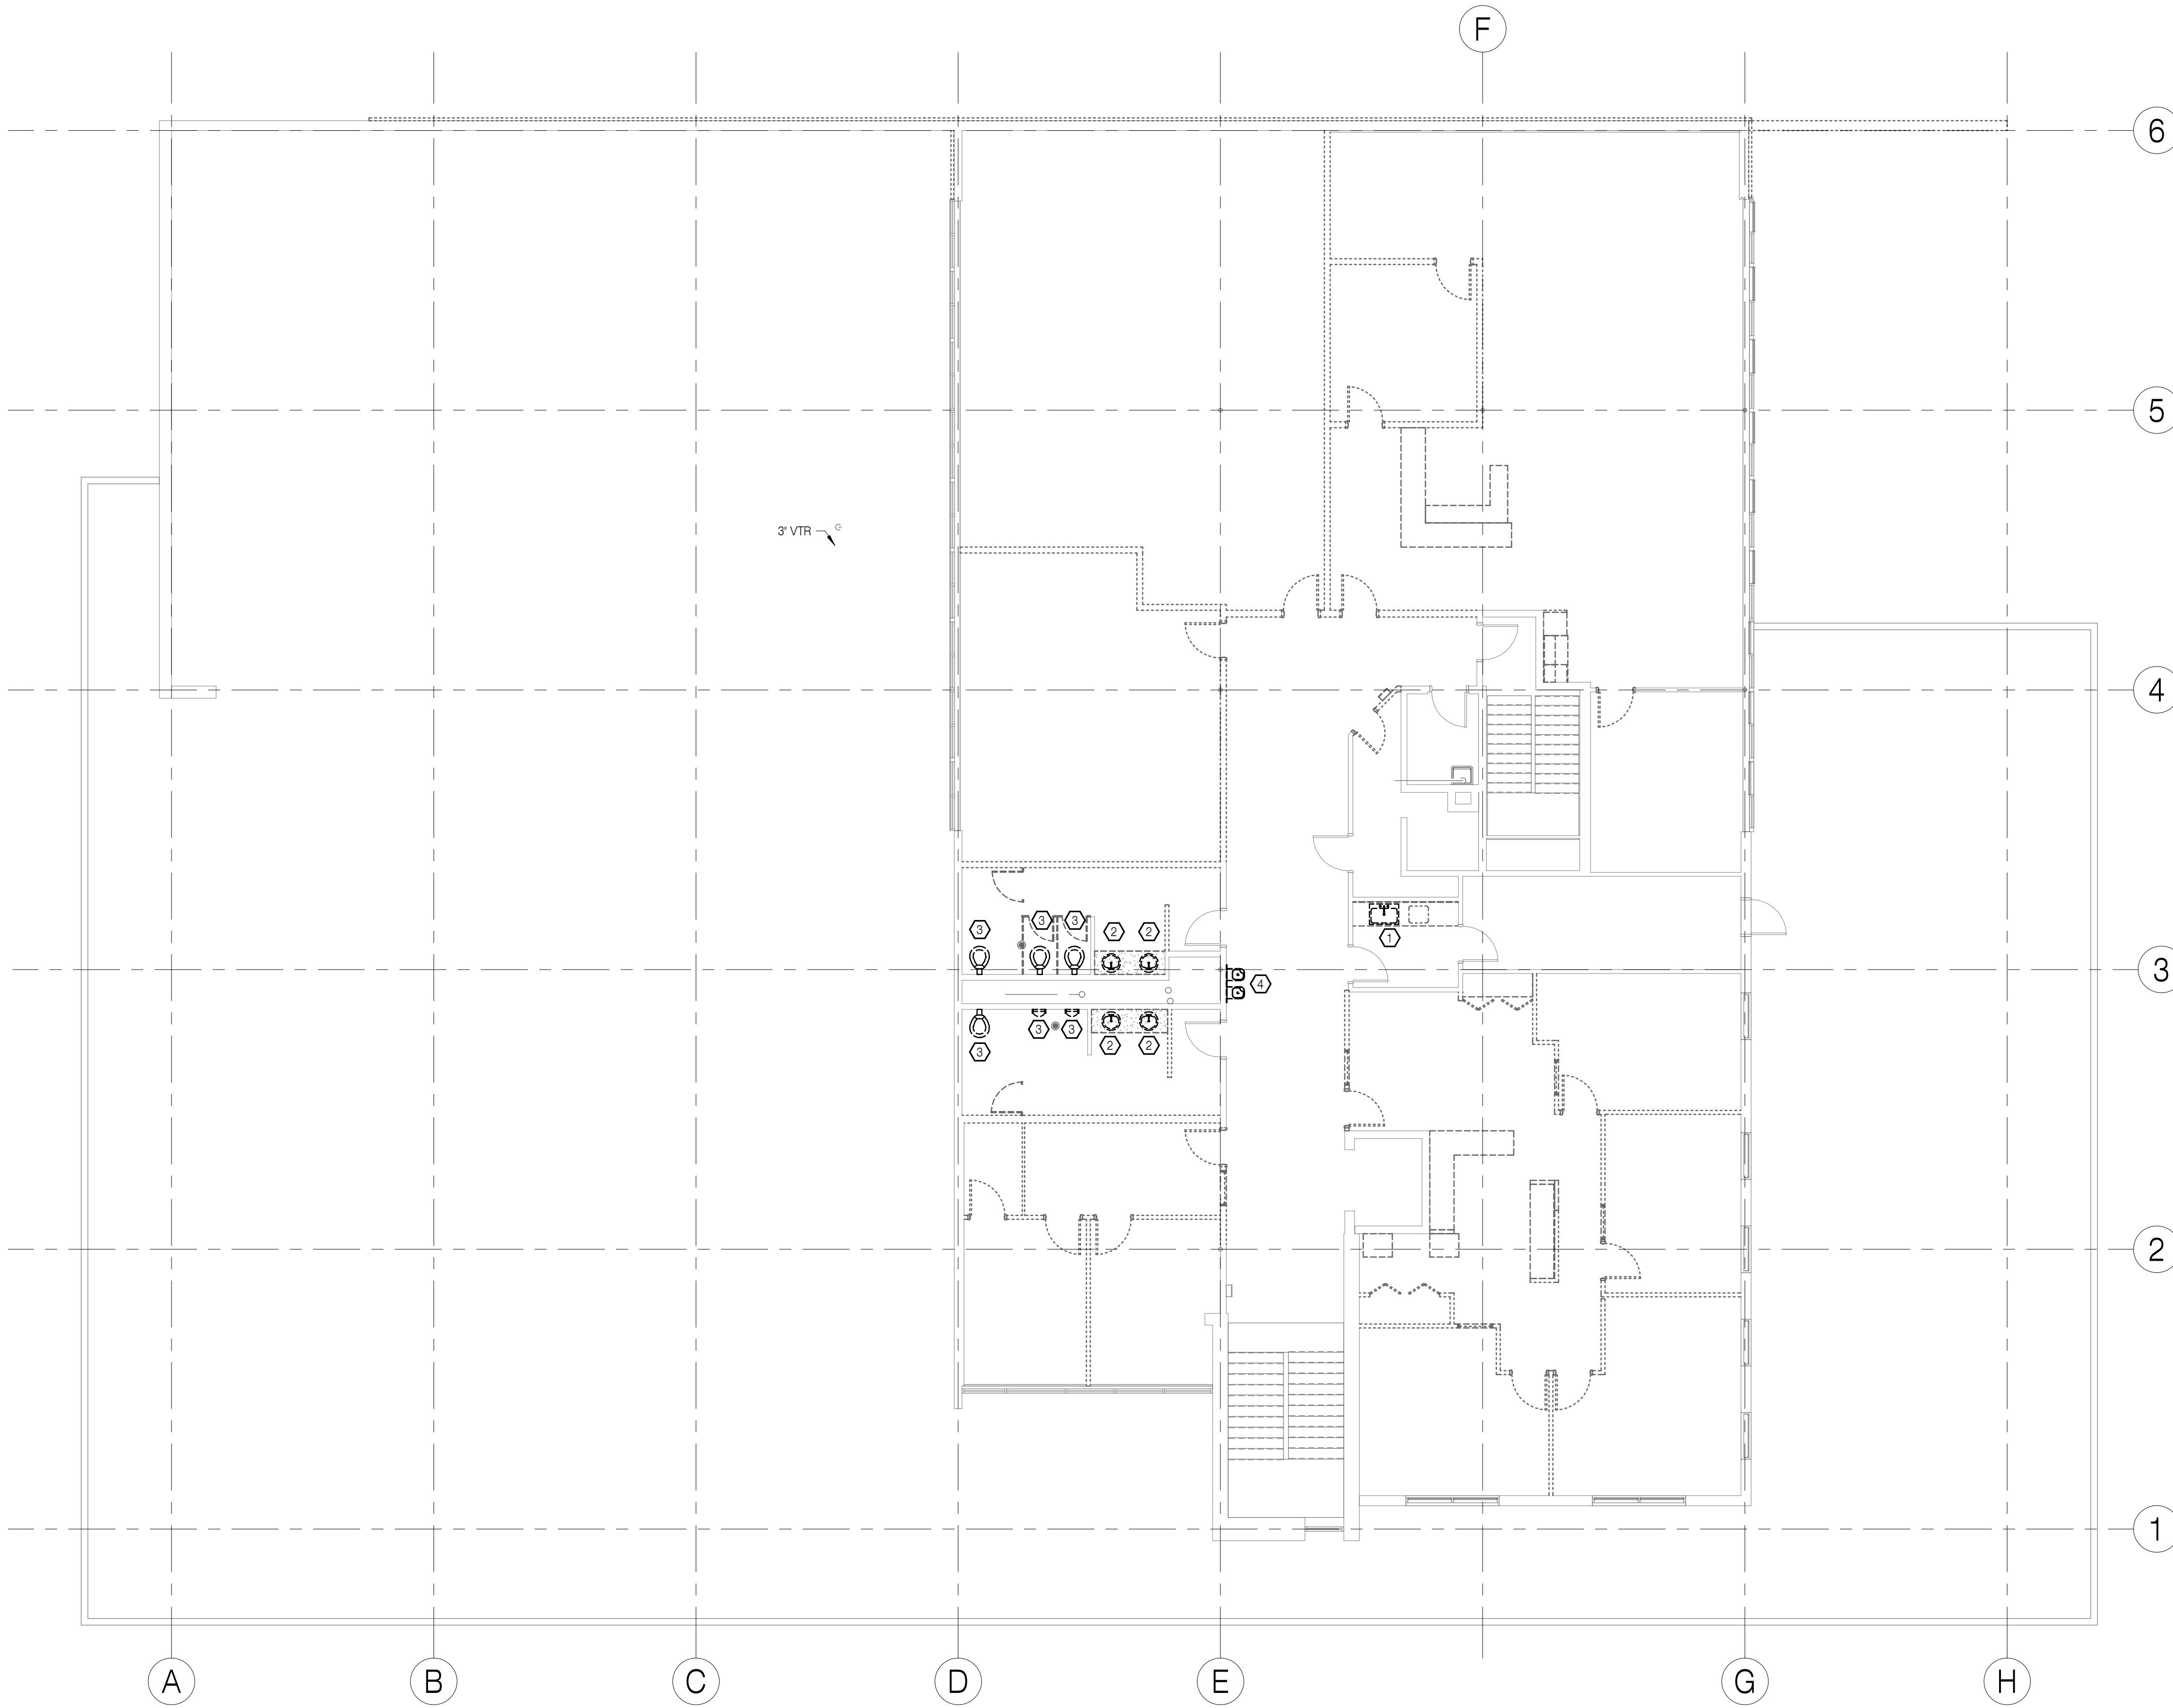

- REFERENCE NOTES:
- ① DEMOLISH (E) SINK. RETAIN (E) CW, HW, V, & W PIPING FOR RECONNECTION.
 - ② DEMOLISH (E) LAVATORY. RETAIN (E) CW, HW, V, & W PIPING FOR RECONNECTION.
 - ③ UNINSTALL (E) FIXTURE & RETAIN FOR REINSTALLATION. RETAIN (E) CW, V, & W PIPING FOR RECONNECTION.
 - ④ DEMOLISH (E) DRINKING FOUNTAIN. RETAIN (E) CW, V & W PIPING FOR RECONNECTION.

RECORD DRAWING
 NOTE: Documents have been corrected as per data supplied by Contractor and Revision / Change Order Drawings. They do not necessarily show all existing conditions and may not be completely accurate. Field verify existing / hidden conditions prior to commencement of new work.
 DATE: AUGUST 20, 2020

RECORD DRAWING
 20 AUGUST 2020

SW E
 SYSTEMS WEST ENGINEERS
 725 A Street
 Springfield, OR 97477
 541.342.7210
 systemswestengineers.com
 SWE Proj. No. U003.08

RECORD DRAWINGS
 HOMES FOR GOOD OFFICE BUILDING
 REMODEL
 100 WEST 10TH AVENUE
 EUGENE, OR 97401


SHEET TITLE:
PLUMBING DEMOLITION PLAN - SECOND FLOOR

REVISIONS:


#	DESCRP.	DATE

ISSUE DATE: 08/20/2020

P103

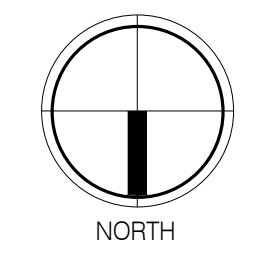

1 PLUMBING DEMOLITION PLAN - SECOND FLOOR
 1/8" = 1'-0"

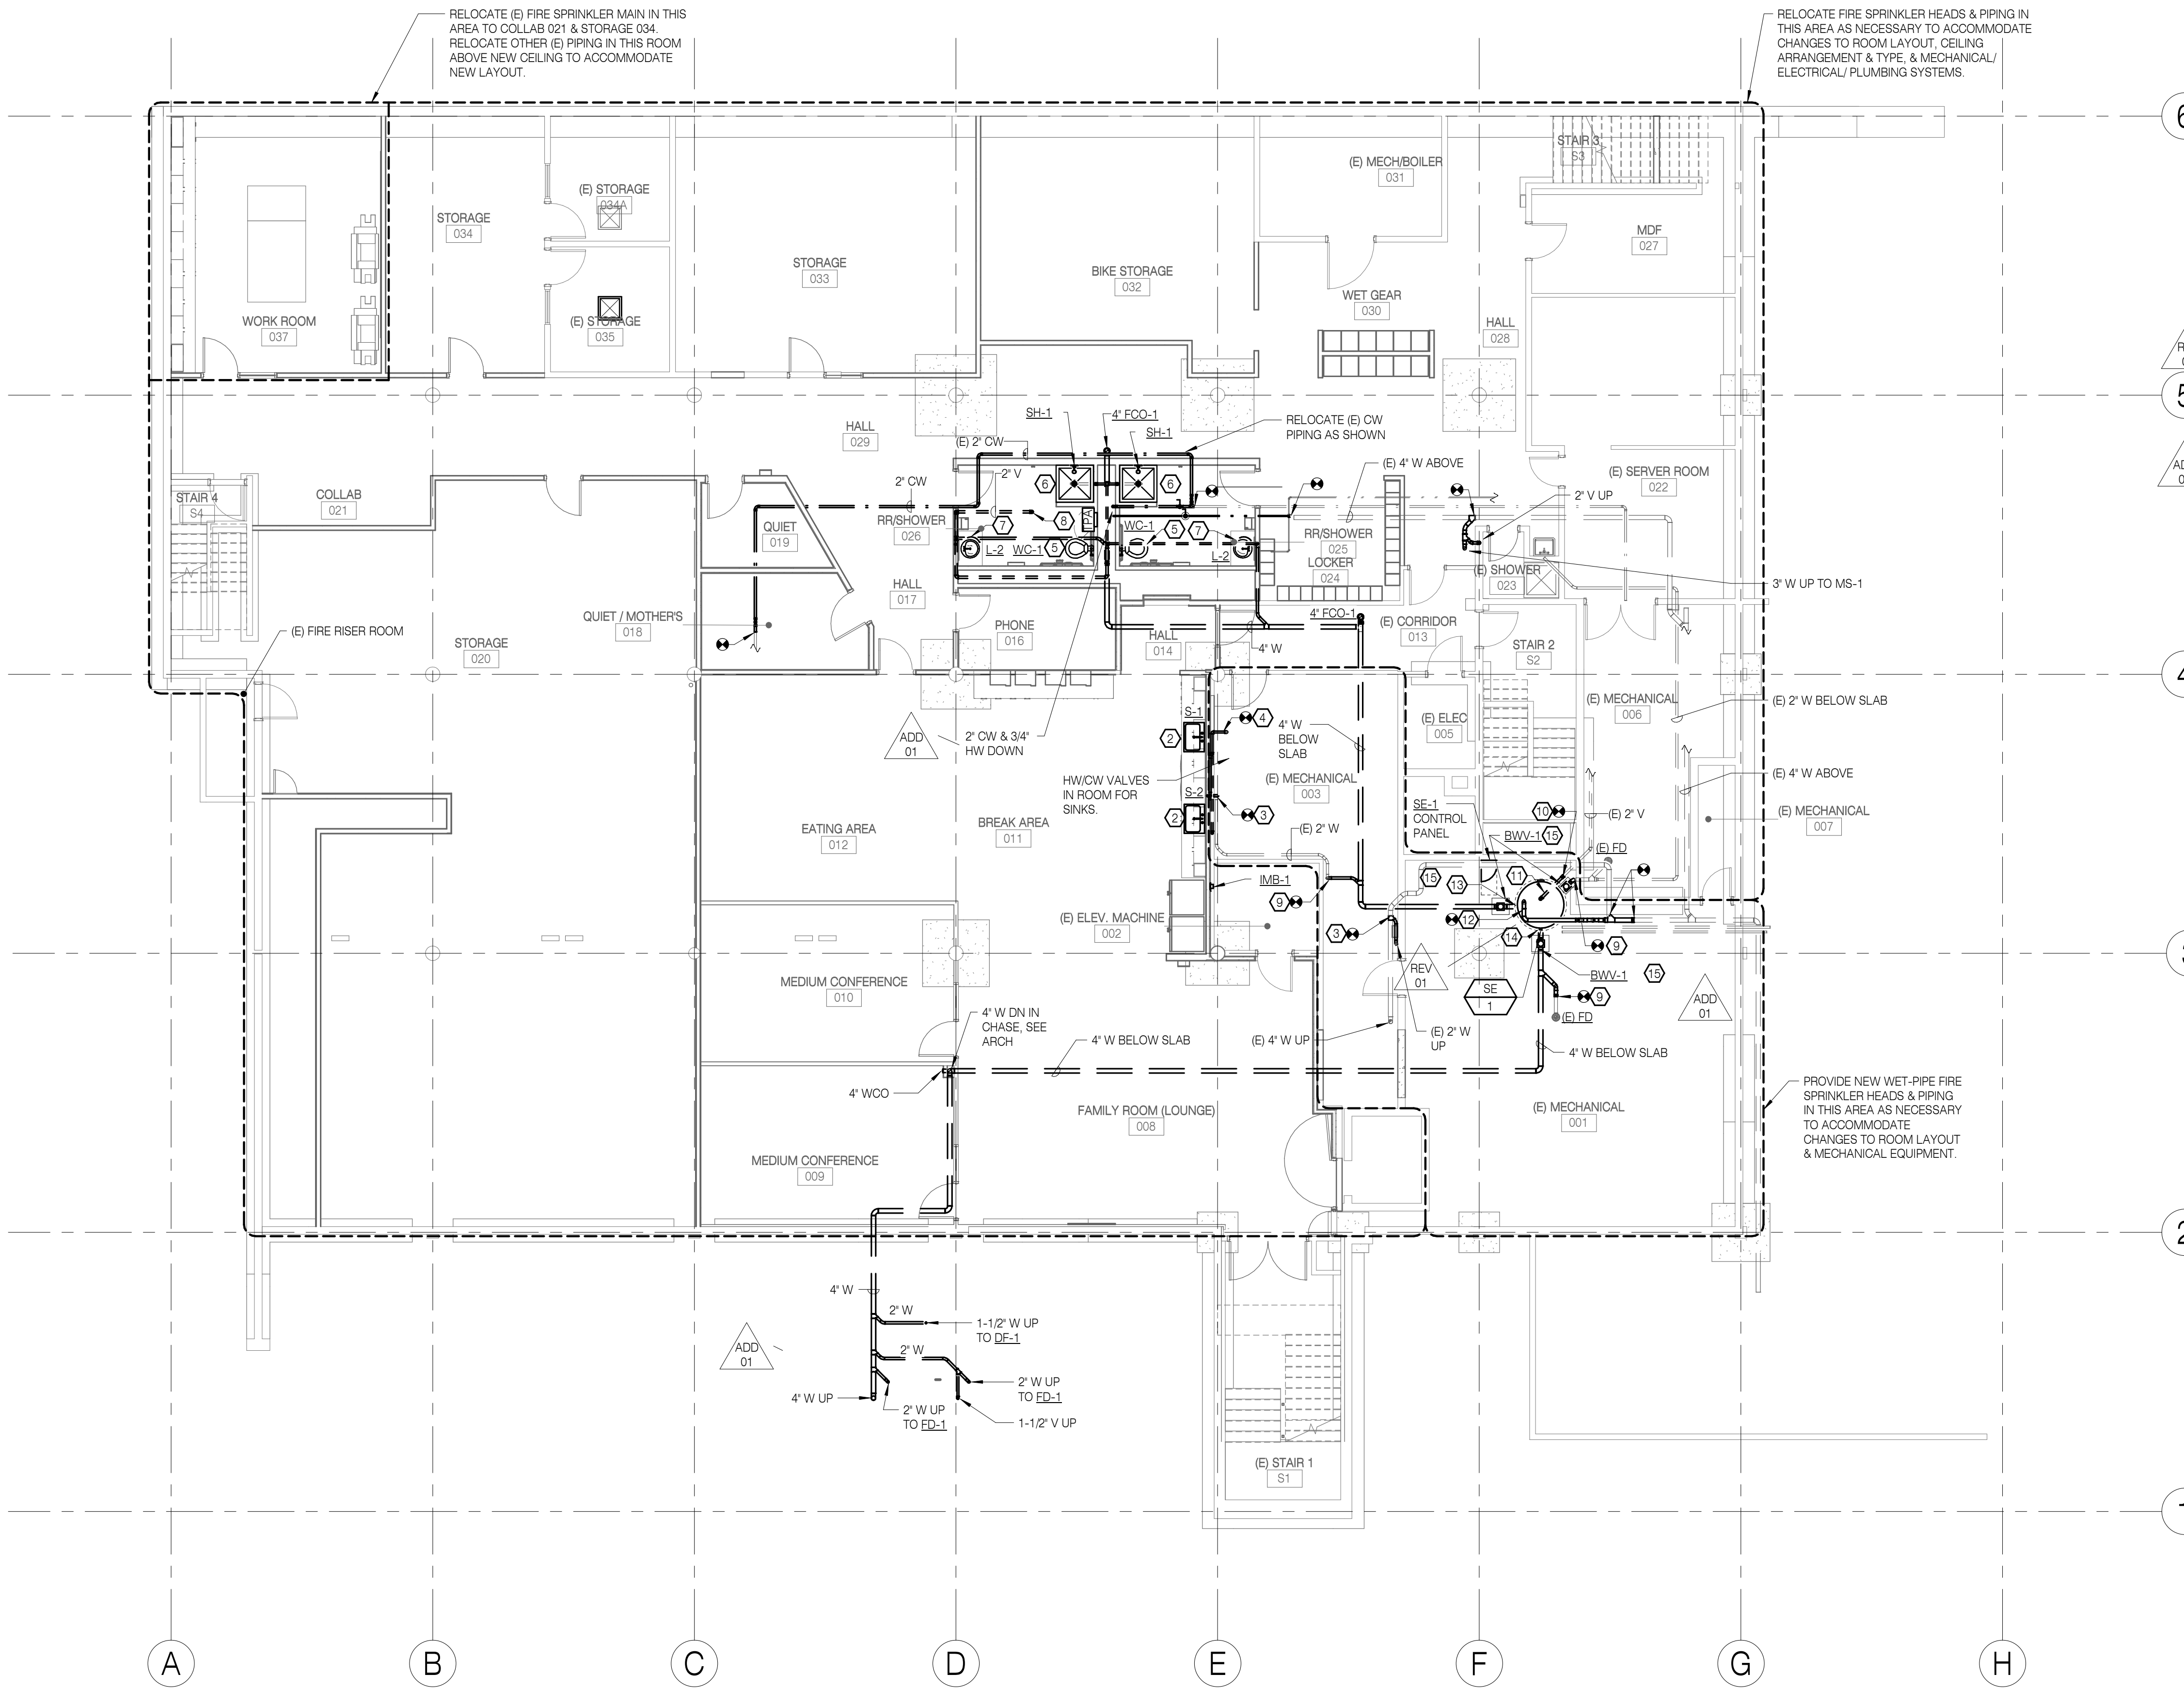

- REFERENCE NOTES:
- ① NEW 4" W BELOW GRADE, CONNECT TO (E).
 - ② NEW SINK. EXTEND (E) CW & HW PIPING IN WALL & CONNECT. NEW 1 1/2" V & 2" W CONNECTIONS. PROVIDE DISHWASHER DRAIN CONNECTION AT SINK TAILPIECE.
 - ③ NEW 2" W CONNECT TO (E) ABOVE SLAB ON WALL.
 - ④ NEW 1 1/2" V, CONNECT TO (E) ABOVE.
 - ⑤ NEW WATER CLOSET.
 - ⑥ NEW SHOWER.
 - ⑦ NEW LAVATORY.
 - ⑧ 2" V UP TO FIRST FLOOR. CONNECT TO (E) V IN RESTROOM CHASE ABOVE.
 - ⑨ NEW 3" W. CONNECT TO (E) BELOW SLAB.
 - ⑩ NEW 2" V. CONNECT TO (E) ABOVE.
 - ⑪ 2" V DOWN. CONNECT TO NEW SEWAGE EJECTOR PUMP.
 - ⑫ NEW 3" PUMPED W. CONNECT TO (E) WITH TOP CONNECTION IN YO WYE PER 710.4 2017 OPSC.
 - ⑬ I.E. = 2.63 BELOW LOWER LEVEL FFE.
 - ⑭ I.E. = 2.46 BELOW LOWER LEVEL FFE.
 - ⑮ PROVIDE BACKWATER VALVE IN FOUNDATION DRAIN PIPING CONNECTION TO SANITARY WASTE.
- REV 01
- 5
- ADD 01

RECORD DRAWING

NOTE: Documents have been corrected as per data supplied by Contractor and Revision / Change Order Drawings. They do not necessarily show all existing conditions and may not be completely accurate. Field verify existing / hidden conditions prior to commencement of new work.

DATE: AUGUST 20, 2020

PIVOT
ARCHITECTURE

RECORD DRAWING
20 AUGUST 2020

SW E
SYSTEMS WEST ENGINEERS
725 A Street
Springfield, OR 97477
541.342.7210
systemswestengineers.com
SWE Proj. No. U003.08

RECORD DRAWINGS
HOMES FOR GOOD OFFICE BUILDING
REMODEL
100 WEST 30TH AVENUE
EUGENE, OR 97401


SHEET TITLE:
PLUMBING PLAN - LOWER LEVEL

REVISIONS:


#	DESCRP.	DATE
1	ADD 01	05.17.19
2	REV 01	06.14.19

ISSUE DATE: 08/20/2020

P111

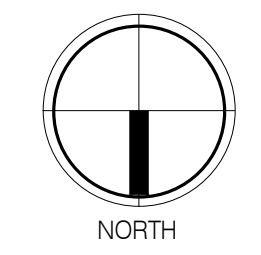

1 FOUNDATION PLUMBING FLOOR PLAN
1/8" = 1'-0"

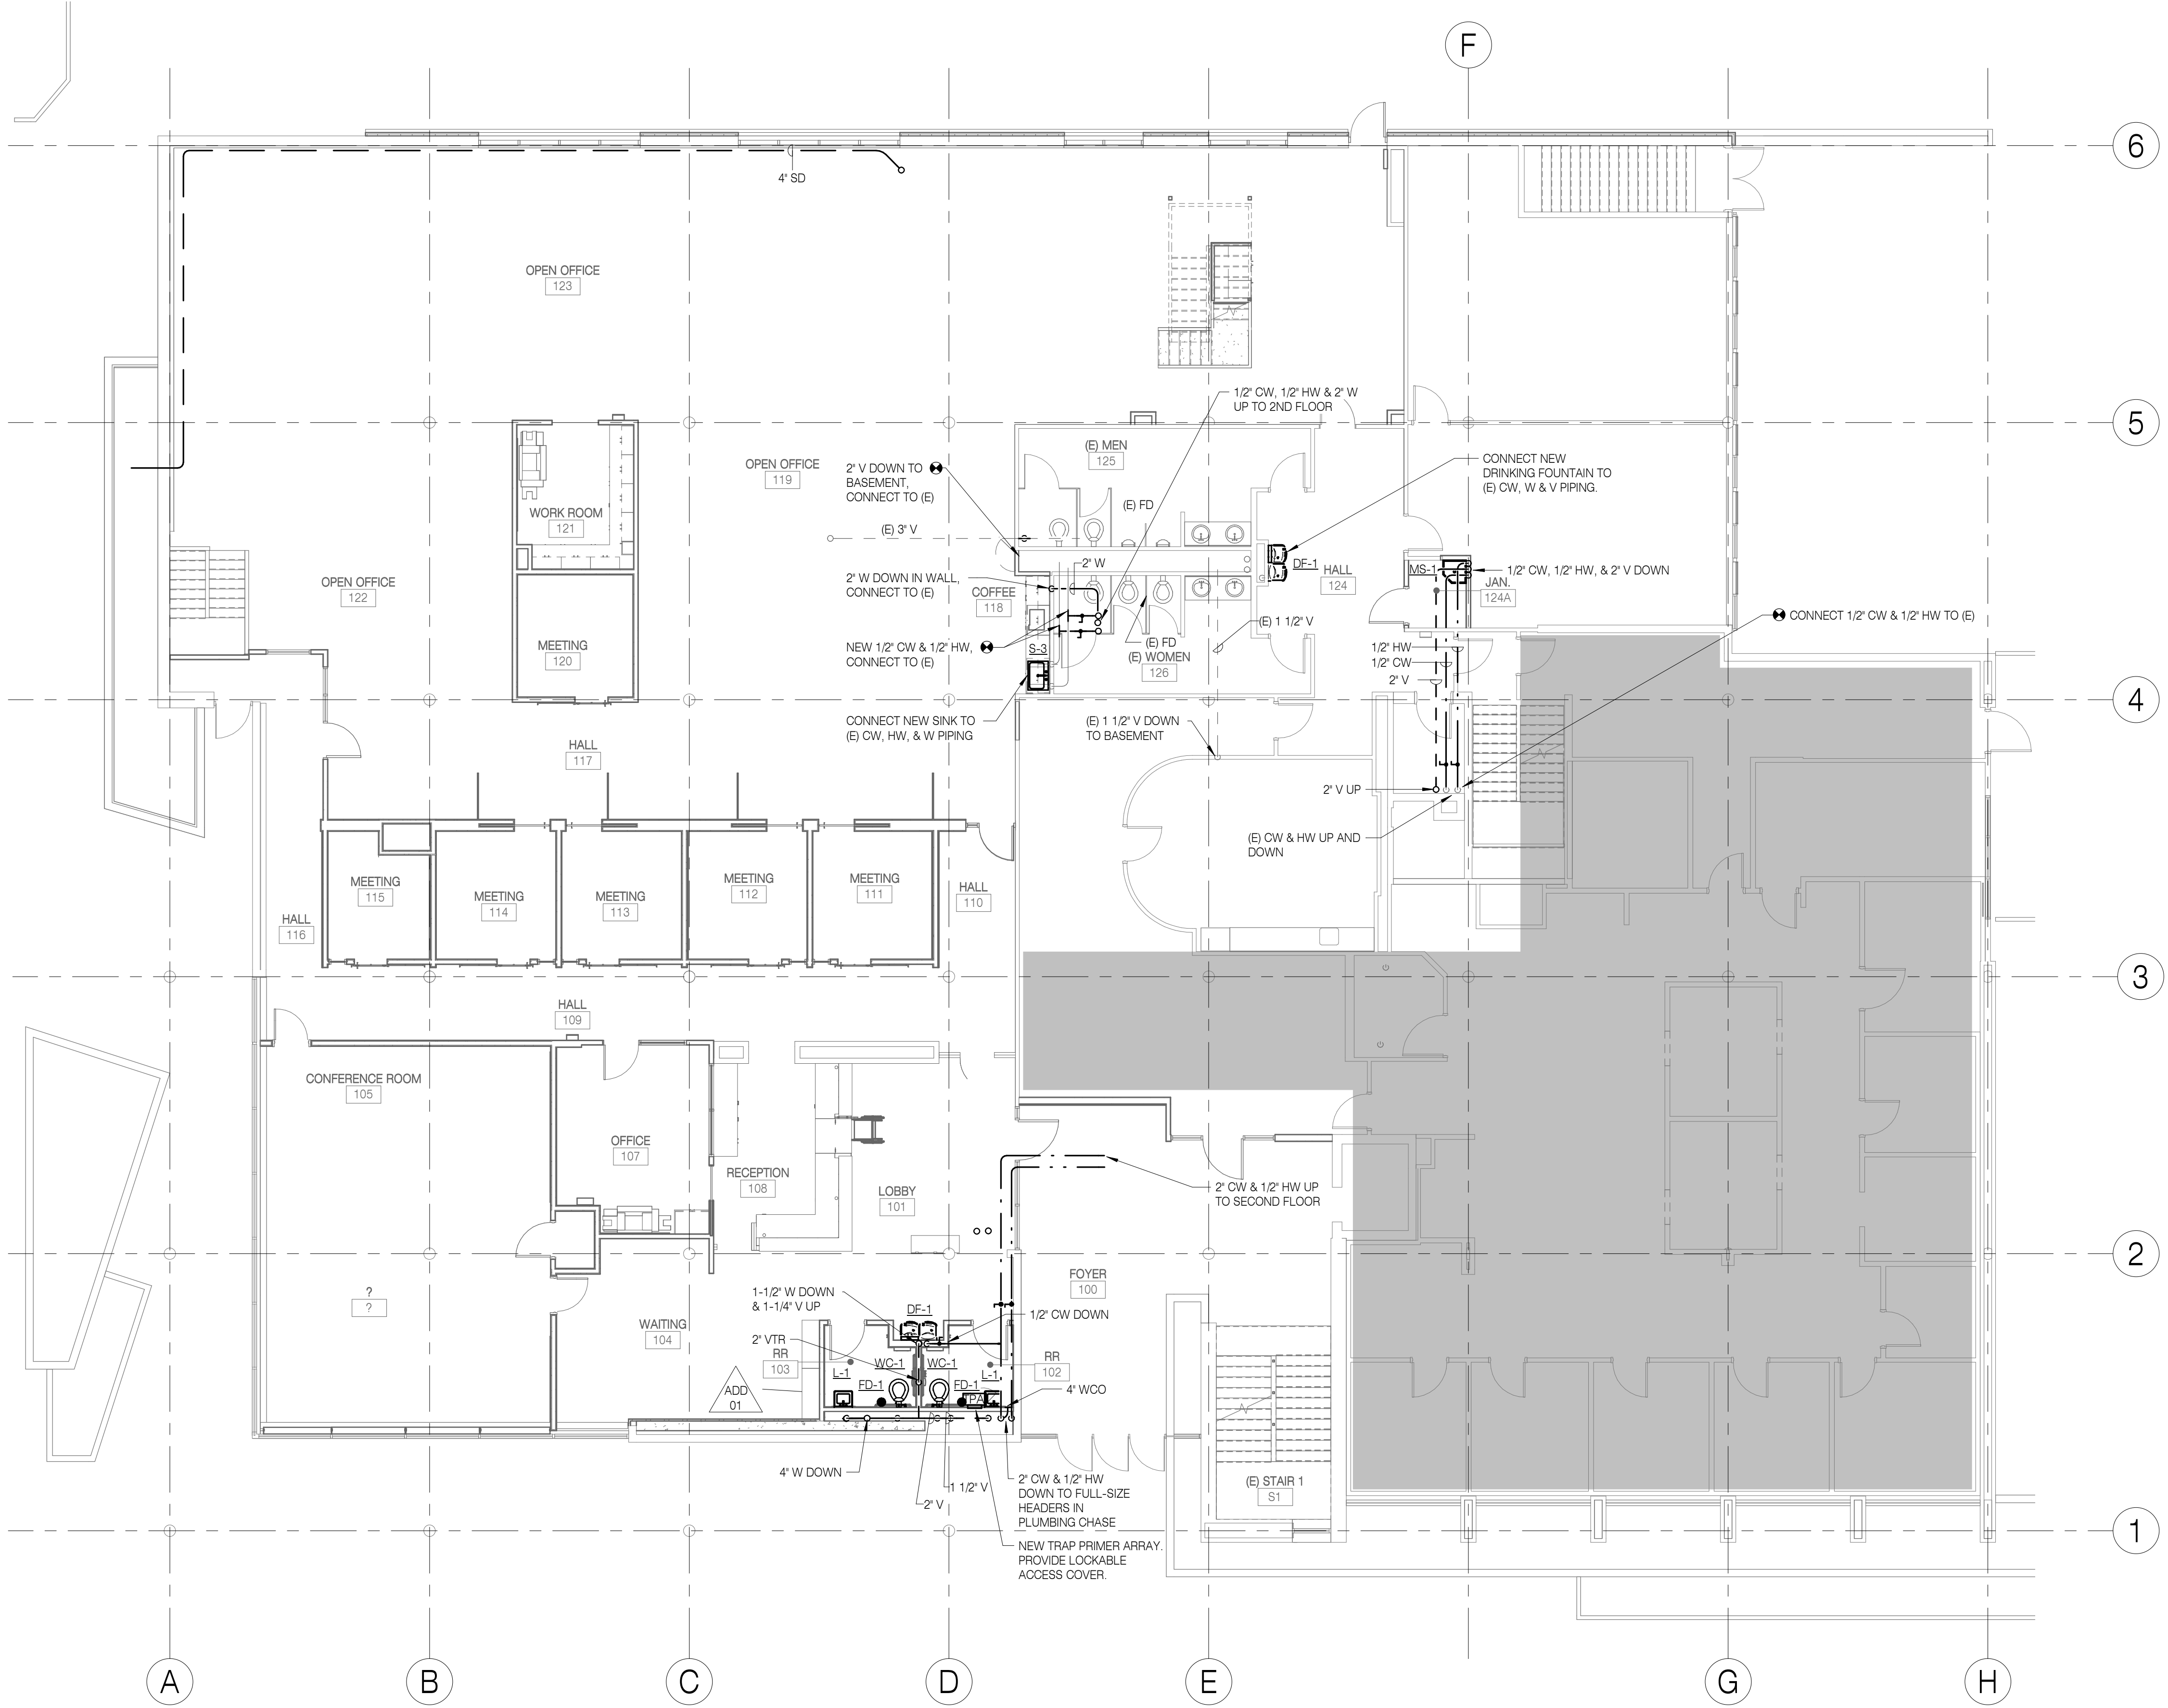

1 FIRST FLOOR PLUMBING FLOOR PLAN
1/8" = 1'-0"

RECORD DRAWING
NOTE: Documents have been corrected as per data supplied by Contractor and Revision / Change Order Drawings. They do not necessarily show all existing conditions and may not be completely accurate. Field verify existing / hidden conditions prior to commencement of new work.
DATE: AUGUST 20, 2020

SHEET TITLE:
PLUMBING PLAN - FIRST FLOOR

REVISIONS:

#	DESCRIP.	DATE
1	ADD 01	05.17.19

ISSUE DATE: 08/20/2020



- REFERENCE NOTES:
- NEW LAVATORY. CONNECT TO (E) CW, HW, V, & W PIPING.
 - REINSTALL (E) URINAL. CONNECT TO (E) CW, V & W PIPING. REFER TO ARCHITECTURAL DRAWINGS FOR MOUNTING HEIGHT.
 - REINSTALL (E) WATER CLOSET. CONNECT TO (E) CW, V & W PIPING. REFER TO ARCHITECTURAL DRAWINGS FOR MOUNTING HEIGHT.


RECORD DRAWING
NOTE: Documents have been corrected as per data supplied by Contractor and Revision / Change Order Drawings. They do not necessarily show all existing conditions and may not be completely accurate. Field verify existing / hidden conditions prior to commencement of new work.
DATE: AUGUST 20, 2020

RECORD DRAWINGS
HOMES FOR GOOD OFFICE BUILDING
REMODEL
100 WEST 10TH AVENUE
EUGENE, OR 97401


SHEET TITLE:
PLUMBING PLAN - SECOND FLOOR

REVISIONS:


#	DESCRP.	DATE

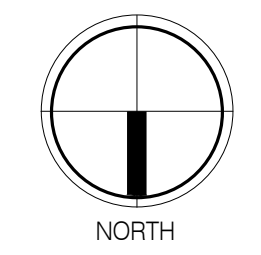

1 SECOND FLOOR PLUMBING FLOOR PLAN
1/8" = 1'-0"

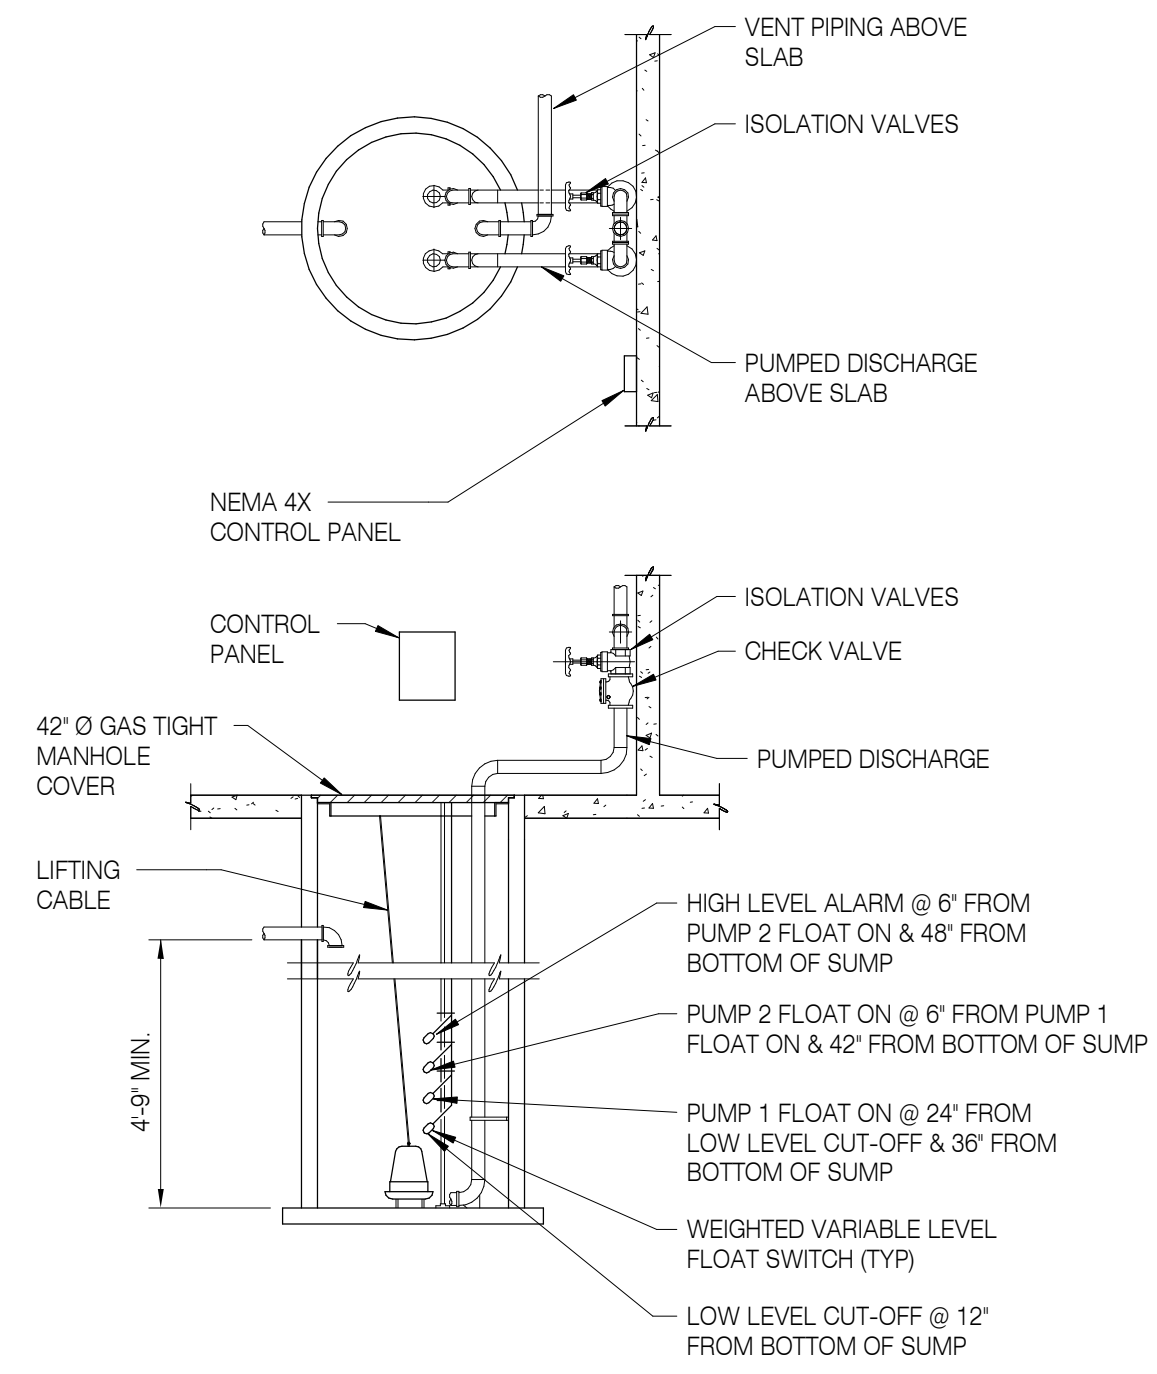

1 SEWAGE EJECTOR INSTALLATION DETAIL
NOT TO SCALE

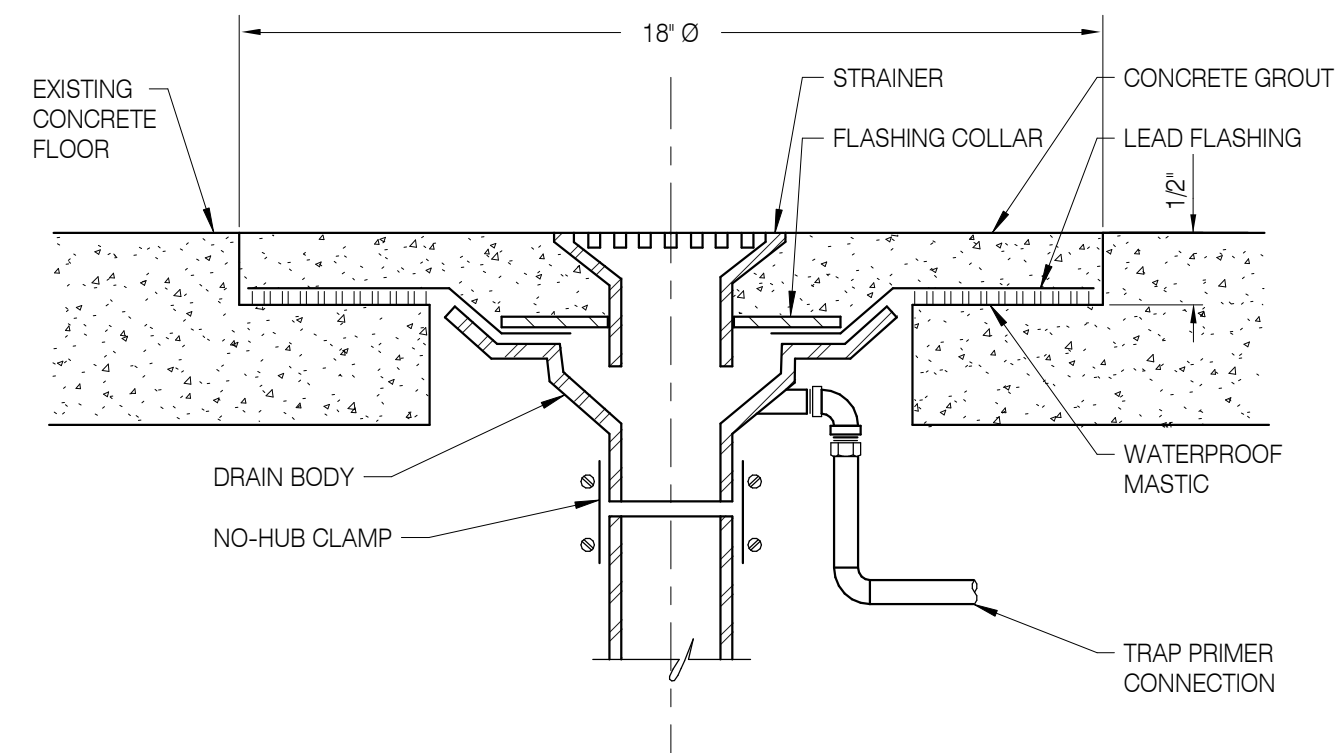

2 SHOWER DRAIN (SD-1) & FLOOR DRAIN (FD-1)
NOT TO SCALE

RECORD DRAWING
NOTE: Documents have been corrected as per data supplied by Contractor and Revision / Change Order Drawings. They do not necessarily show all existing conditions and may not be completely accurate. Field verify existing / hidden conditions prior to commencement of new work.
DATE: AUGUST 20, 2020

DOMESTIC - PUMP

TAG	MANUFACTURER	MODEL	SERVICE	TYPE	FLOW (GPM)	TOTAL HEAD (FT)	BHP	MOTOR				MOTOR CONTROL (1)(2)	REMARKS
								VOLTS	PHASE	RPM	HP		
SE-1	WEIL	2515	SEWAGE	DUPEX SUBMERSIBLE PUMP	50	18	0.8	208	3	1750	1.5	MS	SINGLE POINT CONNECTION CONTROL PANEL WITH TWO 1.5 HORSEPOWER PUMPS

- (1) MOTOR CONTROL FURNISHED BY DIV. 23
 (2) MS: MOTOR STARTER, VFD: VARIABLE FREQUENCY DRIVE, ECM: ECM MOTOR CONTROLLER, CR: CONTROL RELAY

PLUMBING SPECIALTIES

TAG	DESCRIPTION	VOLTS	PHASE	FLA	MCA	MOP
DF-1	DRINKING FOUNTAIN WITH BOTTLE FILLER	120	1	1	-	-
S-1	INSINKERATOR HOT WATER DISPENSER AT SINK - 750 WATT	120	1	6.25	-	-
TPA	TRAP PRIMER ARRAY	120	1	1	-	-

DOMESTIC WATER DESIGN CRITERIA

BASIS OF DESIGN: 2017 OREGON PLUMBING SPECIALTY CODE, APPENDIX A 'RECOMMENDED RULES FOR SIZING THE WATER SUPPLY SYSTEM'. PIPING SIZED ON 4 PSI/100 FT. DROP UNLESS OTHERWISE NOTED. VELOCITIES NOT TO EXCEED 8 FT./SEC. (COLD WATER) AND NOT TO EXCEED 5 FT./SEC. (HOT WATER). WATER PIPING SIZING ASSUMES TYPE L COPPER AS BASIS OF DESIGN.

SANITARY WASTE AND VENT DESIGN CRITERIA

BASIS OF DESIGN: 2017 OREGON PLUMBING SPECIALTY CODE, CHAPTER 7, 'SANITARY DRAINAGE' AND CHAPTER 9, 'VENTS.' ALL WASTE PIPING SLOPED AT 1/4-INCH/FT. UNLESS OTHERWISE NOTED. ALL VENT PIPING SLOPED UPWARDS AT 1/8-INCH/FT. UNLESS OTHERWISE NOTED.

STORM WATER DESIGN CRITERIA

BASIS OF DESIGN: 2017 OREGON PLUMBING SPECIALTY CODE, CHAPTER 11 - "STORM DRAINAGE"
 DESIGN RAINFALL RATE: 2-INCHES PER HOUR
 STORM DRAIN PIPING SLOPE: 1/8-INCH/FT. UNLESS OTHERWISE NOTED

PLUMBING CONNECTIONS

TAG	FIXTURE	PIPE CONNECTIONS (IN)				REMARKS
		W	V	CW	HW	
DF-1	DRINKING FOUNTAIN	1-1/2	1-1/4	1/2	-	
FD-1	FLOOR DRAIN	2	-	-	-	
IMB-1	ICEMAKER BOX	-	-	1/2	-	
L-1	LAVATORY SINK	2	1-1/2	1/2	1/2	
MS-1	MOP SINK	3	2	1/2	1/2	
S-1	SINK	2	1-1/2	1/2	1/2	
S-2	SINK	2	1-1/2	1/2	1/2	
S-3	SINK	2	1-1/2	1/2	1/2	
SH-1	SHOWER	2	-	1/2	1/2	
WC-1	WATER CLOSET	4	2	1-1/4	-	

RECORD DRAWING

NOTE: Documents have been corrected as per data supplied by Contractor and Revision / Change Order Drawings. They do not necessarily show all existing conditions and may not be completely accurate. Field verify existing / hidden conditions prior to commencement of new work.
 DATE: AUGUST 20, 2020

RECORD DRAWING
20 AUGUST 2020



SYSTEMS WEST ENGINEERS
 725 A Street
 Springfield, OR 97477
 541.342.7210
 systemswestengineers.com
 SWE Proj. No. U003.08

RECORD DRAWINGS
HOMES FOR GOOD OFFICE BUILDING
 REMODEL
 100 WEST 10TH AVENUE
 EUGENE, OR 97401

SHEET TITLE:
PLUMBING SCHEDULES

REVISIONS:
 # DESCRP. DATE

ISSUE DATE: 08/20/2020

P601